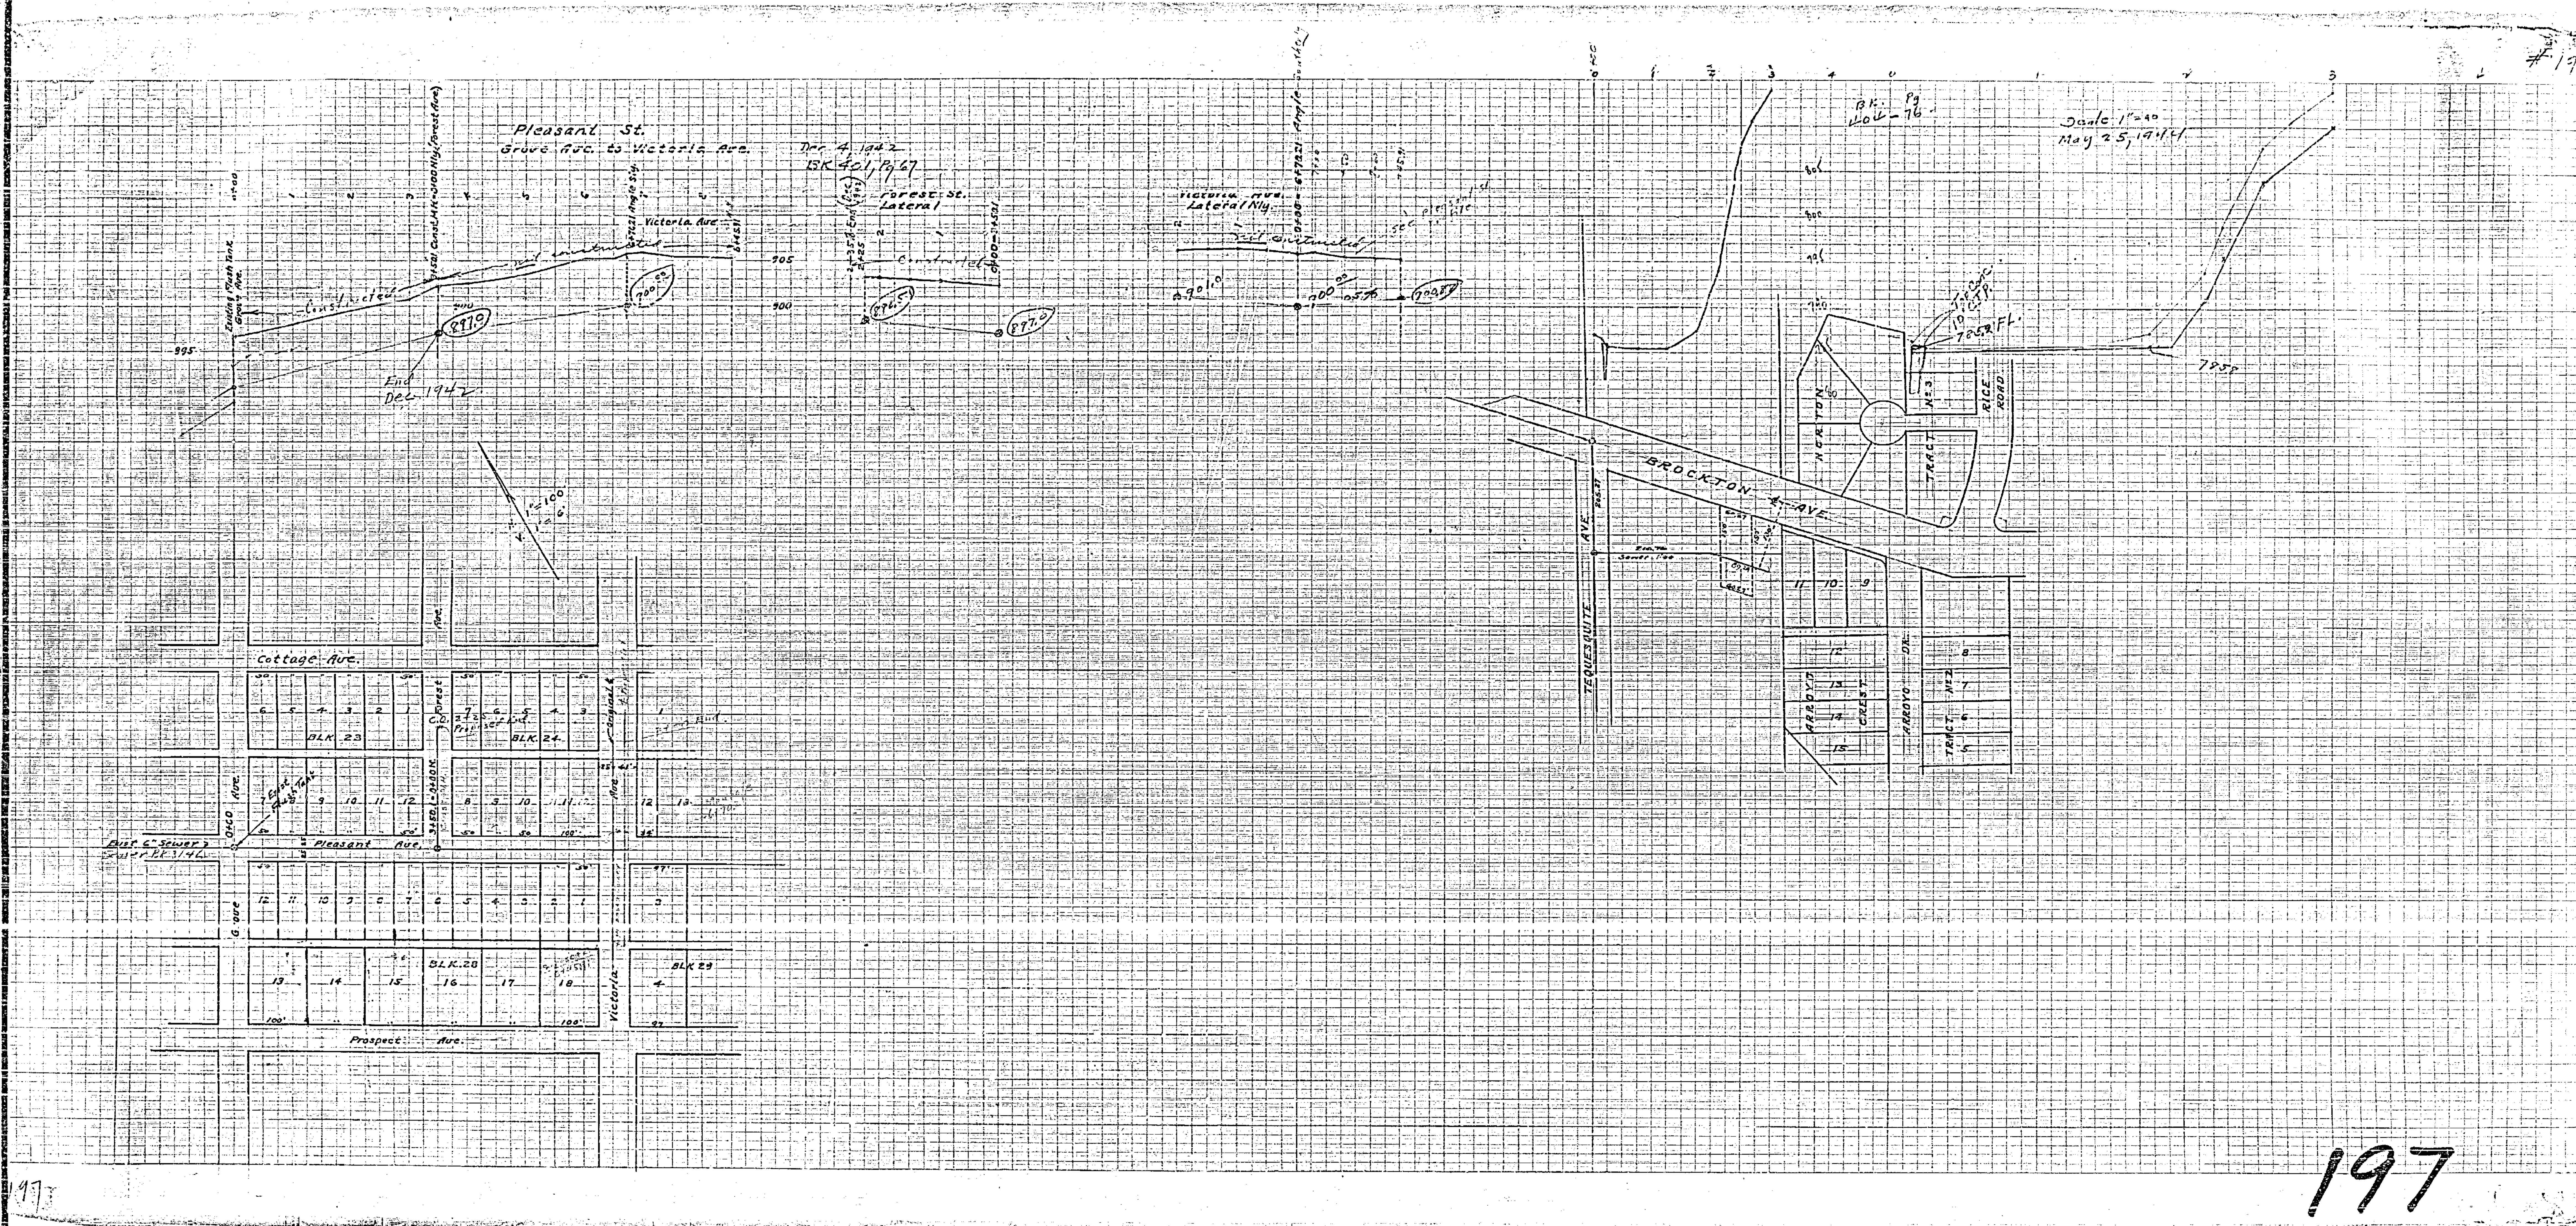

Pleasant St.
Grove Ave. to Victoria Ave.
Dec. 4, 1942
BK 401, Pg 67
Forest St. Lateral
Victoria Ave. Lateral Nly.
Victoria Ave
Existing Flush Tank Grove Ave.
Constructed
Not constructed
897.0
896.5
900.00
700.87
End Dec. 1942
BK. Pg
404 - 76
Scale 1"=40
May 25, 1944
785.8 FL.
785.8
Cottage Ave.
Pleasant Ave.
Prospect Ave.
Grove Ave.
Forest
Victoria
BLK 23
BLK. 24
BLK. 28
BLK 29
Exist. 6" Sewer
Sewer BK 314L
BROCKTON AVE.
TEQUESQUITE AVE.
NORTON
TRACT No. 3
RICE ROAD
ARROYO
CREST
ARROYO DR.
TRACT No. 2

197