


202-B


BANDINI AVE - RIVERSIDE AVE. EASTERLY			
DRAWING NUMBER	SHEET NUMBER	TOTAL SHEETS	TOTAL FIELD BOOKS
202-B	1	1	249, 319
DRAWN BY	CHECKED BY	APPROVED BY	
WBM/ghf			

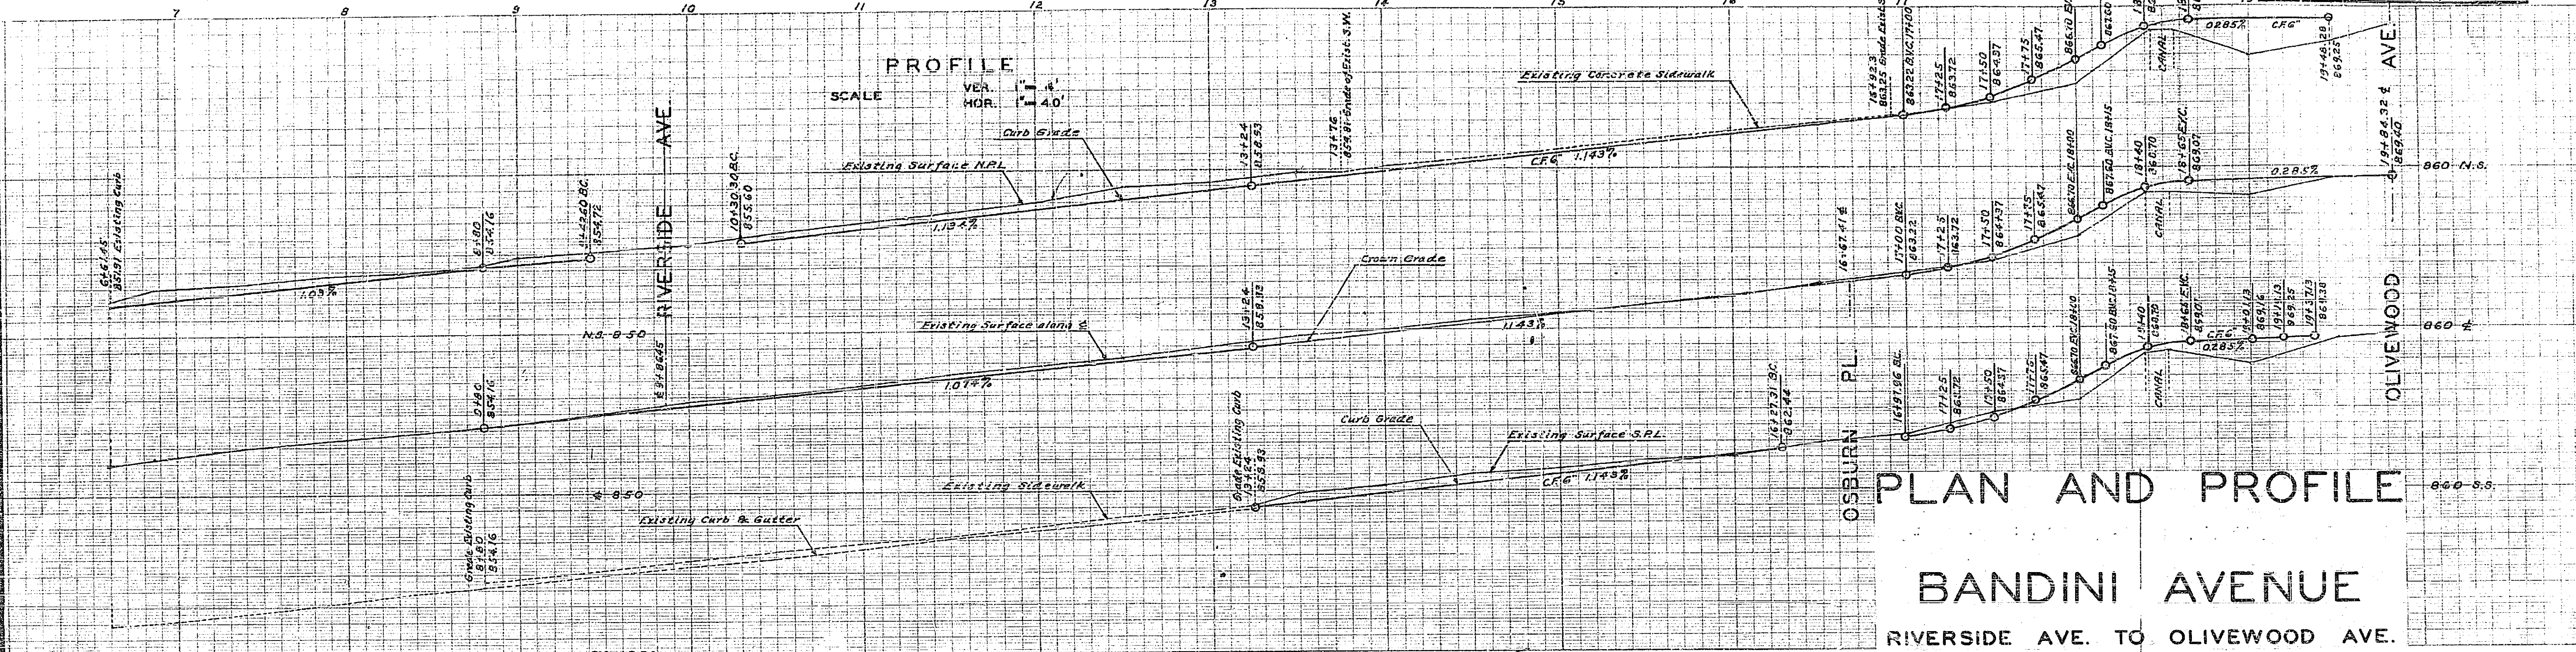


PLAN AND PROFILE
BANDINI AVENUE
 RIVERSIDE AVE. TO OLIVEWOOD AVE.

ENGINEERING DEPT. RIVERSIDE CALIF. 1940
 CITY (U.S.G.S.) DATUM PLANE
 FIELD BOOK 349 PAGES 62-69

APPROVED _____
 CITY ENGINEER. REG. ENG. 1312.

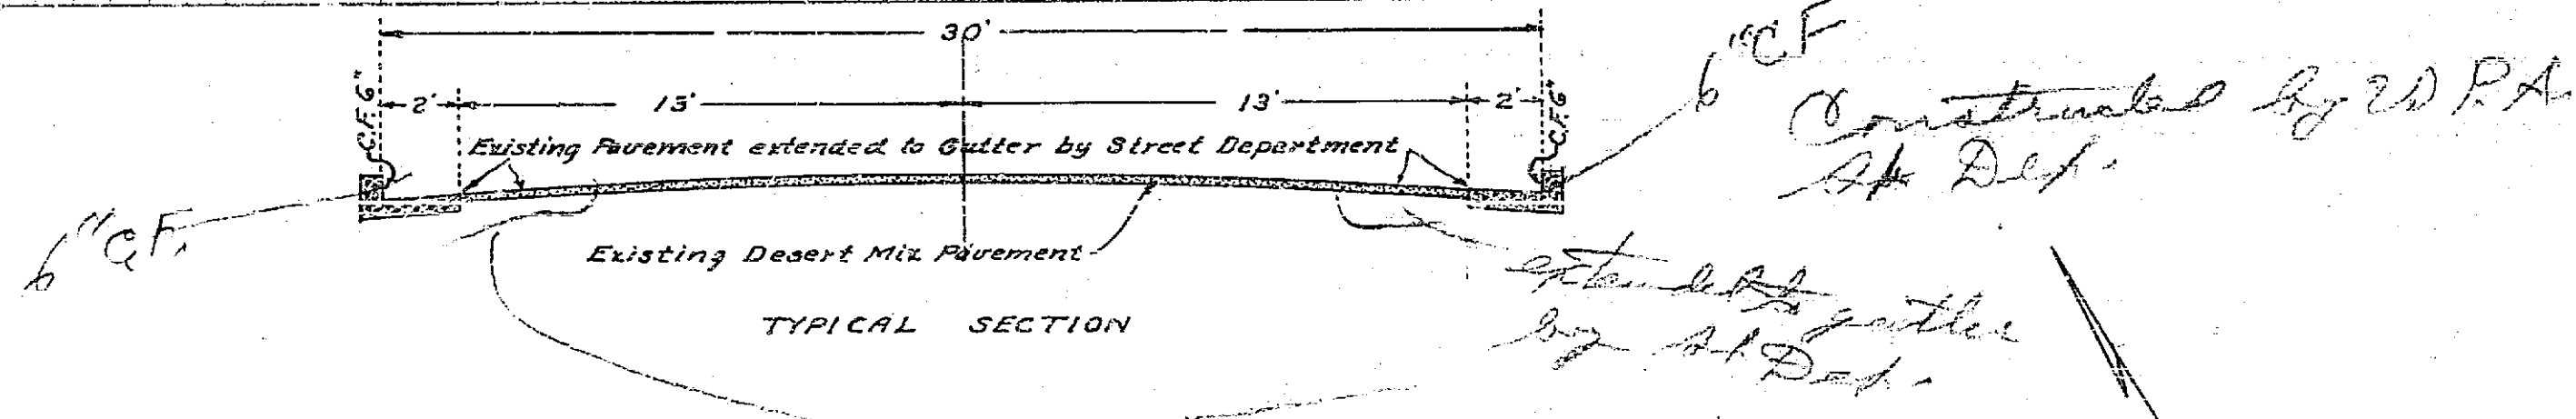

SCALE HOR. 1"=40'
 VER. 1"=4'

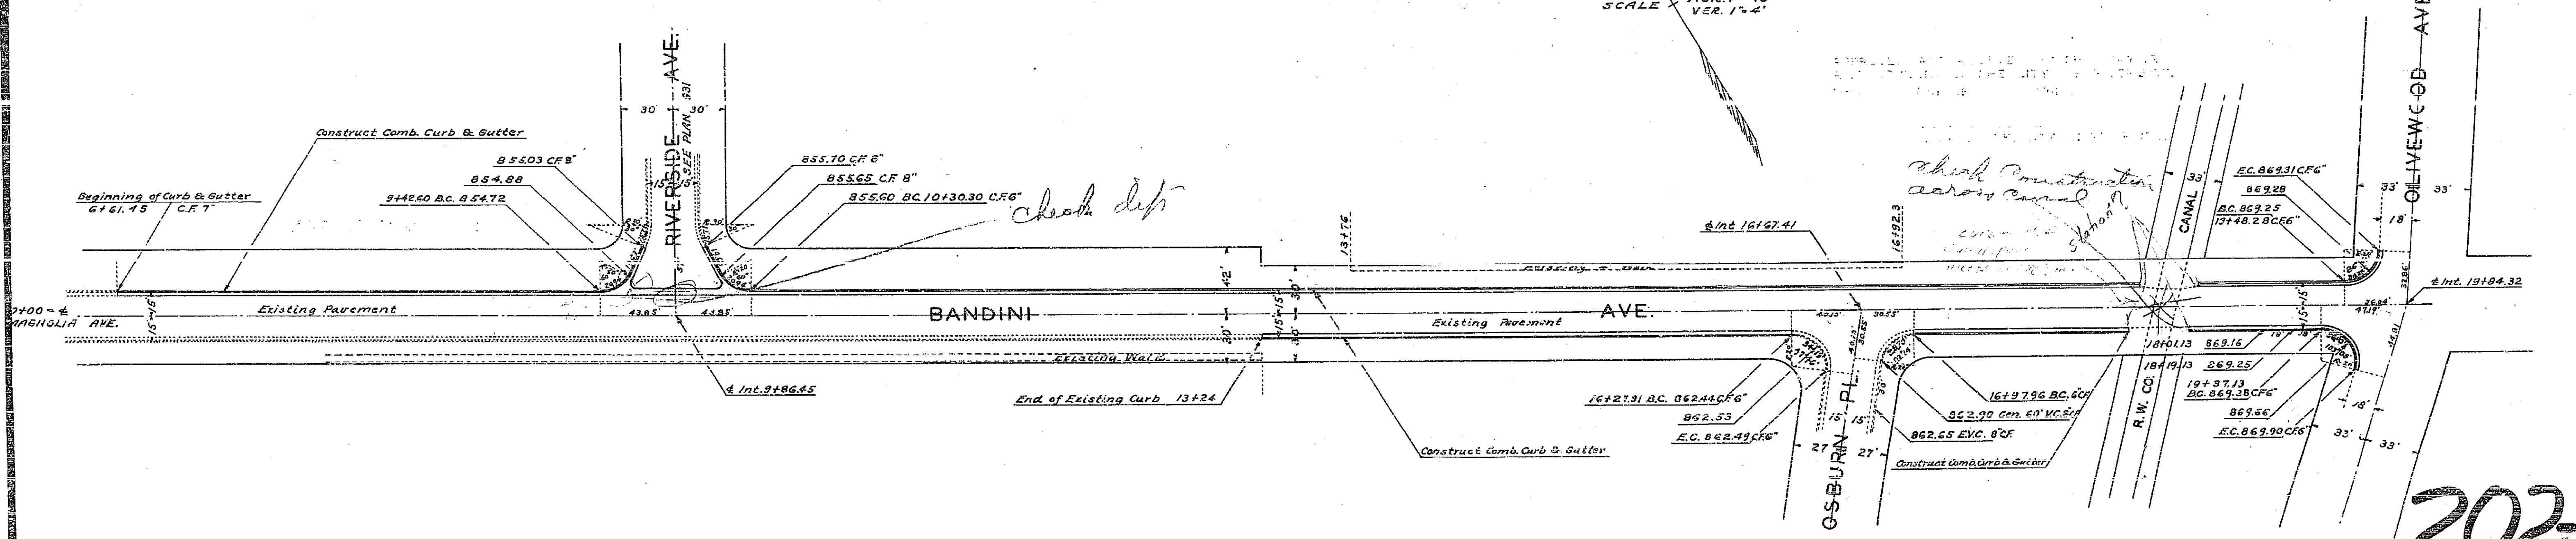

202-B