
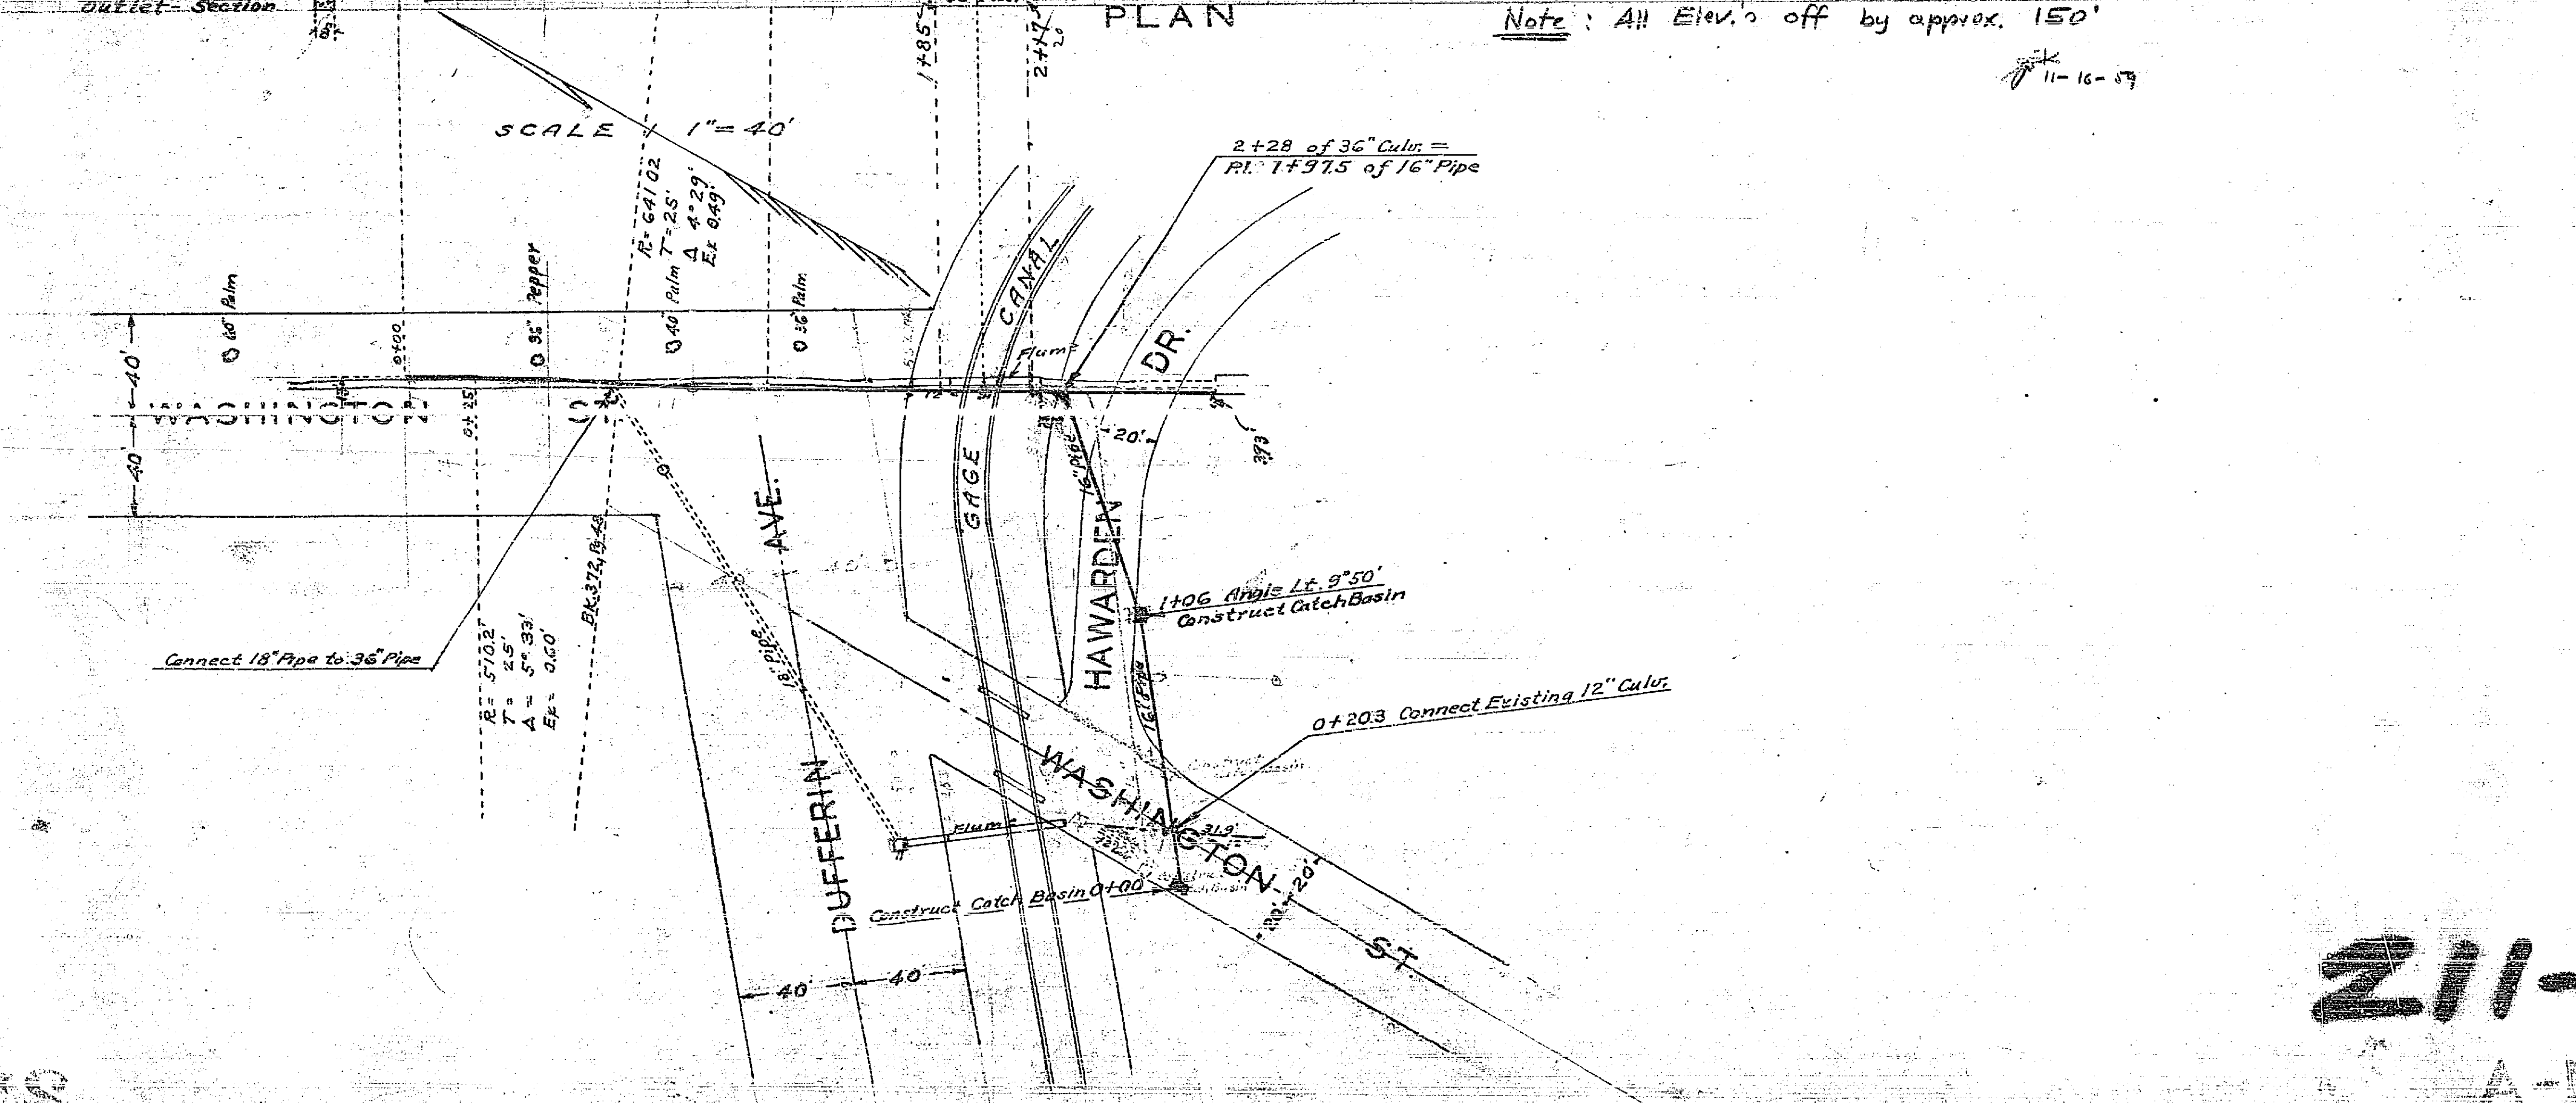


**PROFILE**

Book 367, Pg 61  
 " 372, " 48, 49  
 3-6-40

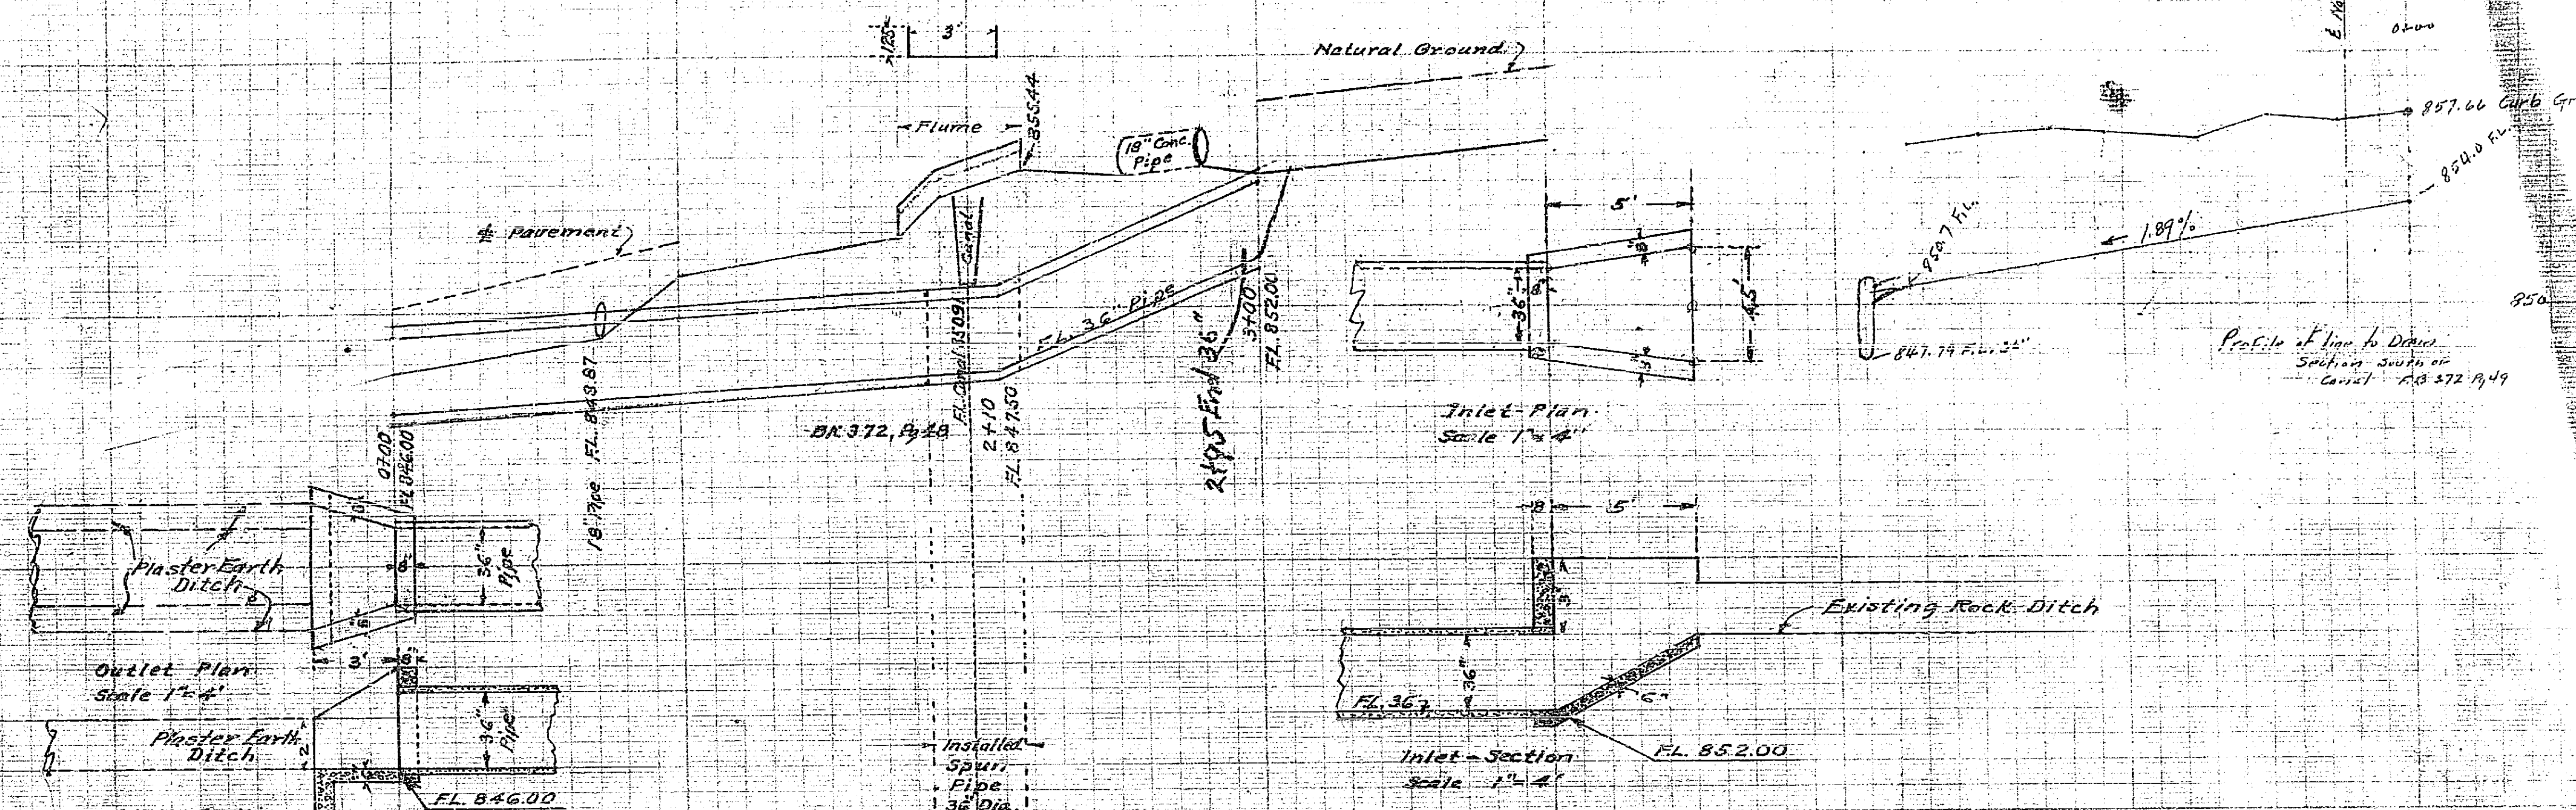

**211-A**