



521

231

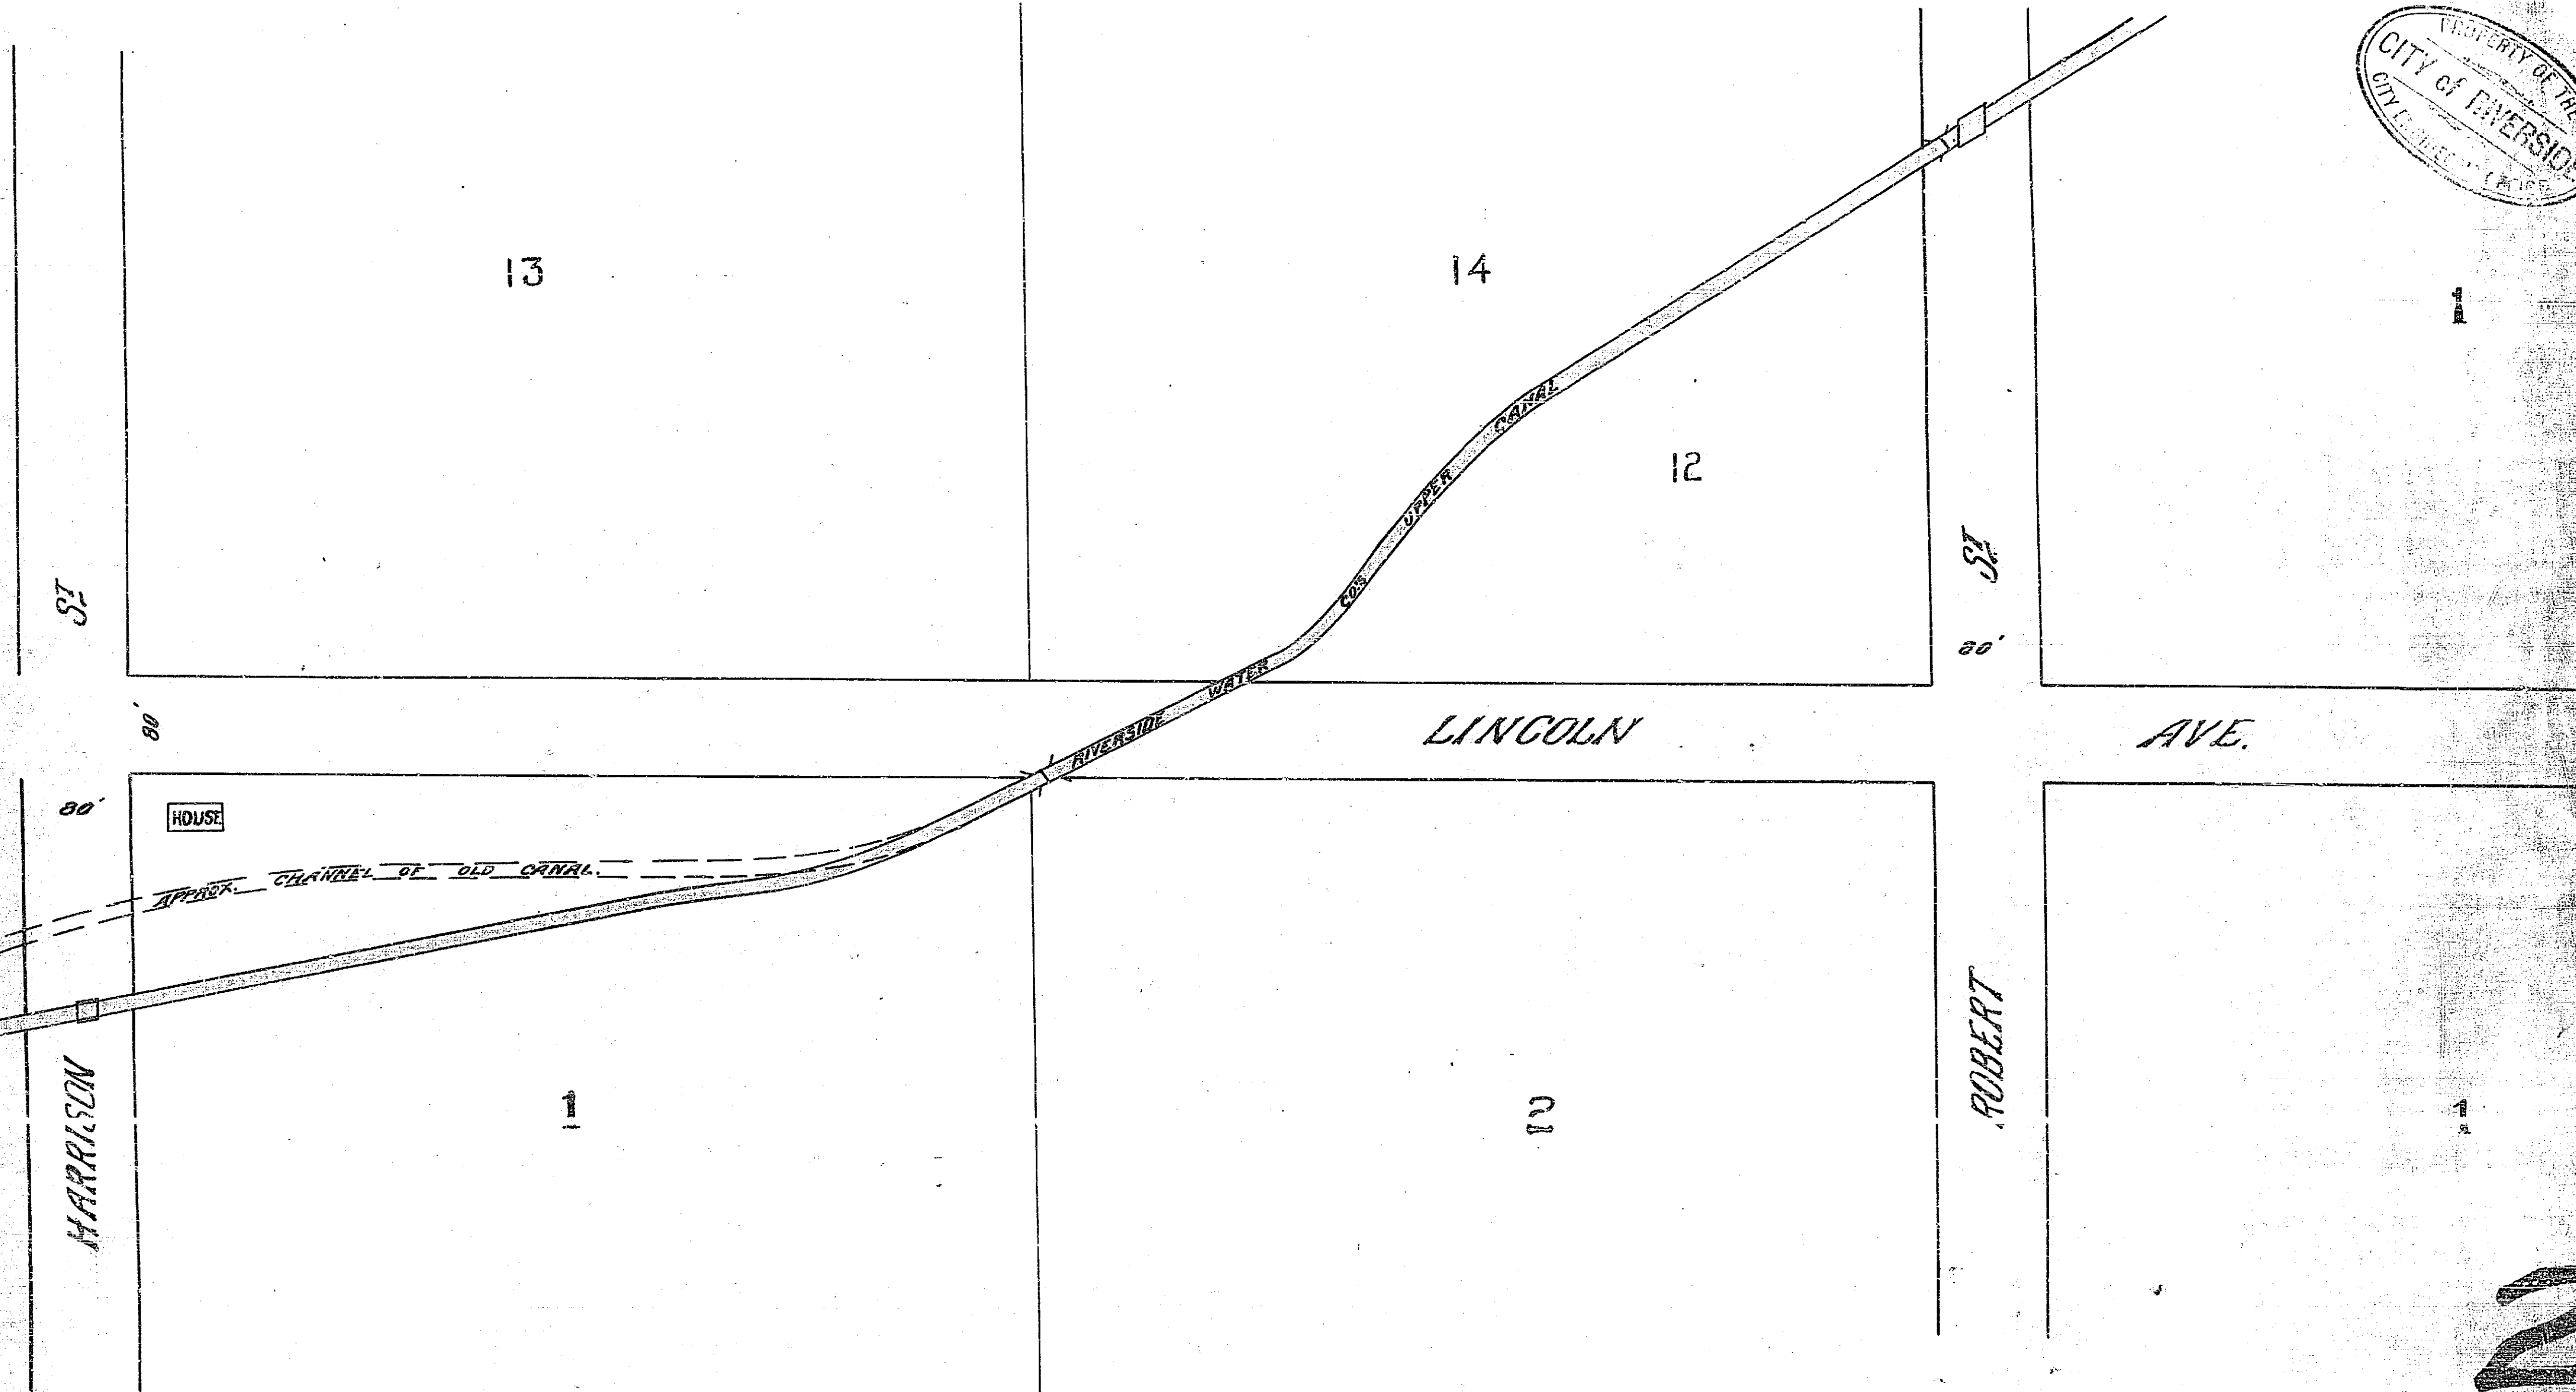

- Scale -
1 in = 100 ft.

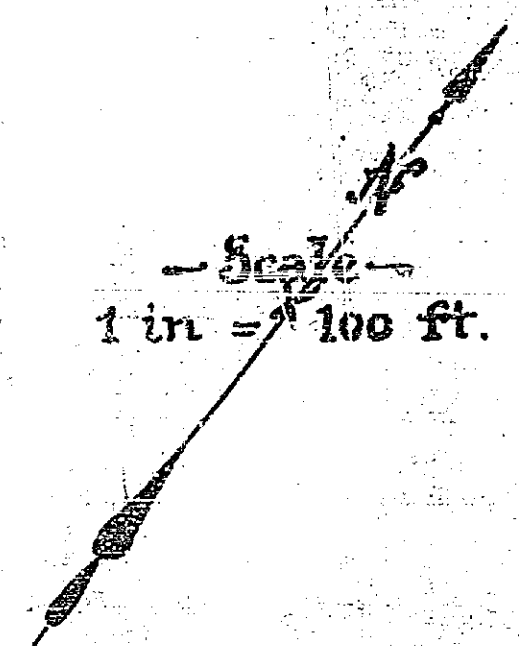

231
1892

52