

# PLAN AND PROFILE

## OF THE PROPOSED IMPROVEMENT OF

### CHARLOTTE WAY


APPROVED AND ADOPTED BY THE MAYOR  
AND COUNCIL OF THE CITY OF RIVERSIDE  
THIS 11TH DAY OF JUNE 1935

*Frank Miller*  
CITY CLERK, CITY OF RIVERSIDE.

ENG. DEPT. CITY OF RIVERSIDE 1935.

CITY U S G S DATUM PLANE

FIELD BOOK 302 PAGES 38-48

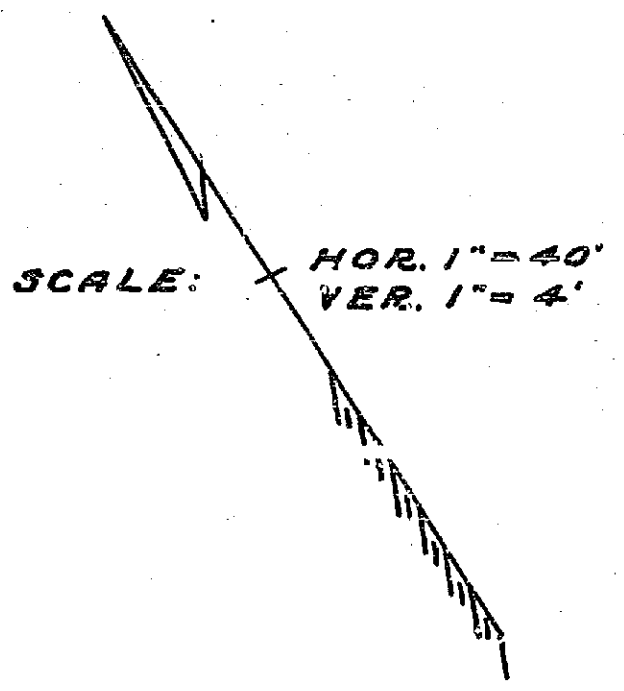

Constructed by Street Dept 1935

## PLAN

