


523-D

H.

523-D

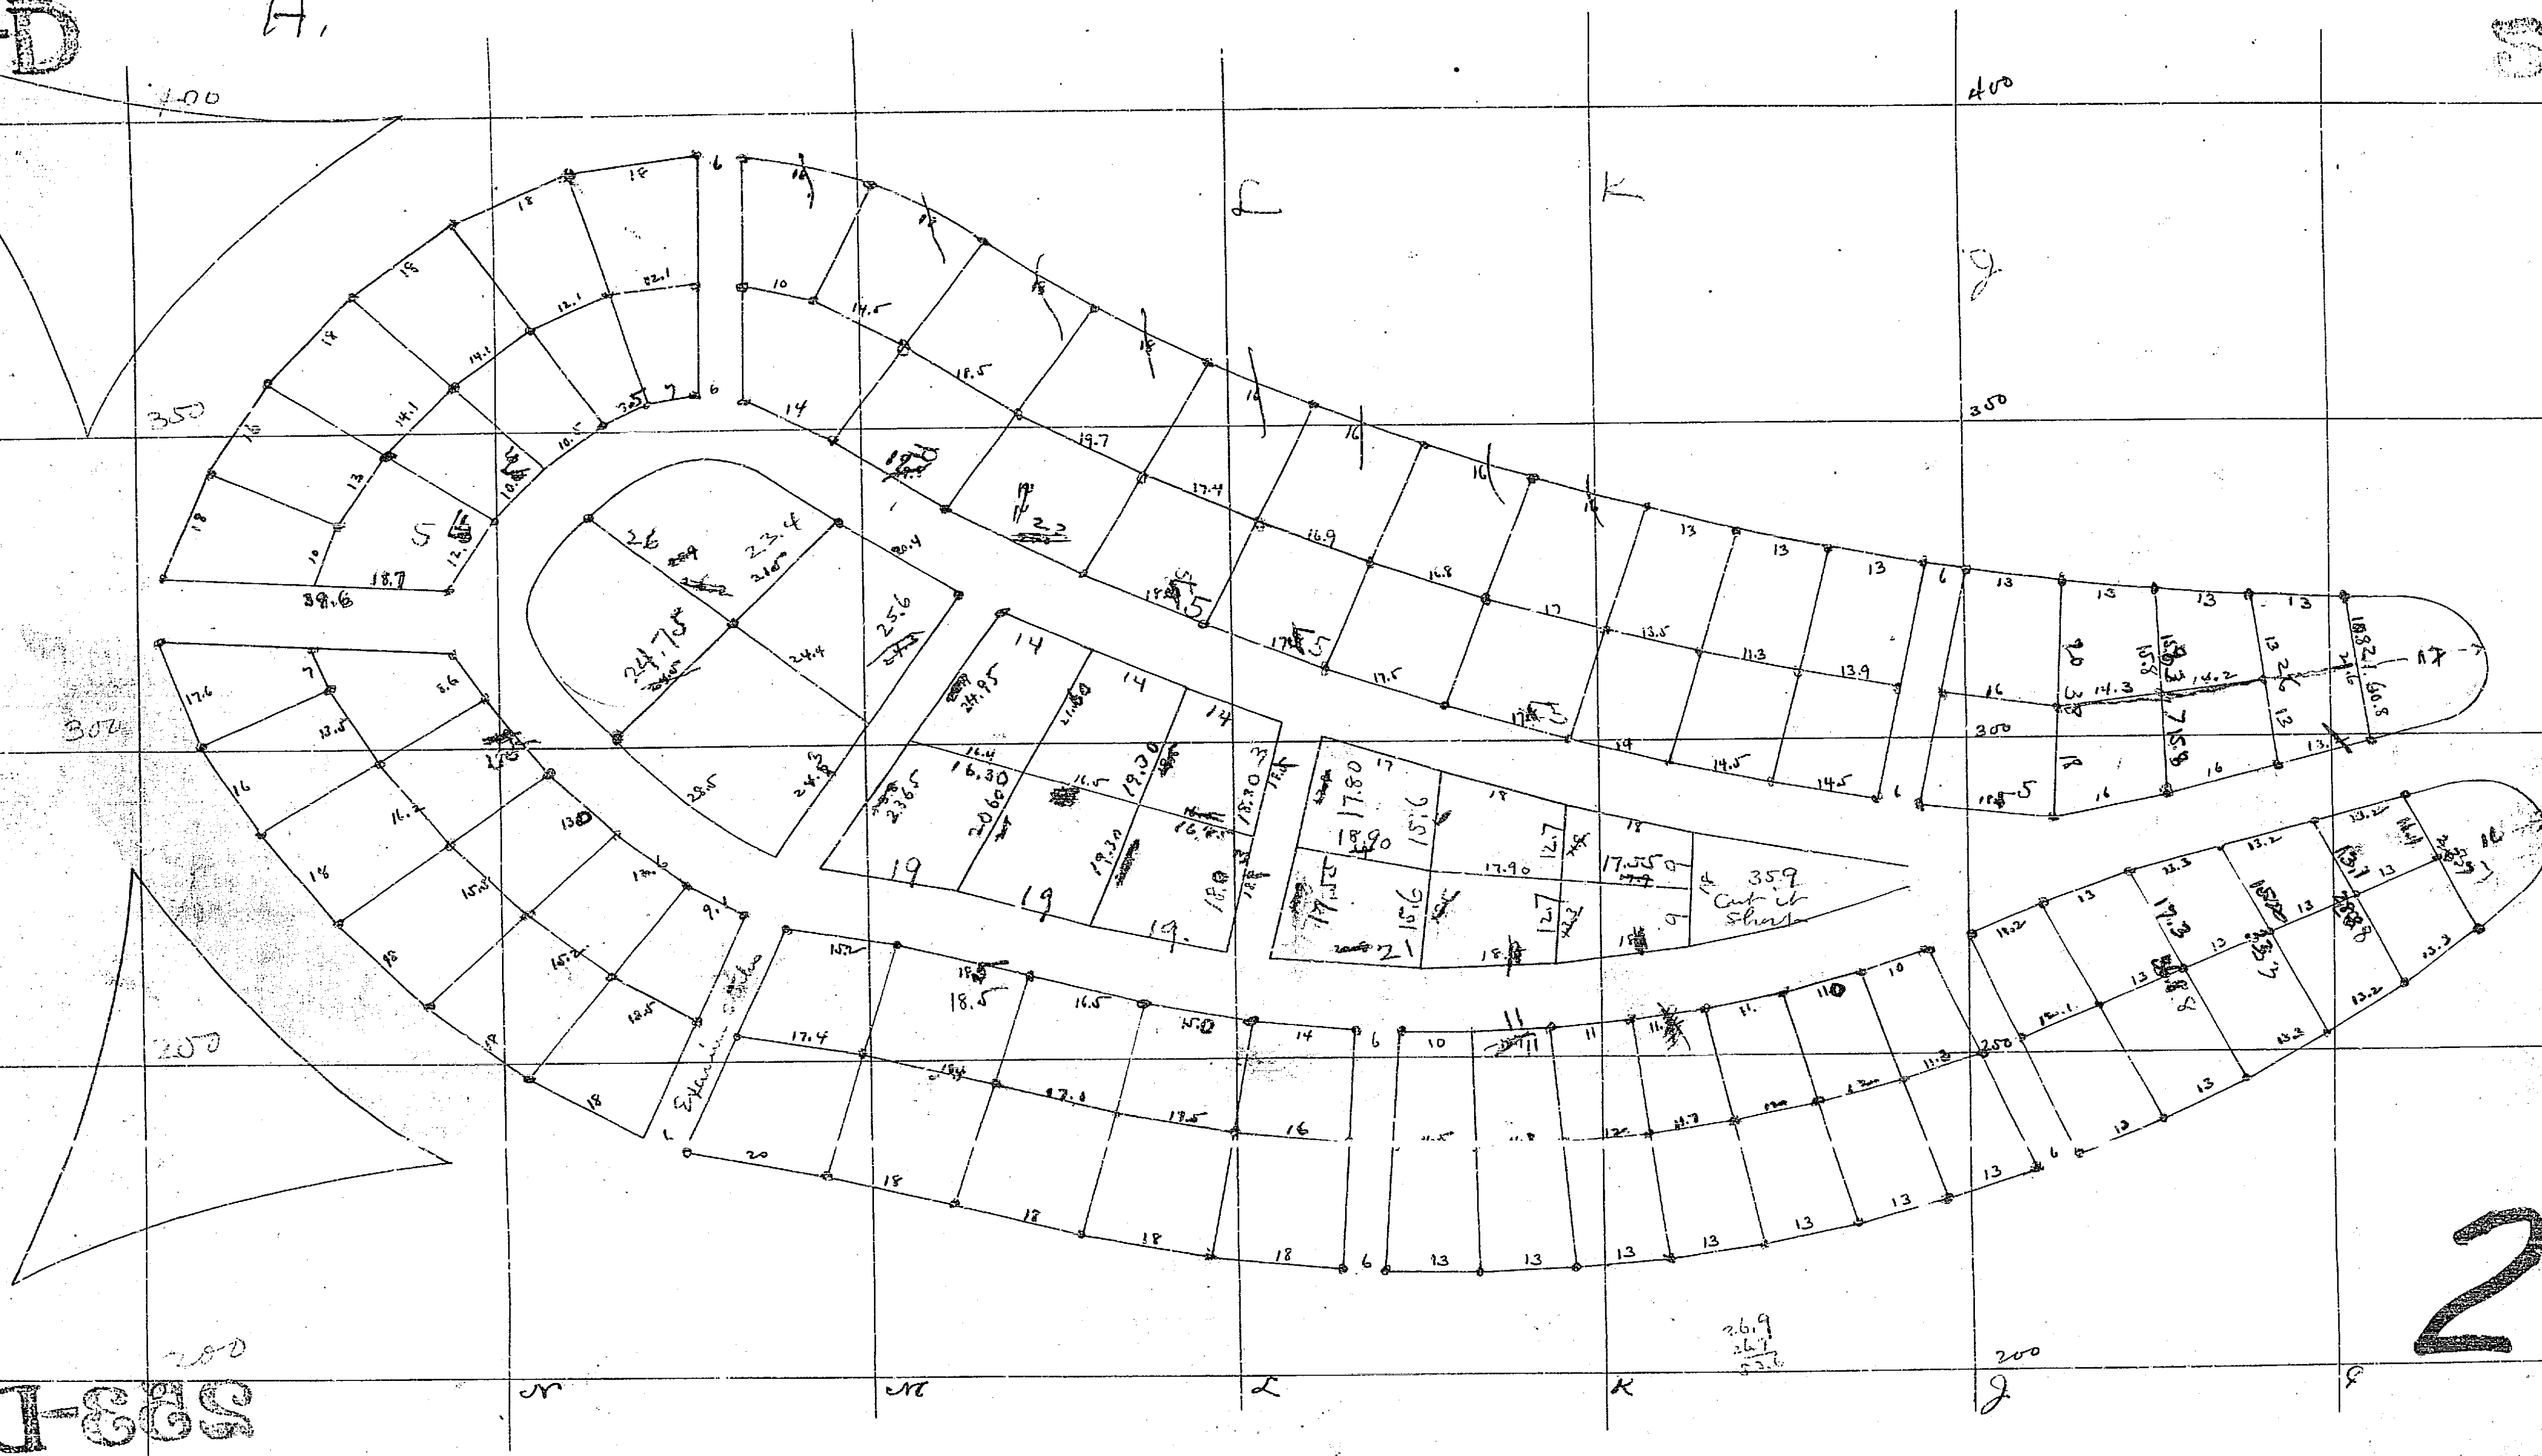

523-D

253-A

605