


FLAT
SHOWING PROPOSED
SANITARY SEWER EXTENSION
IN ARROYO DRIVE
CITY OF FIVERSIDE
Scales: Hor. 1 in. = 40 ft.
Vert. 1 in. = 4 ft.

Approved: M. N. Quinn
City Engineer

Cut Sheet made 1-14-51

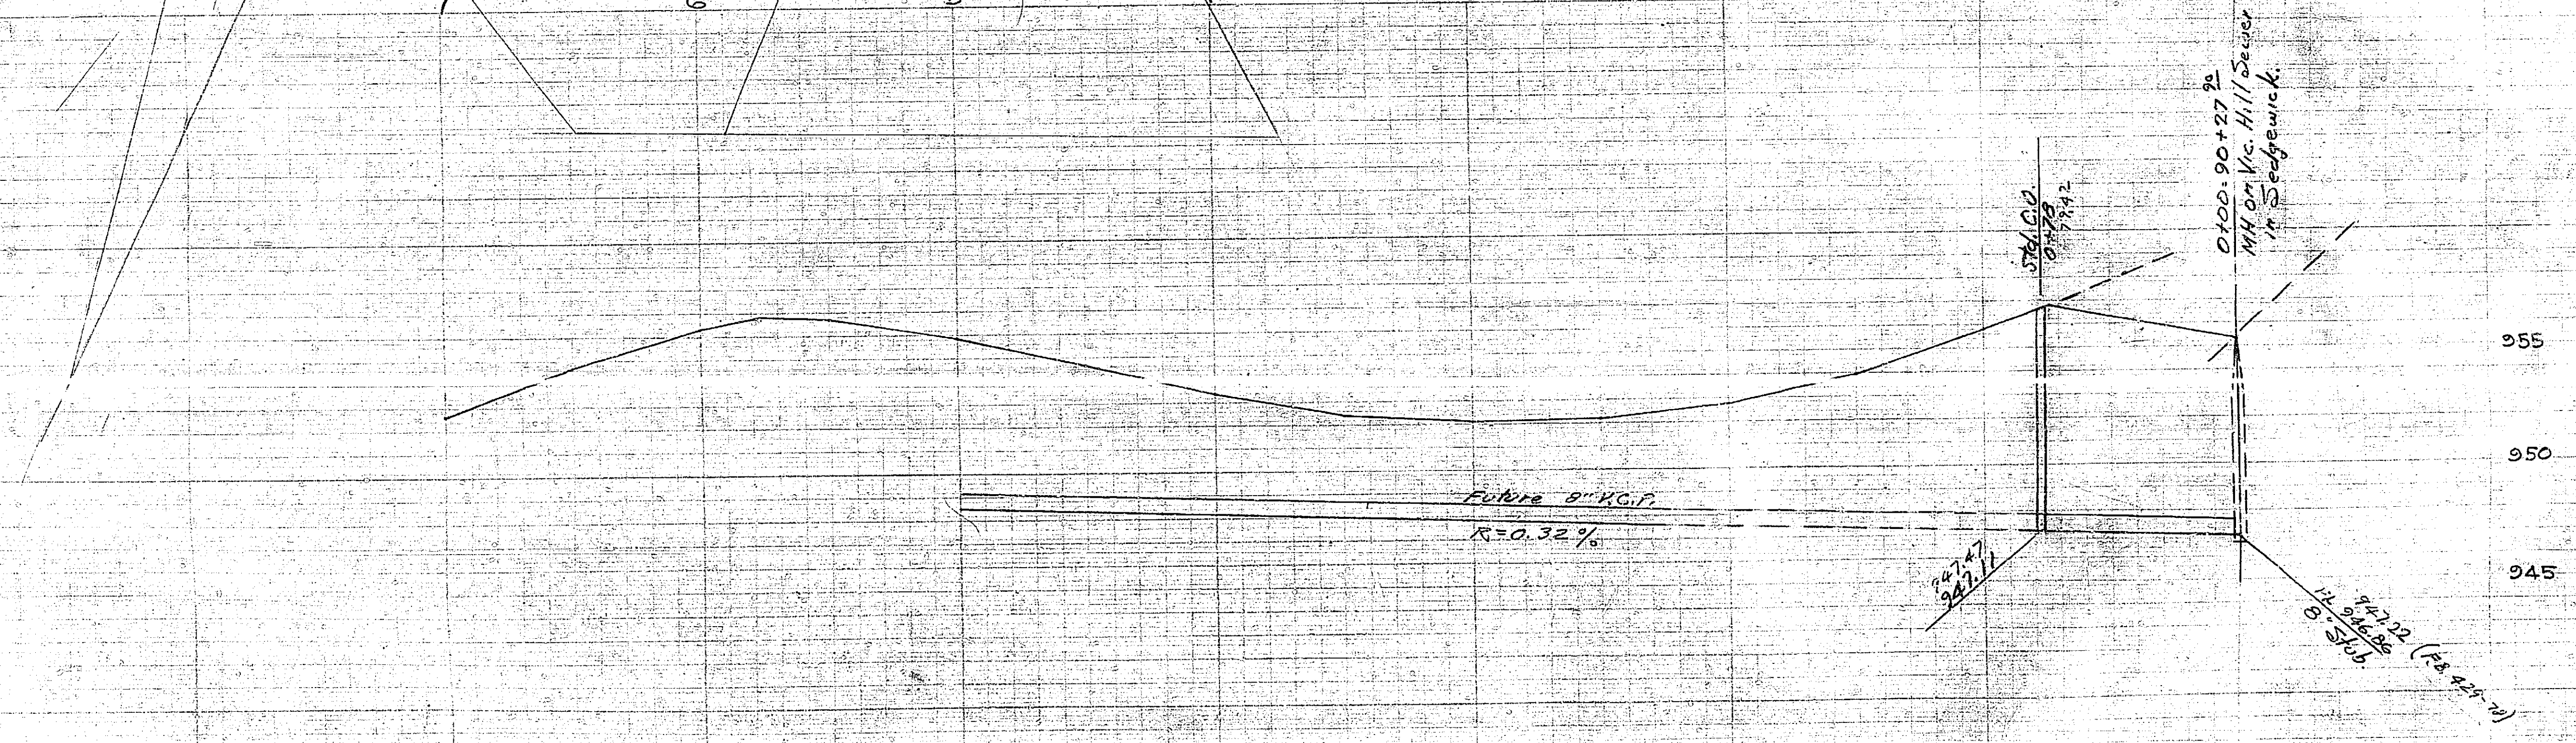

278 B