


MADE IN U.S.A.
 CIVIL ENGINEERING CO.
 NEW YORK, N.Y.

MADE IN U.S.A.
 CIVIL ENGINEERING CO.
 NEW YORK, N.Y.


DRAWING NUMBER	SHEET NUMBER	TOTAL SHEETS	BOOK
282A	1	1	
DRAWN BY	CHECKED BY	APPROVED BY	
E. J. M.			

PROFILE

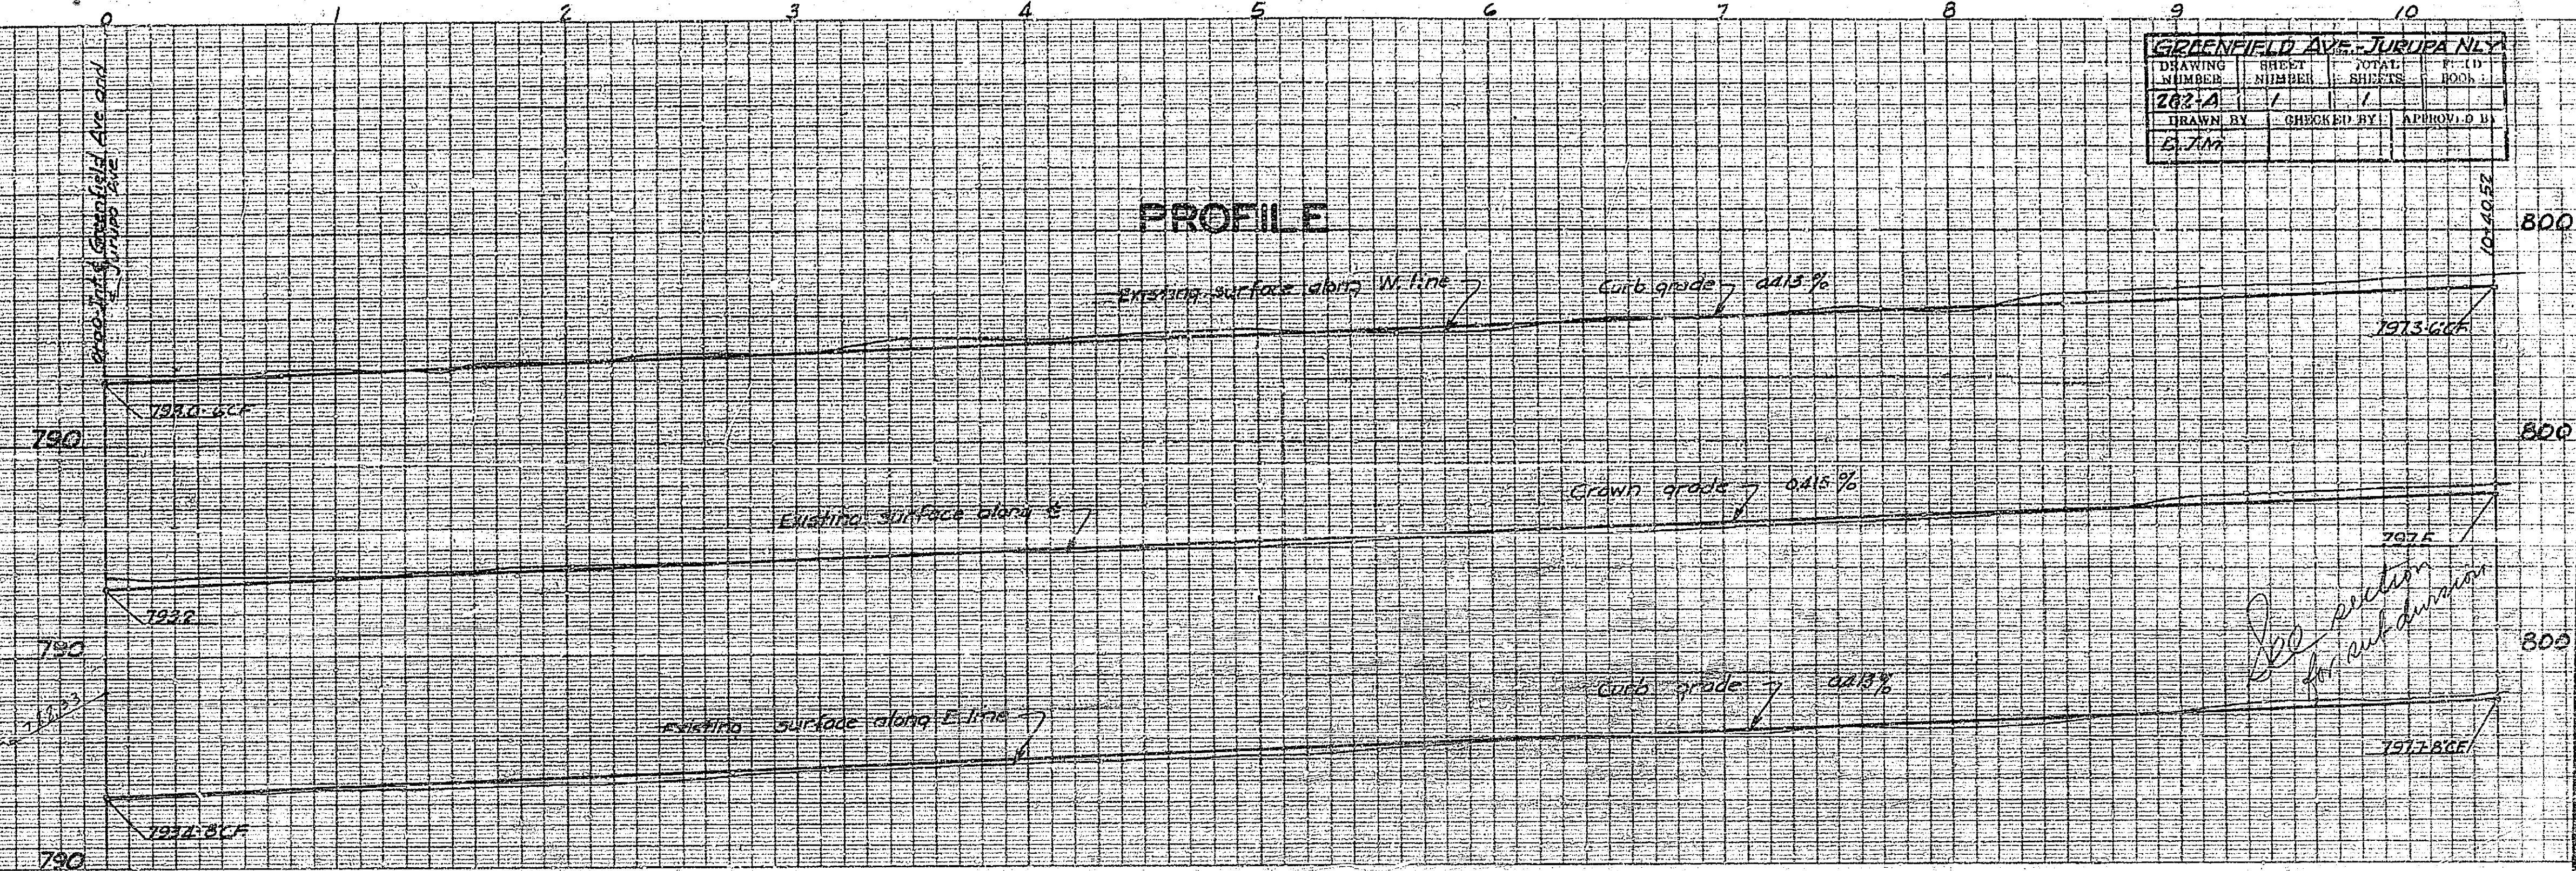

Note: Const. by W.P.A. & Street Dept
 Sept. 1940

PLAN

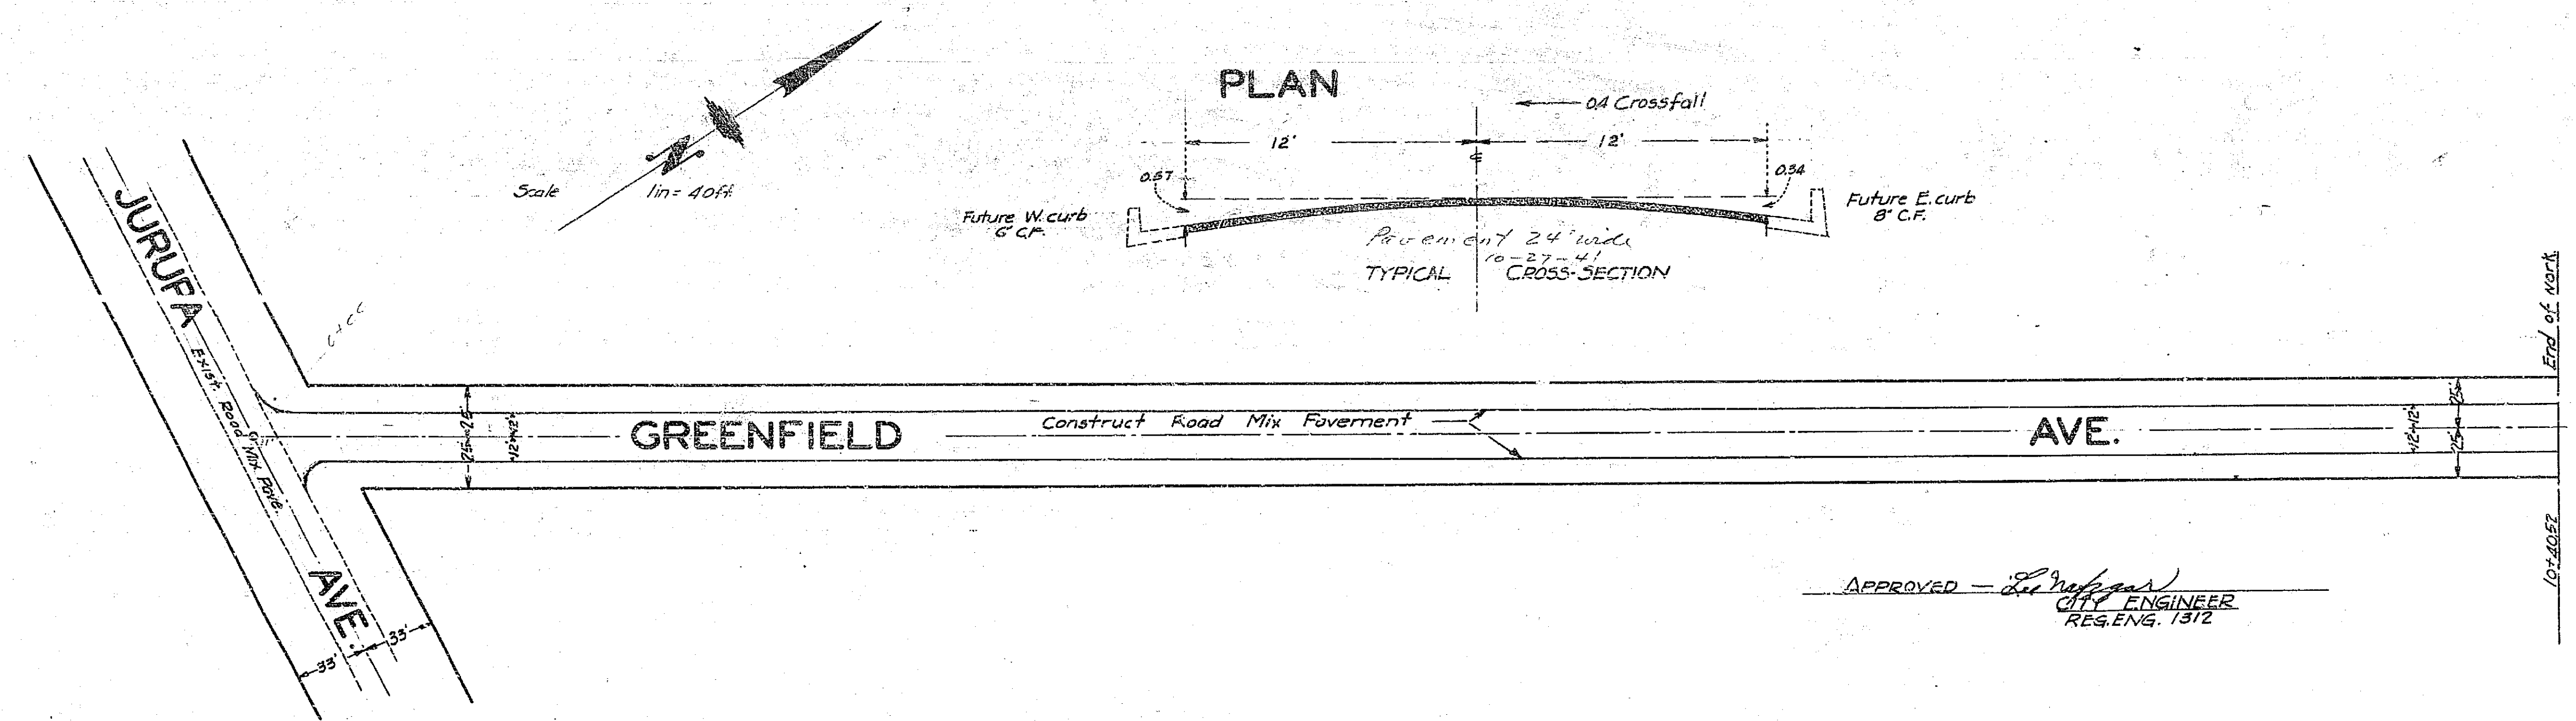

APPROVED - *[Signature]*
 CITY ENGINEER
 REG. ENG. 1312

282 A

A-30