Cottage St.
Grove to Victoria
421/21
Aug. 1946

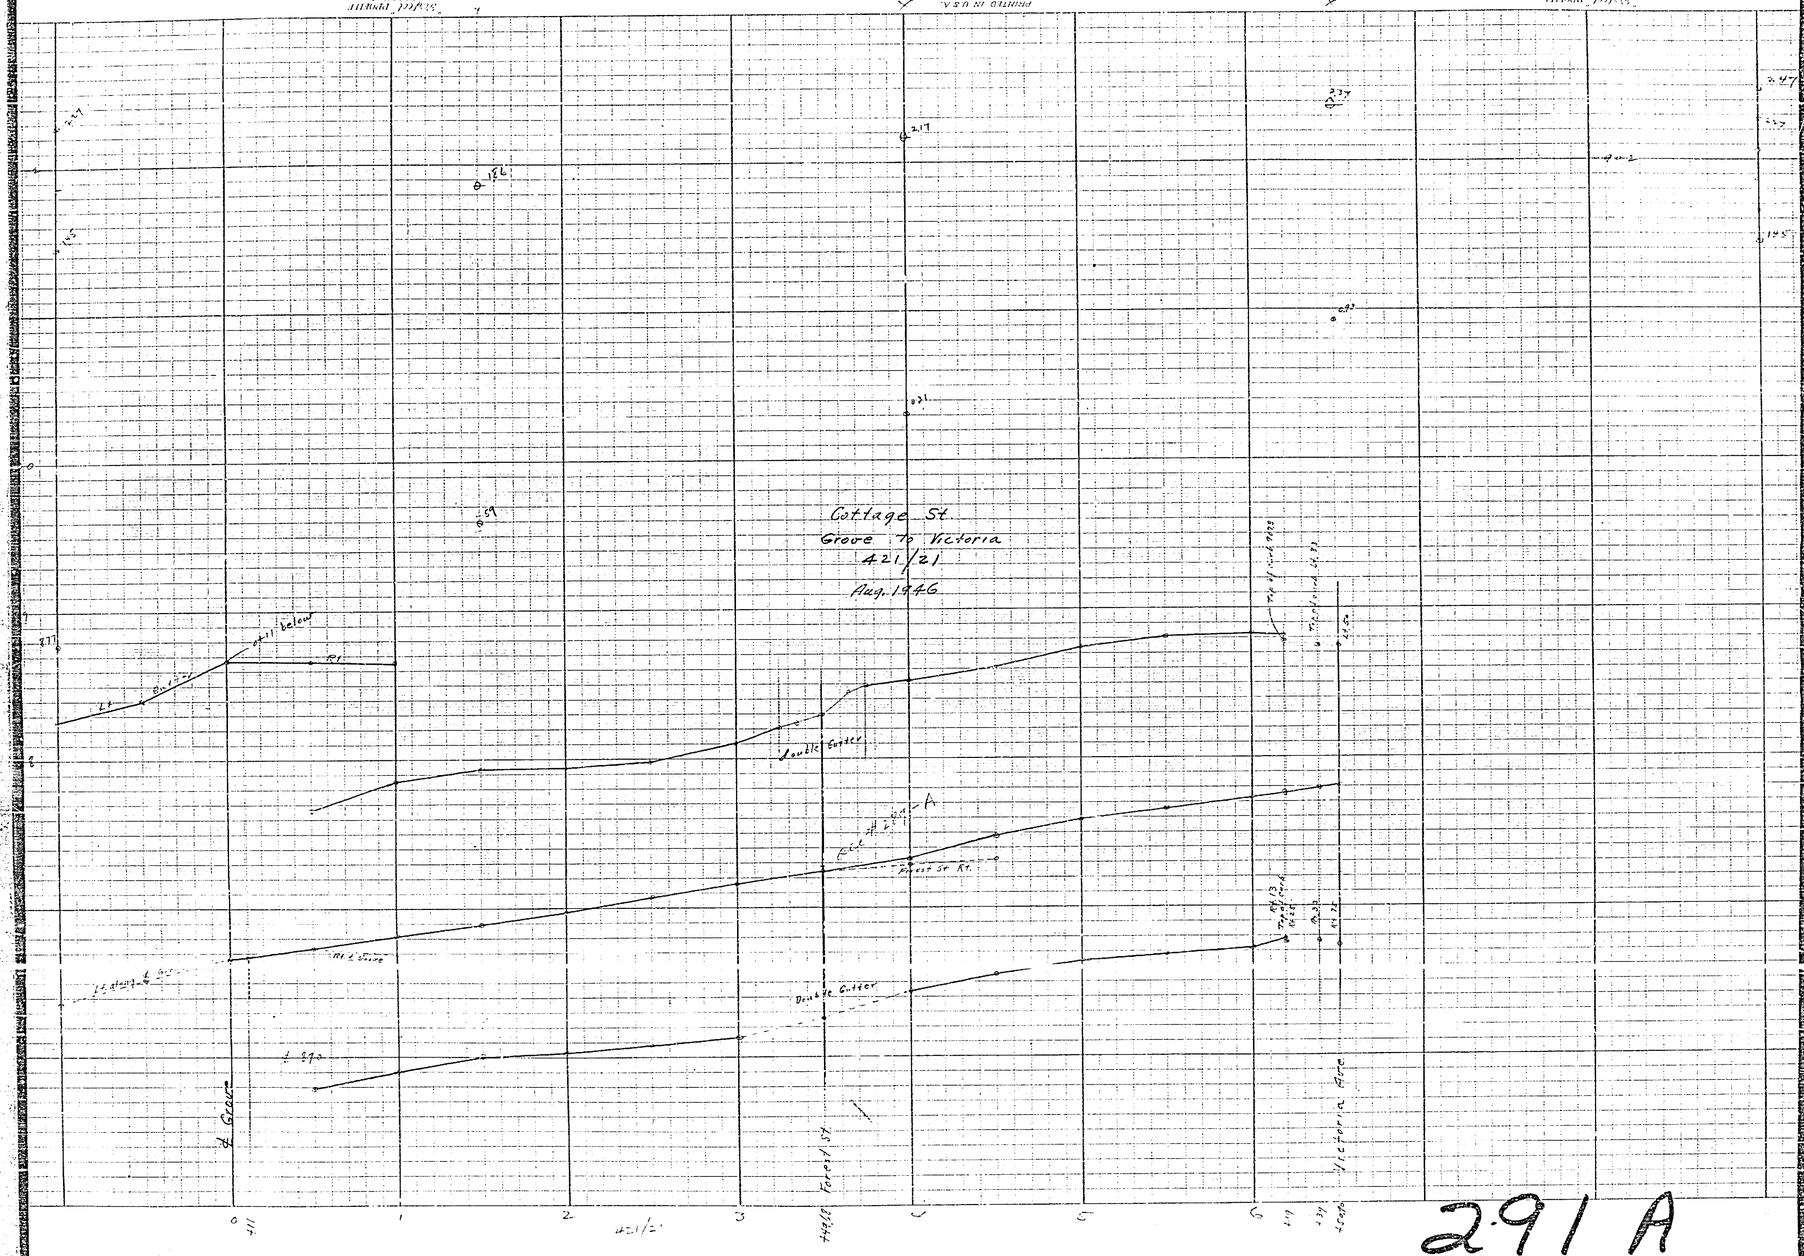

291 A