303

CITY OF RIVERSIDE, CALIF.

PLAN AND PROFILE OF SEWER IN EUGENE STREET

NOT CONSTRUCTED (PER PUB. SERVICE DEPT. 11-8-61)

~~Constructed by Street Dept. 1929~~

195/1-3

PROFILE

Scale 1in.=40ft

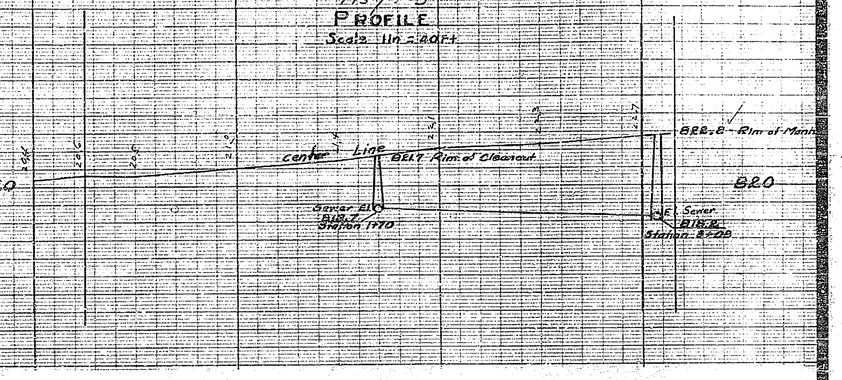

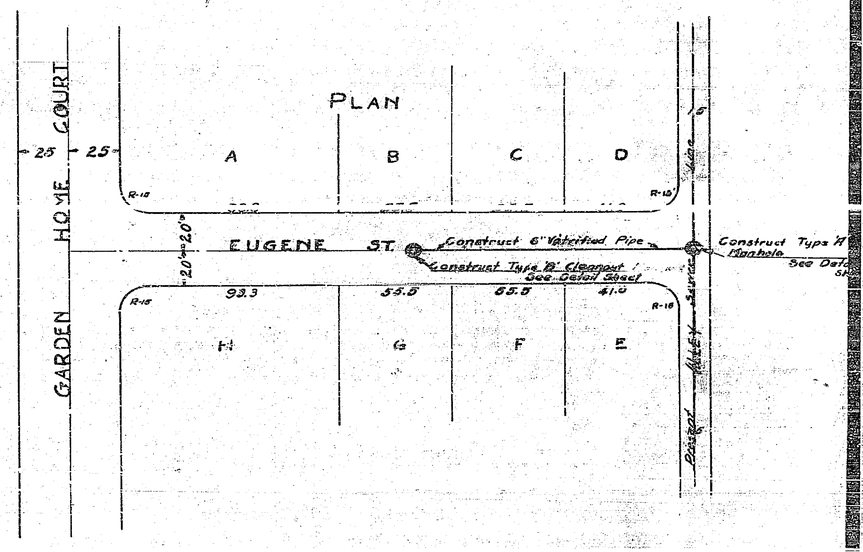

303

606