


Plan & Profile of
EUGENE ST.
 Between Home & Garden
 and Akeley Sts.
 December 10, 1943
 Scale: VERT. 1" = 10'
 HOR. 1" = 40'

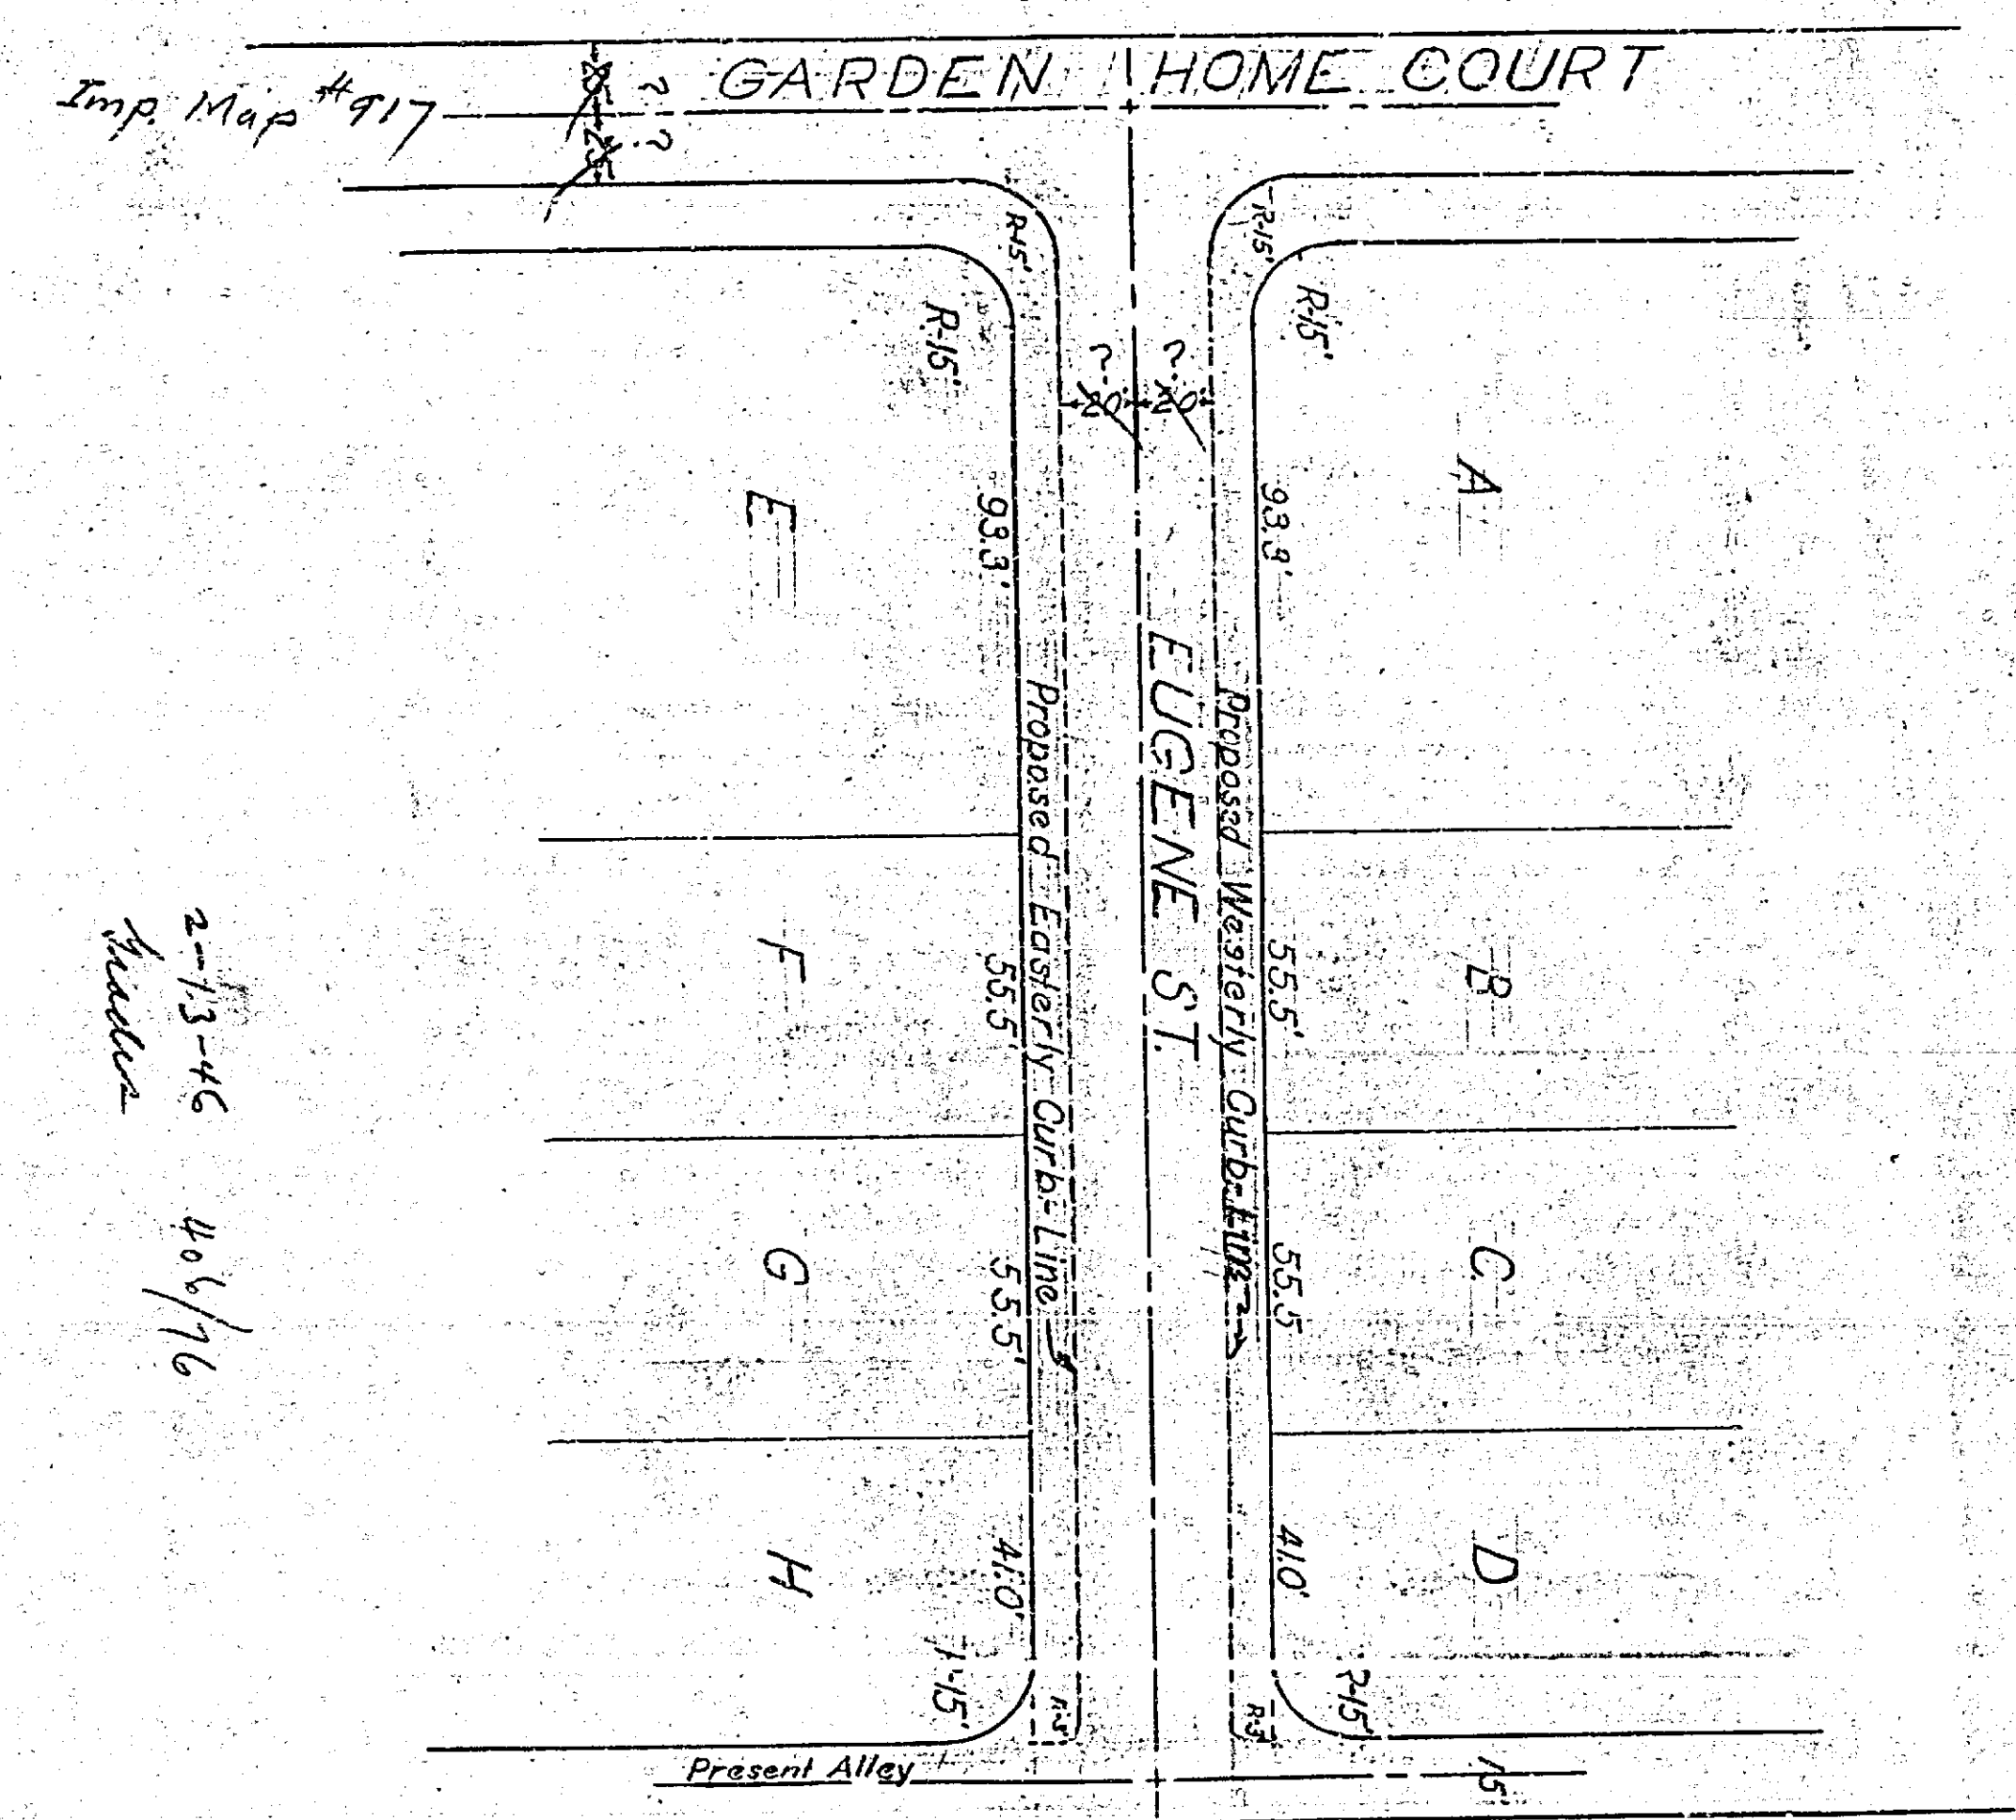

2-13-46
 Hester
 10/6/76

303A