
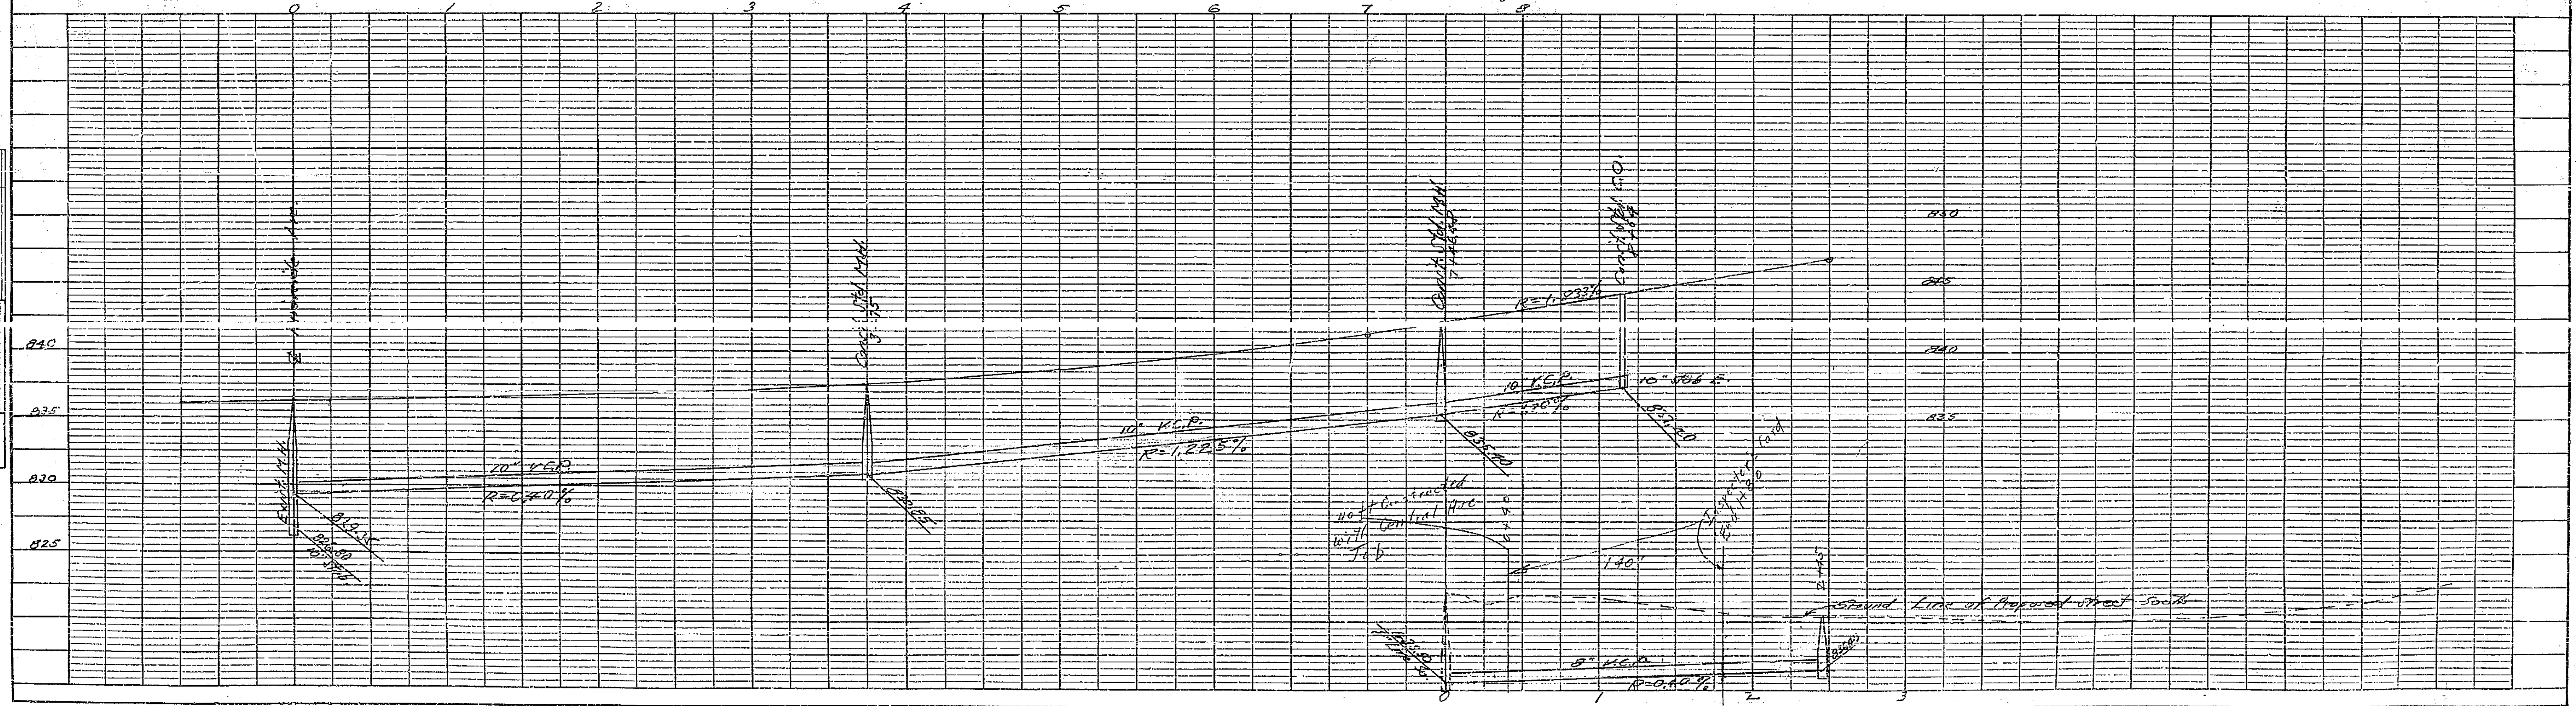


PLAN & PROFILE No 306-A  
 SHOWING SEWER EXTENSION IN  
 CENTRAL AVENUE  
 FROM RIVERSIDE AVENUE EAST

FEB. 1951  
 F.B. 478-52  
 SCALES HOR. 1" = 50 FT.  
 VERT. 1" = 5 FT.  
 APPROVED *M. X. Dwyer*  
 MUNICIPAL ENG. CL. No. 5011  
 CITY ENGINEER.

PLAN  
 CHECKED  
 PLOTTED  
 NOTE BOOK  
 NO. OF W.C. CHECKED  
 NO.

PROFILE  
 CHECKED  
 PLOTTED  
 NOTE BOOK  
 NO. OF W.C. CHECKED  
 NO.

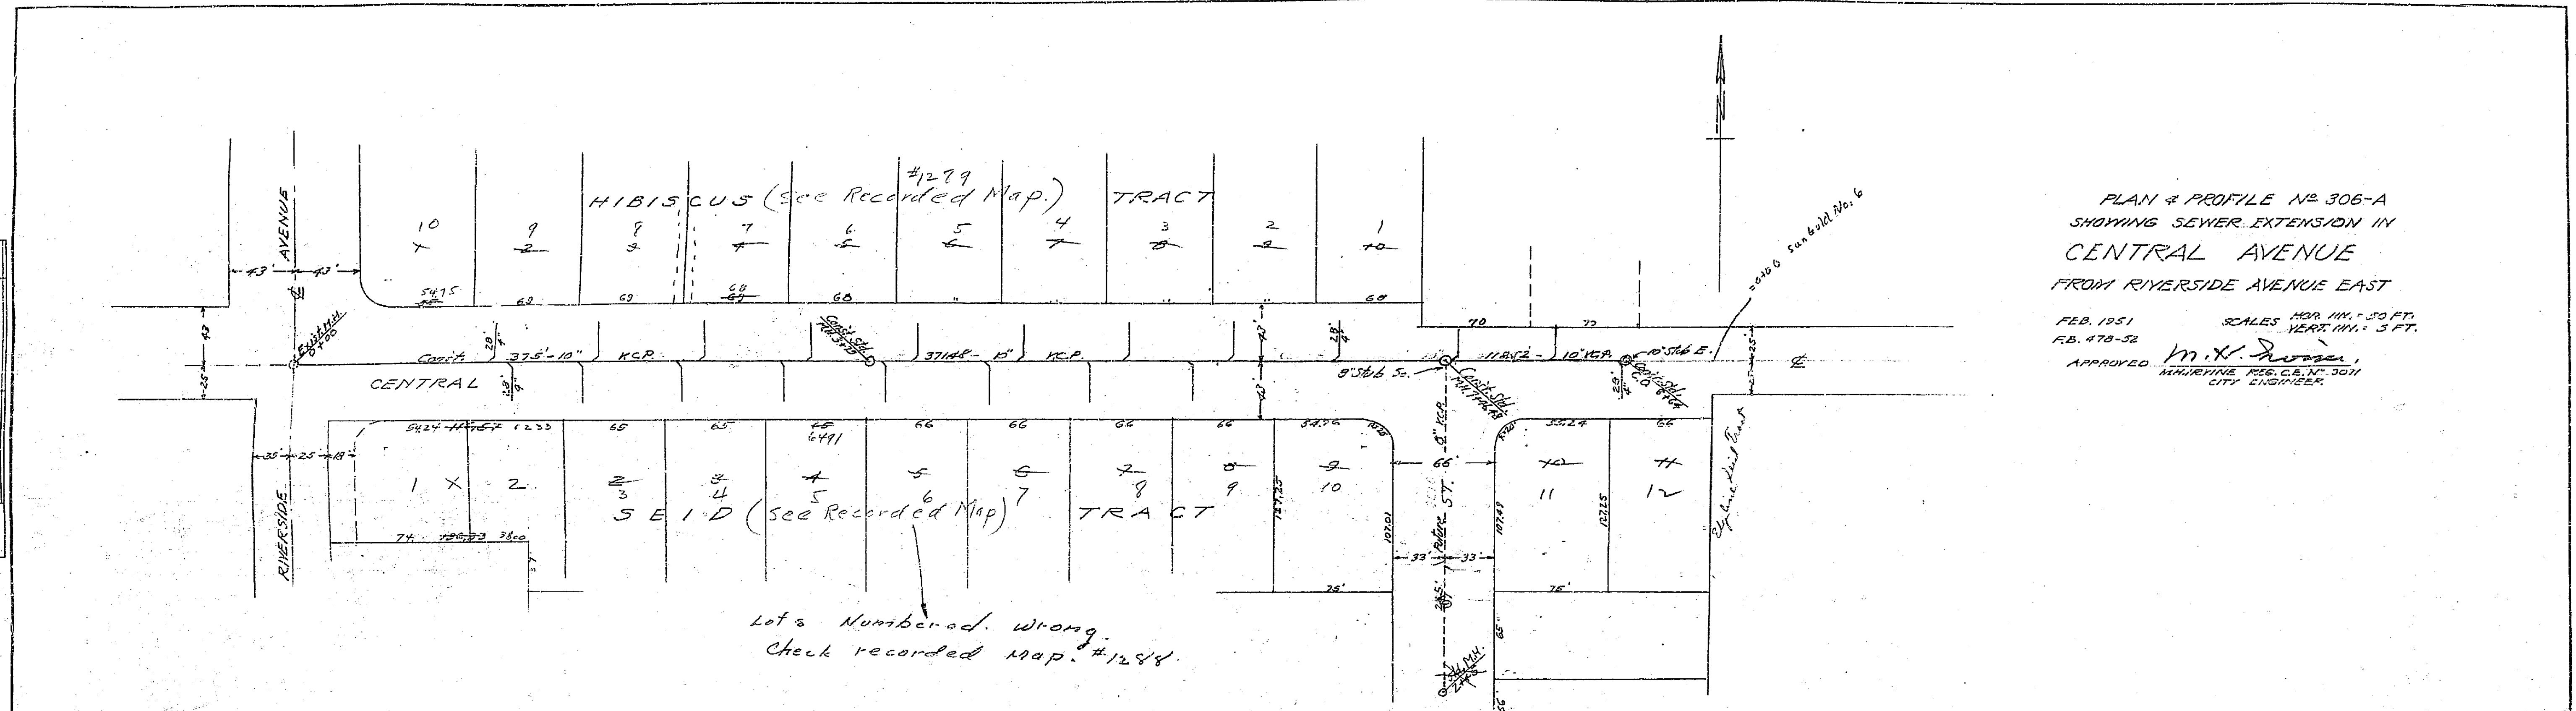

306A