
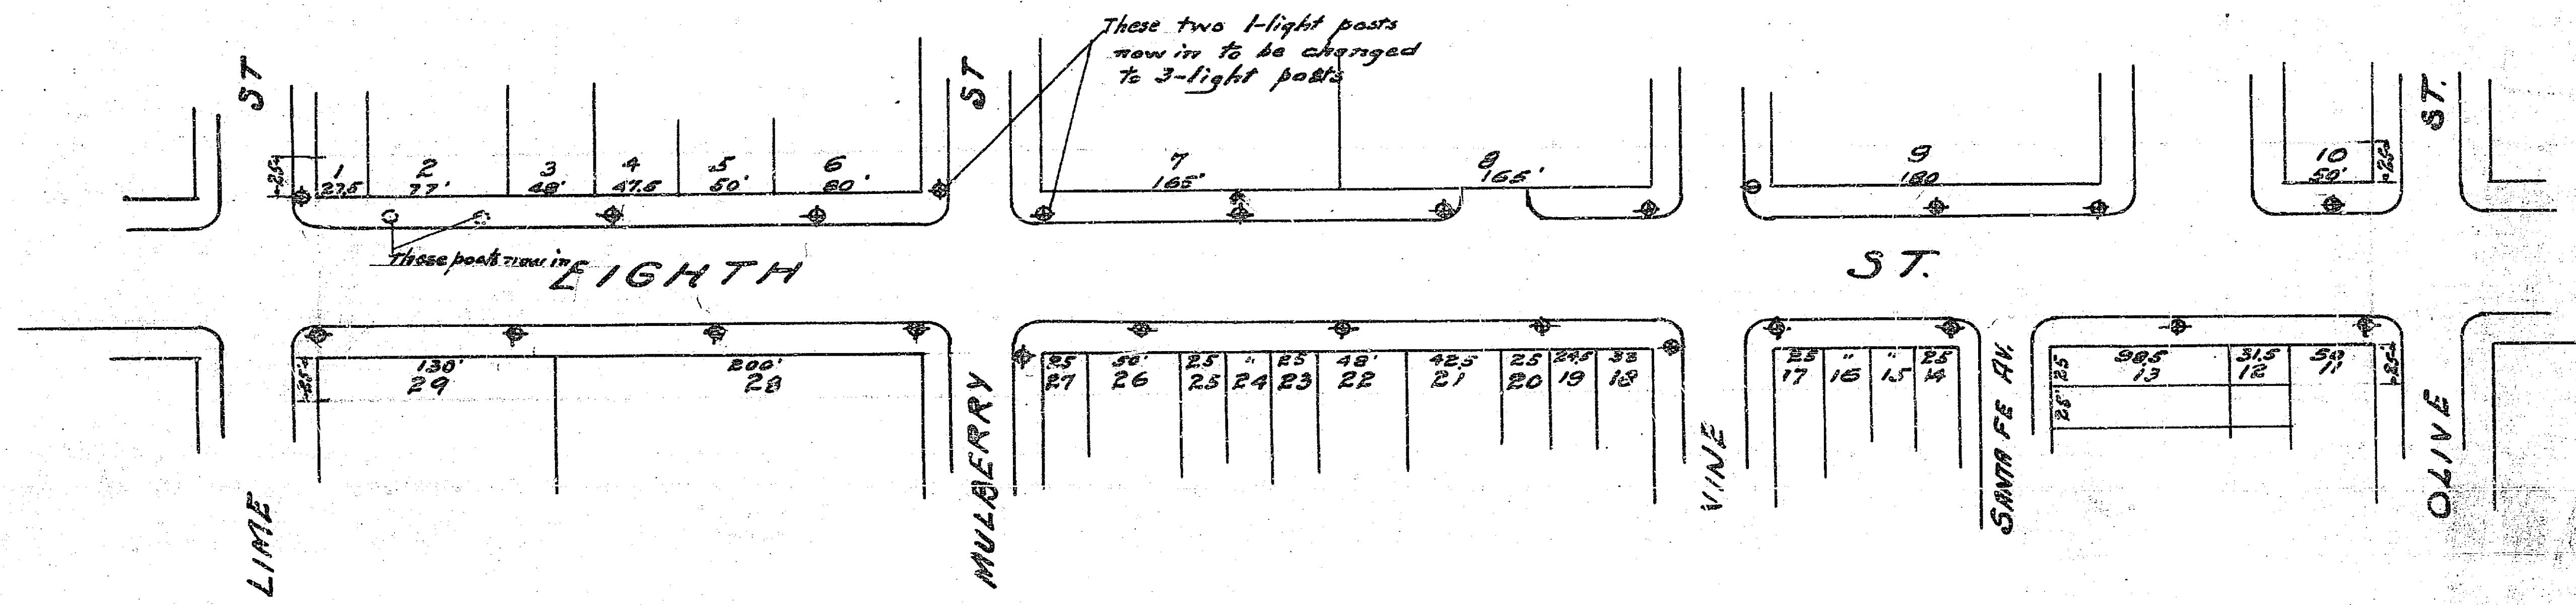


307 A-108

307 A-108

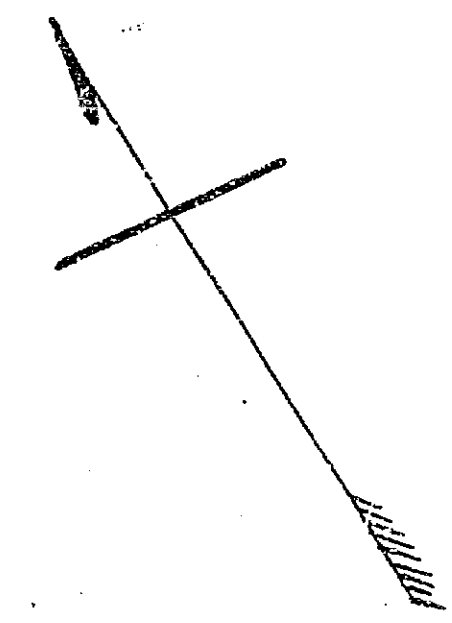

CITY OF RIVERSIDE  
**DIAGRAM**  
 Showing proposed lighting system on  
EIGHTH ST. between LIME & OLIVE ST.  
 and the District benefited  
 The boundary of the district benefited  
 is shown thus in green.

307 A-108

307 A-108