


308B

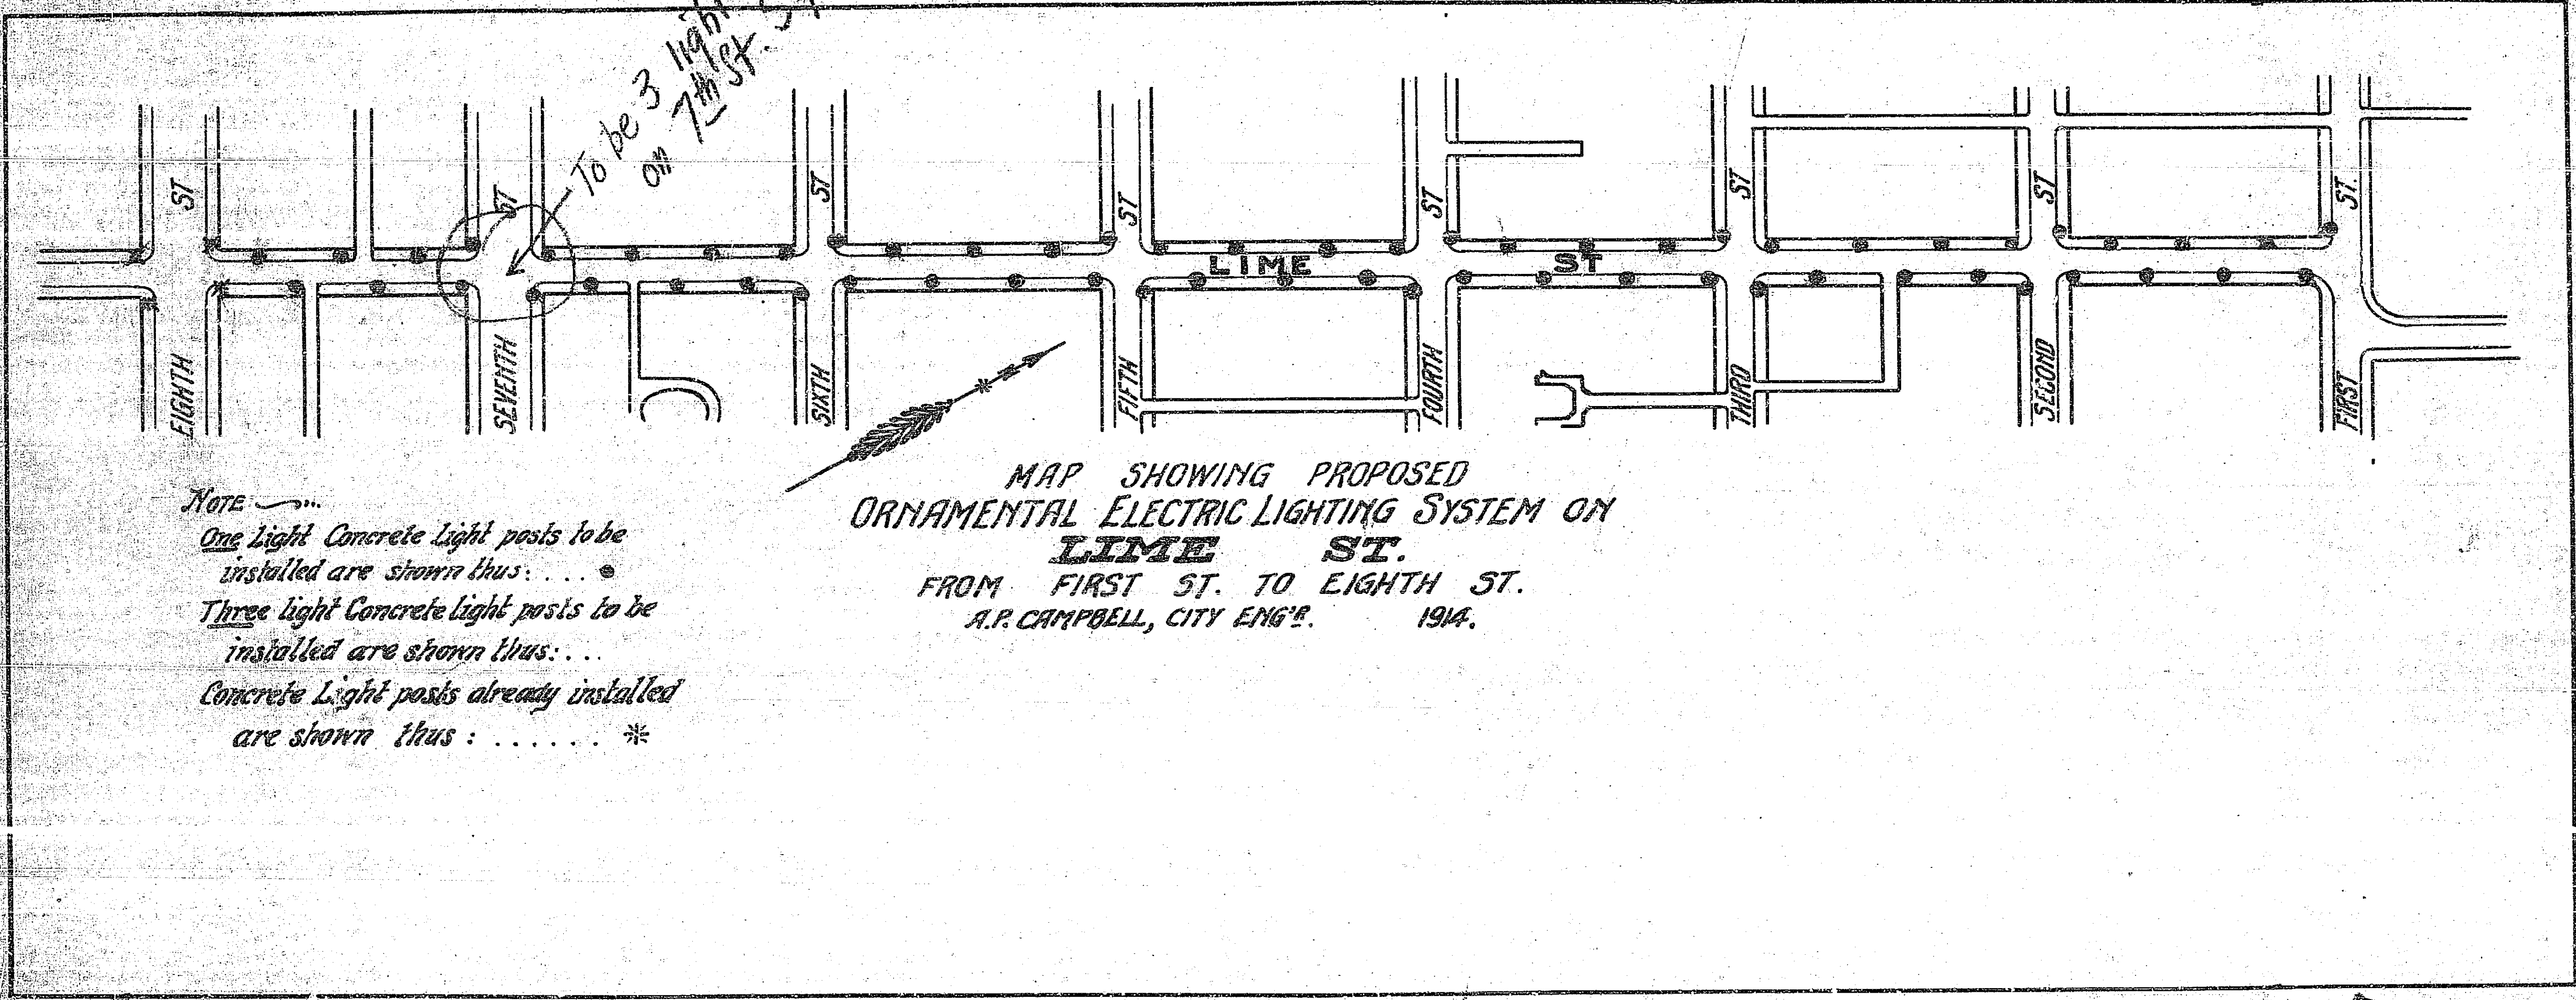

Note ~~~~
 One light Concrete light posts to be installed are shown thus: ●
 Three light Concrete light posts to be installed are shown thus:
 Concrete Light posts already installed are shown thus: *

MAP SHOWING PROPOSED
 ORNAMENTAL ELECTRIC LIGHTING SYSTEM ON
LIME ST.
 FROM FIRST ST. TO EIGHTH ST.
 A.P. CAMPBELL, CITY ENG'G. 1914.

308B

308B

308B 308B