


D-118


319

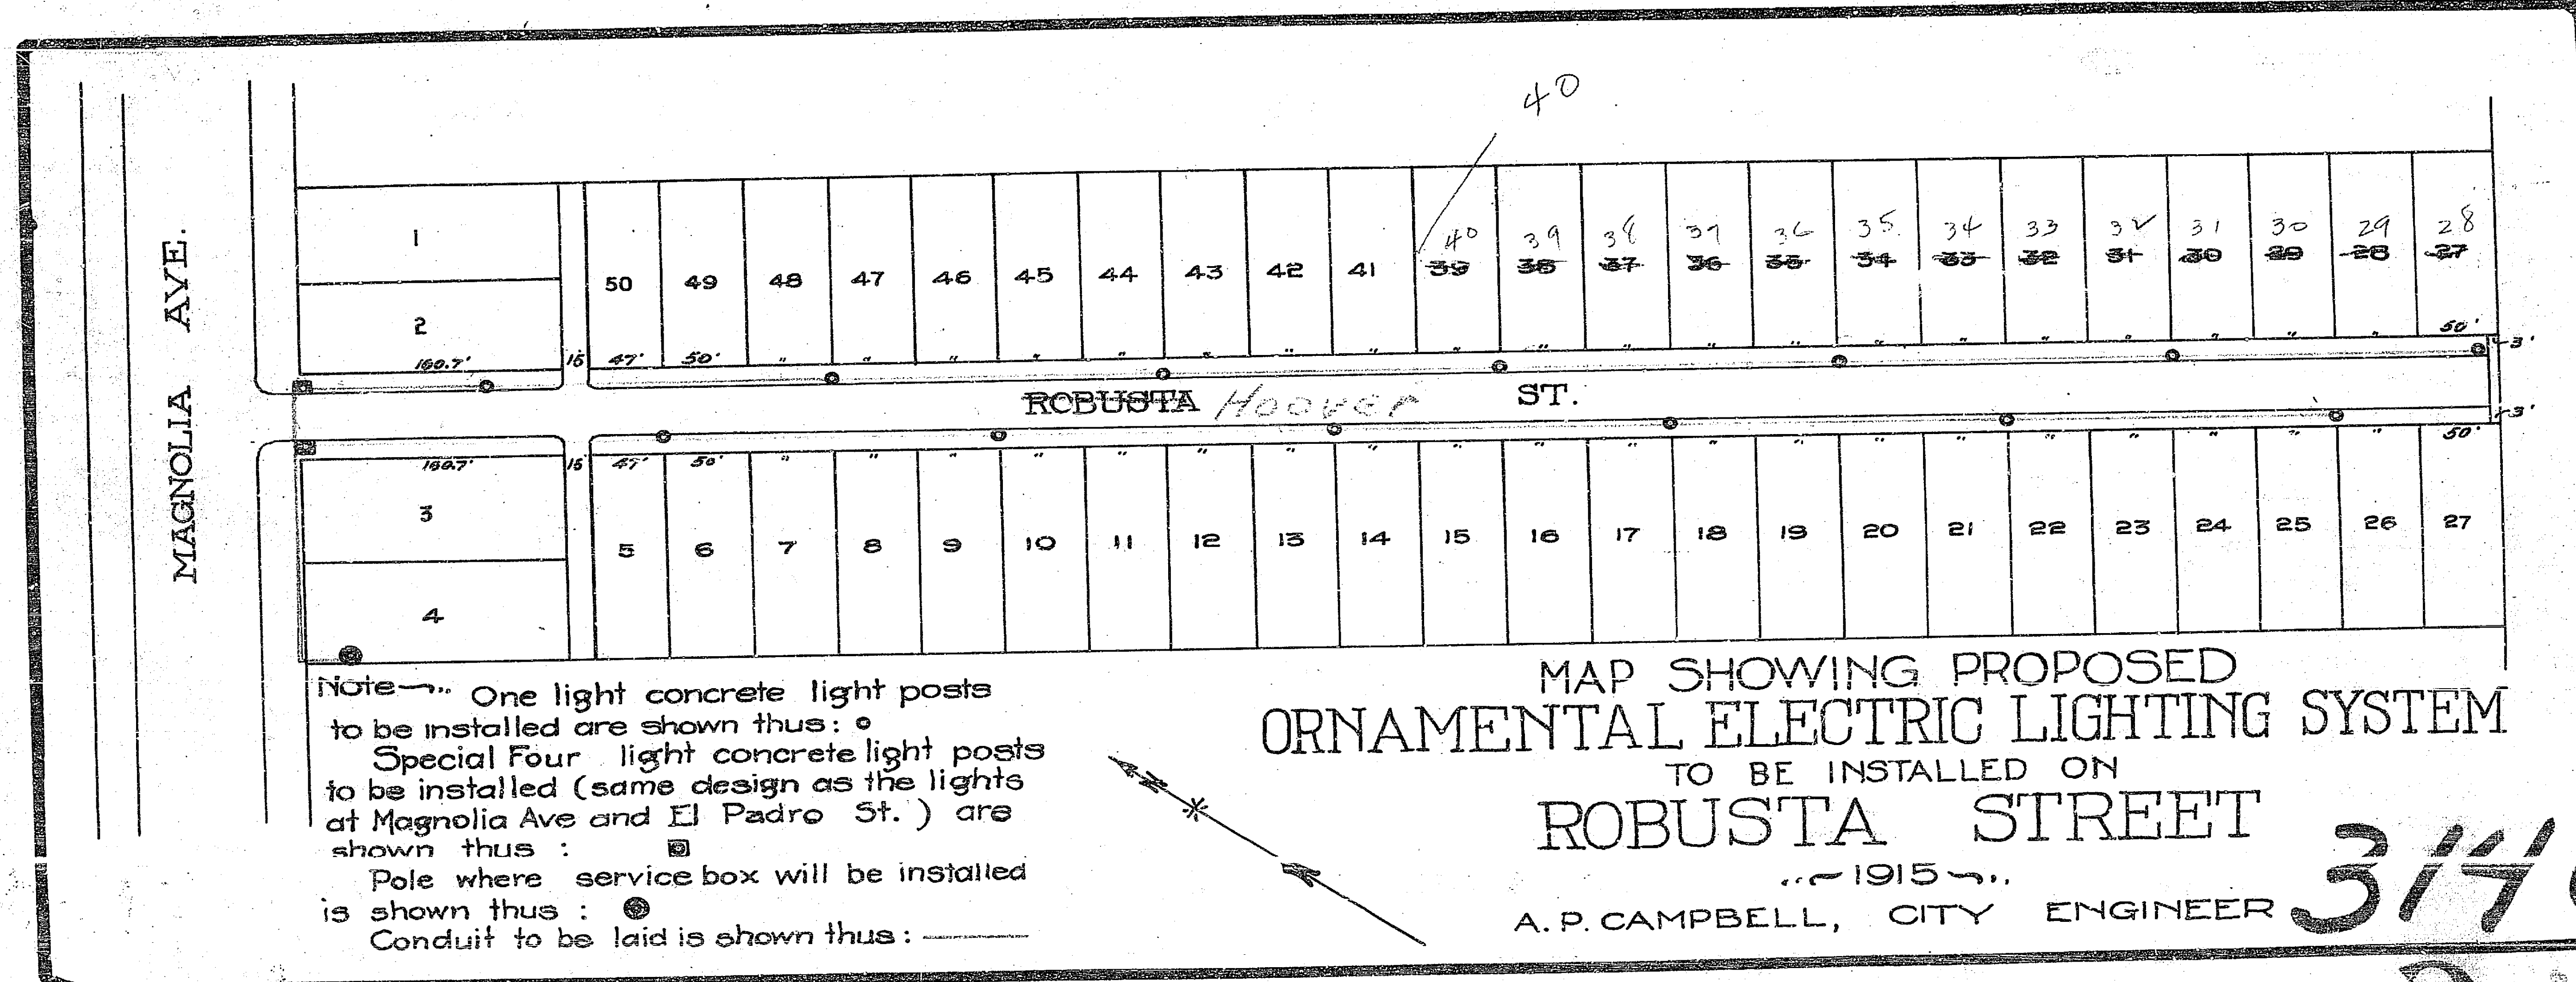

MAGNOLIA AVE.

ROBUSTA Hoover ST.

Note - One light concrete light posts to be installed are shown thus: ●  
 Special Four light concrete light posts to be installed (same design as the lights at Magnolia Ave and El Padro St.) are shown thus: ■  
 Pole where service box will be installed is shown thus: ⊙  
 Conduit to be laid is shown thus: ———

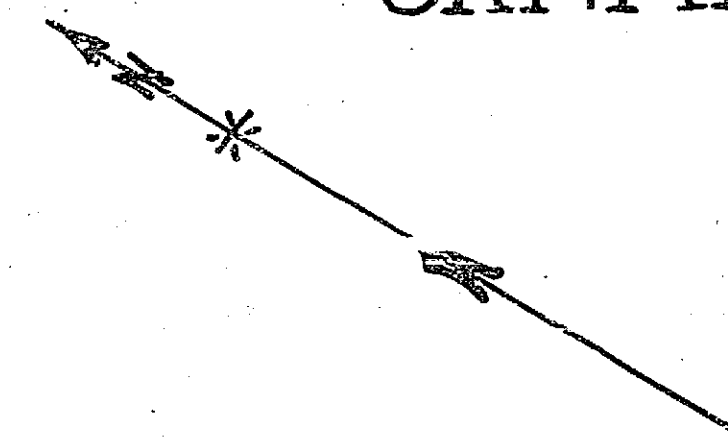

D-118

D-118