


PROPOSED SEWER HOUSING PROJECT FOR MARCH FIELD			
Drawing Number	Sheet Number	Total Sheets	Field Book
323	1	1	383
Drawn by	Checked	Approved	

30

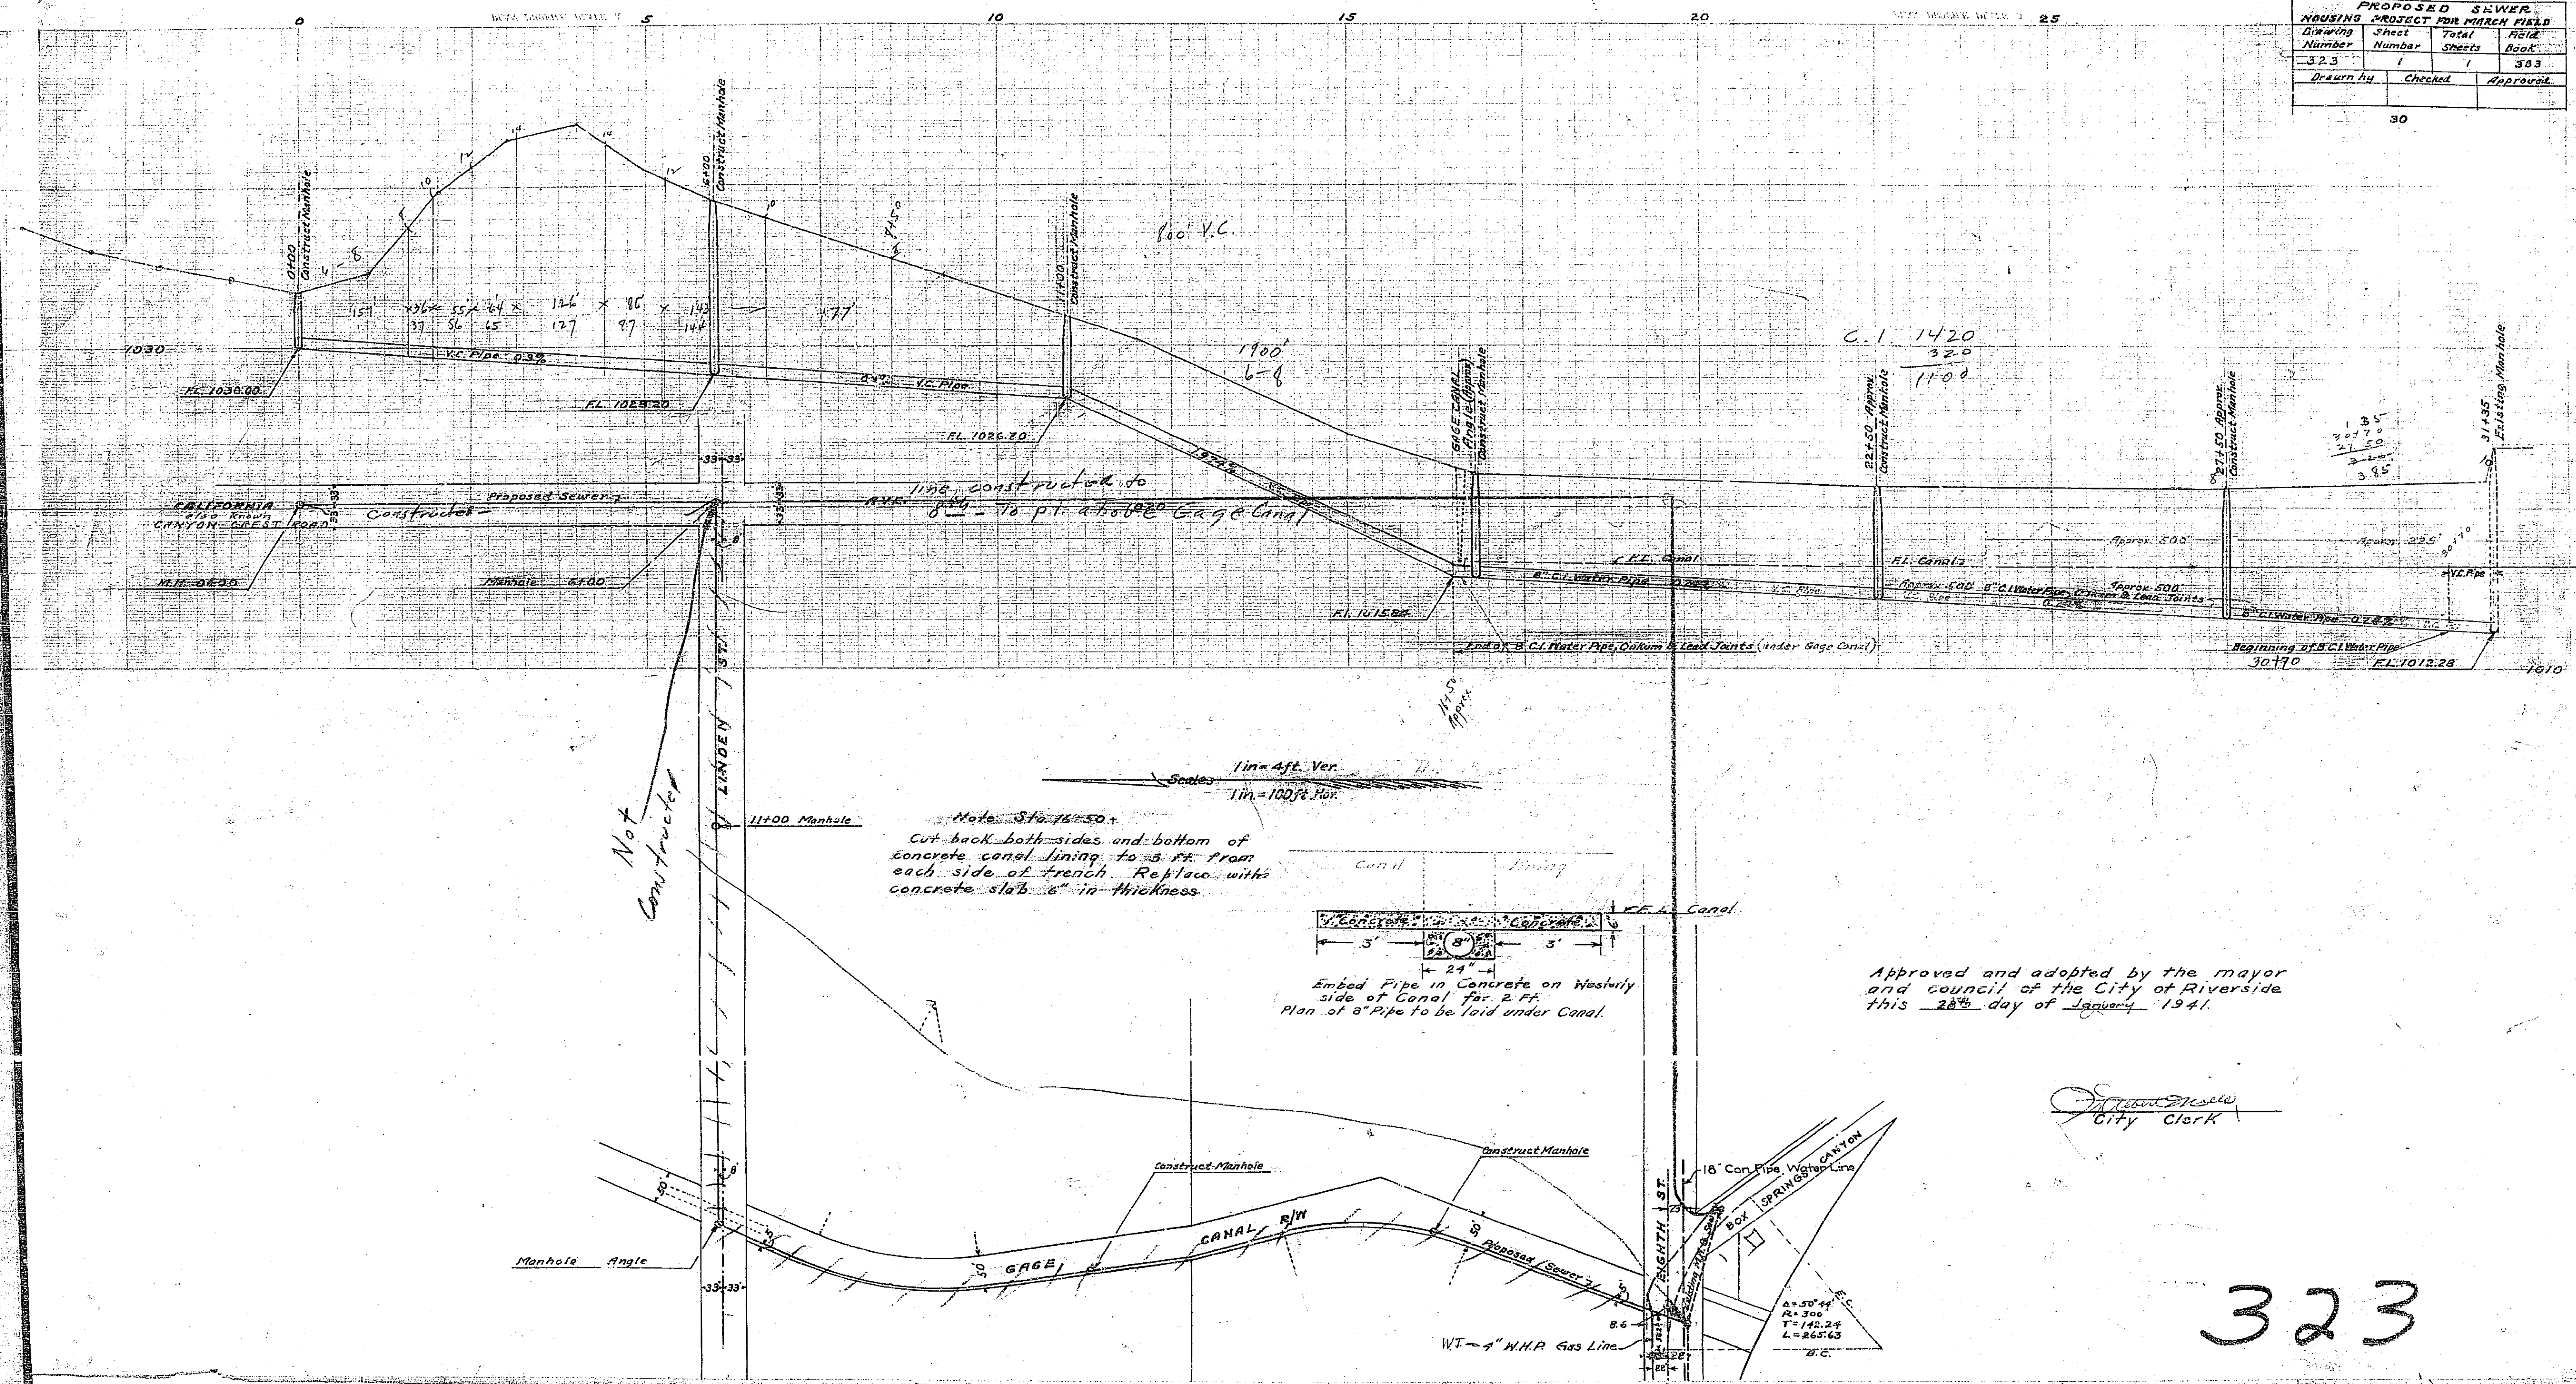

323