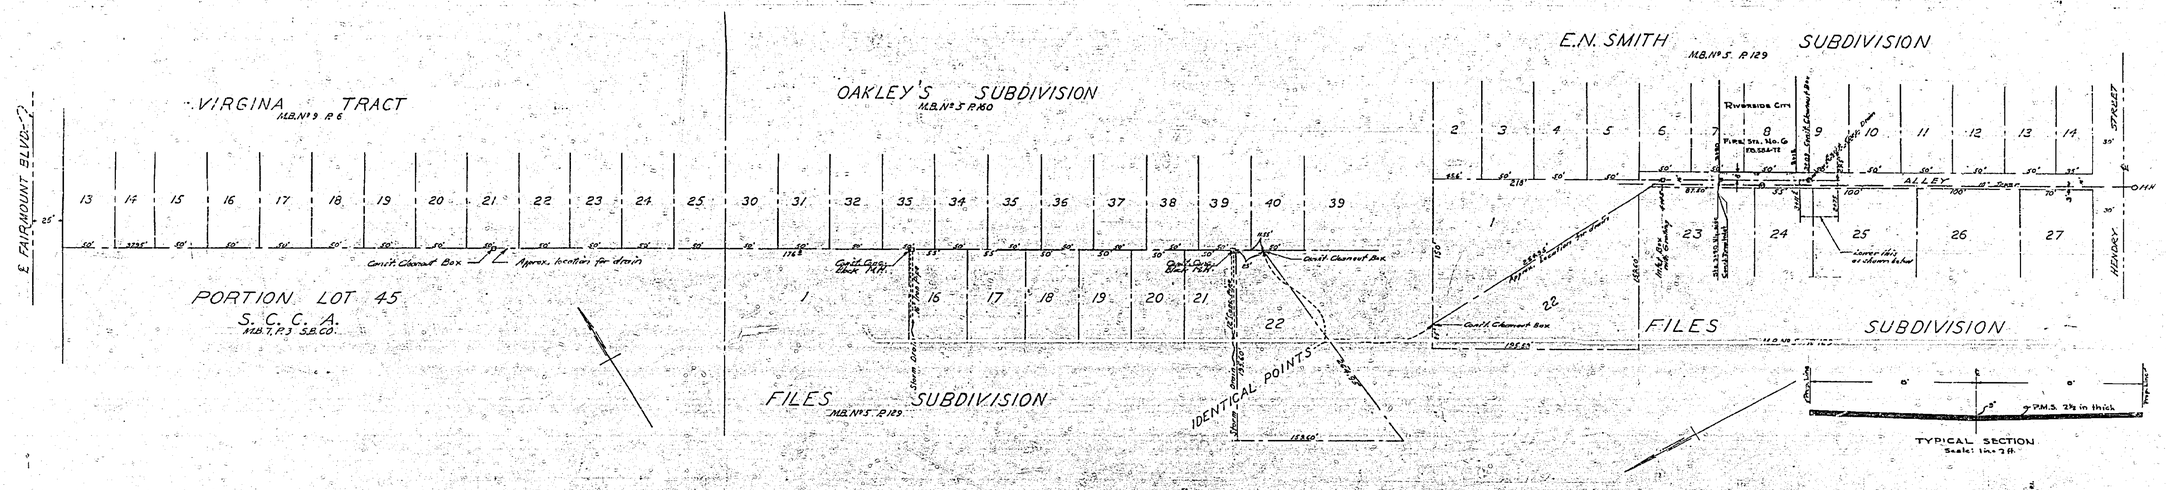

PLAN & PROFILE 113 329-A
FOR THE CONSTRUCTION OF A STORM DRAIN
BETWEEN
MAIN STREET & FAIRMONT BLVD.
NORTH OF HENDRY STREET
P.B. 5-12-50 DEC. 1951.
SCALES HOR. 1in = 40 FT.
VERT. 1in = 4 FT.
APPROVED [illegible]
CITY ENGINEER

Revised Pavement Grades
Station 0+00 - 4+45 Approved Edward J. Taylor Oct. 24, 1956
Assistant City Engineer

329 A