
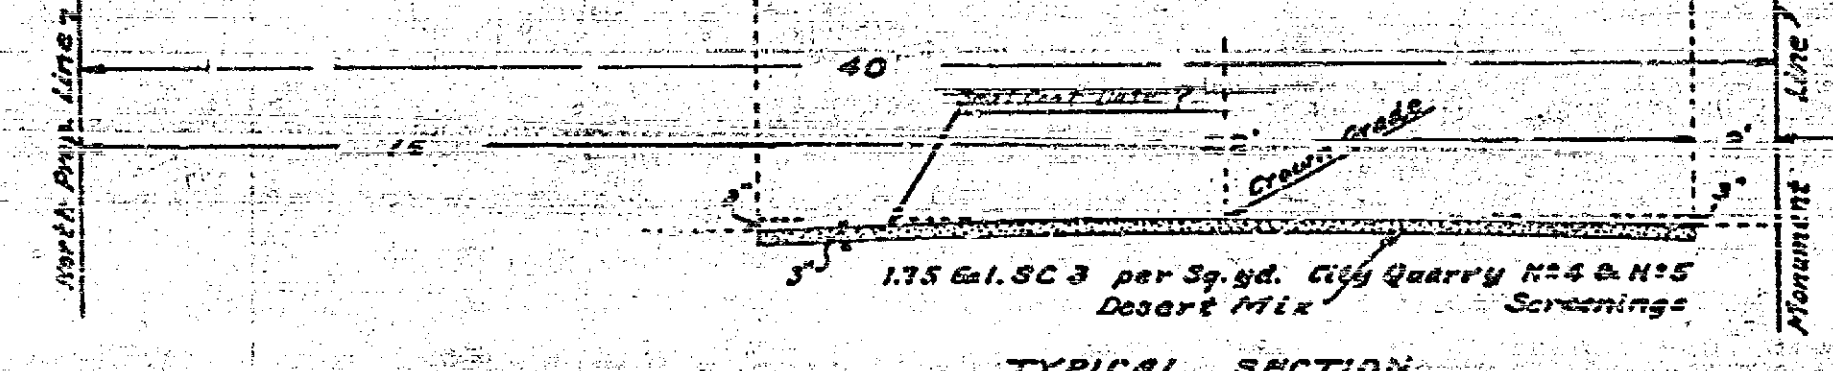


DRAWING NUMBER	SHEET NUMBER	TOTAL SHEETS	FIELD BOOKS
384	1	1	379
DESIGNED BY	CHECKED BY	APPROVED BY	

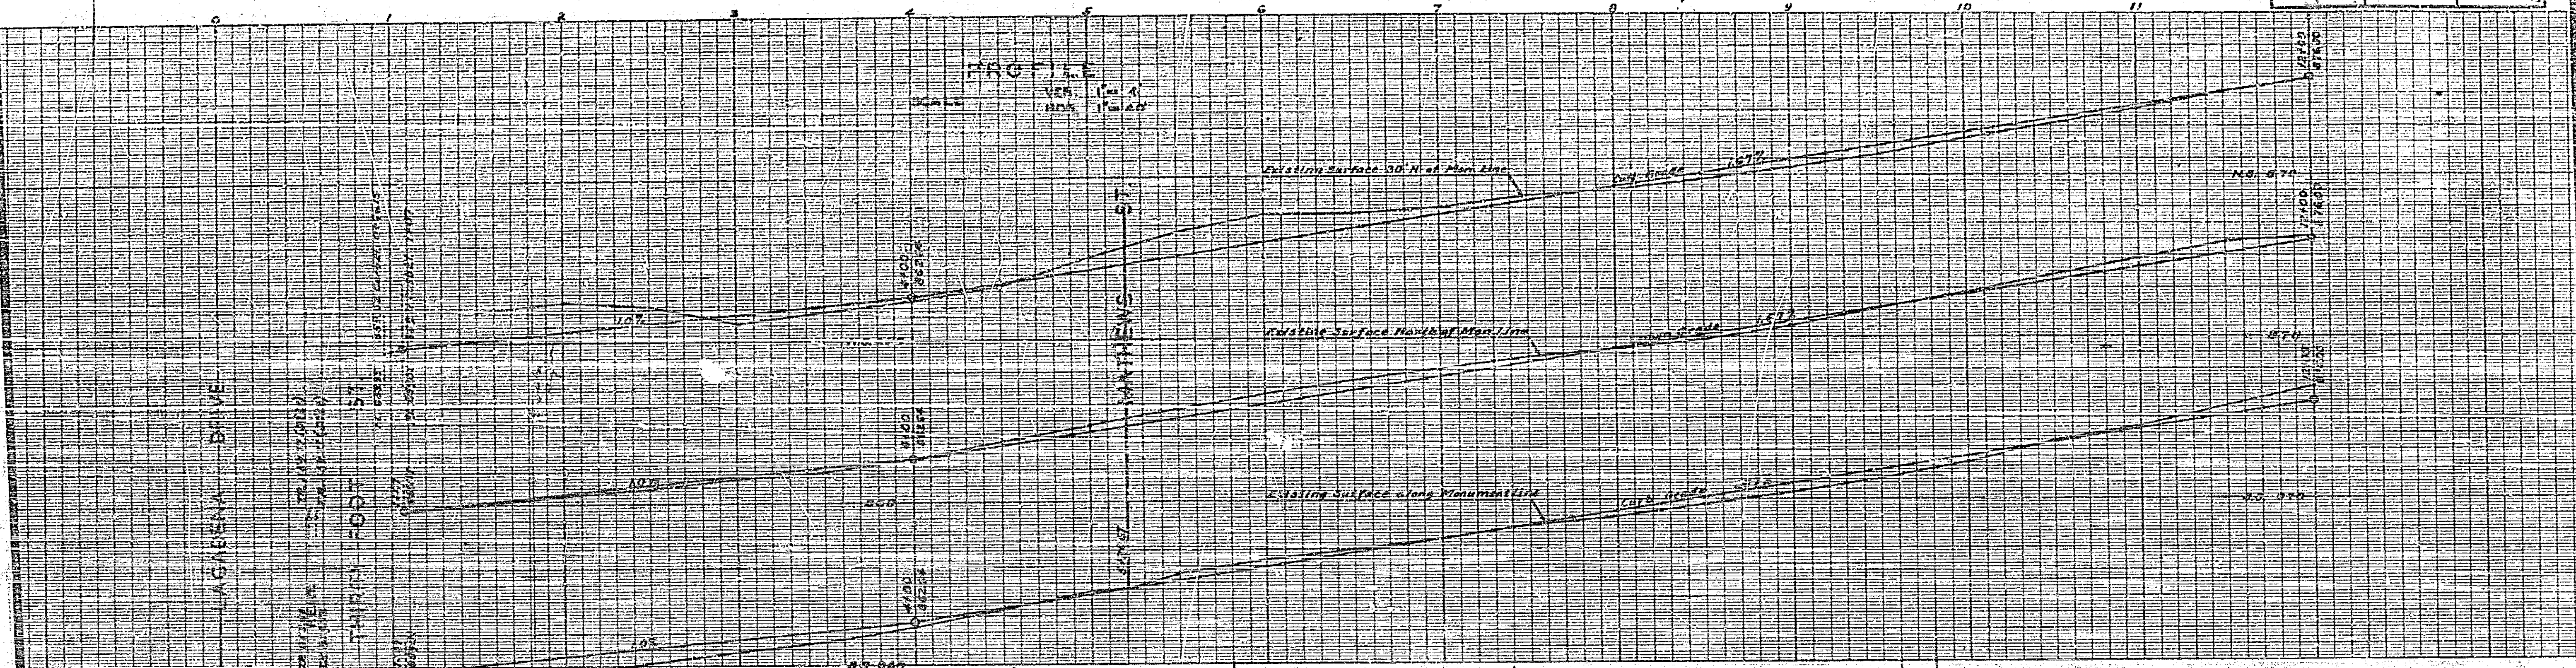


APPROVED
CITY ENGINEER, REG. ENG. 1312

PLAN AND PROFILE OF THE PROPOSED IMPROVEMENT ON THORNTON AVENUE

LACADENA DRIVE TO R.W.CO. CANAL

ENGINEERING DEPT. RIVERSIDE, CALIF. 1941.
CITY (U.S.G.S.) DATUM PLANE
FIELD BOOK 379 PAGES 41-49.

See Cont. Sheet

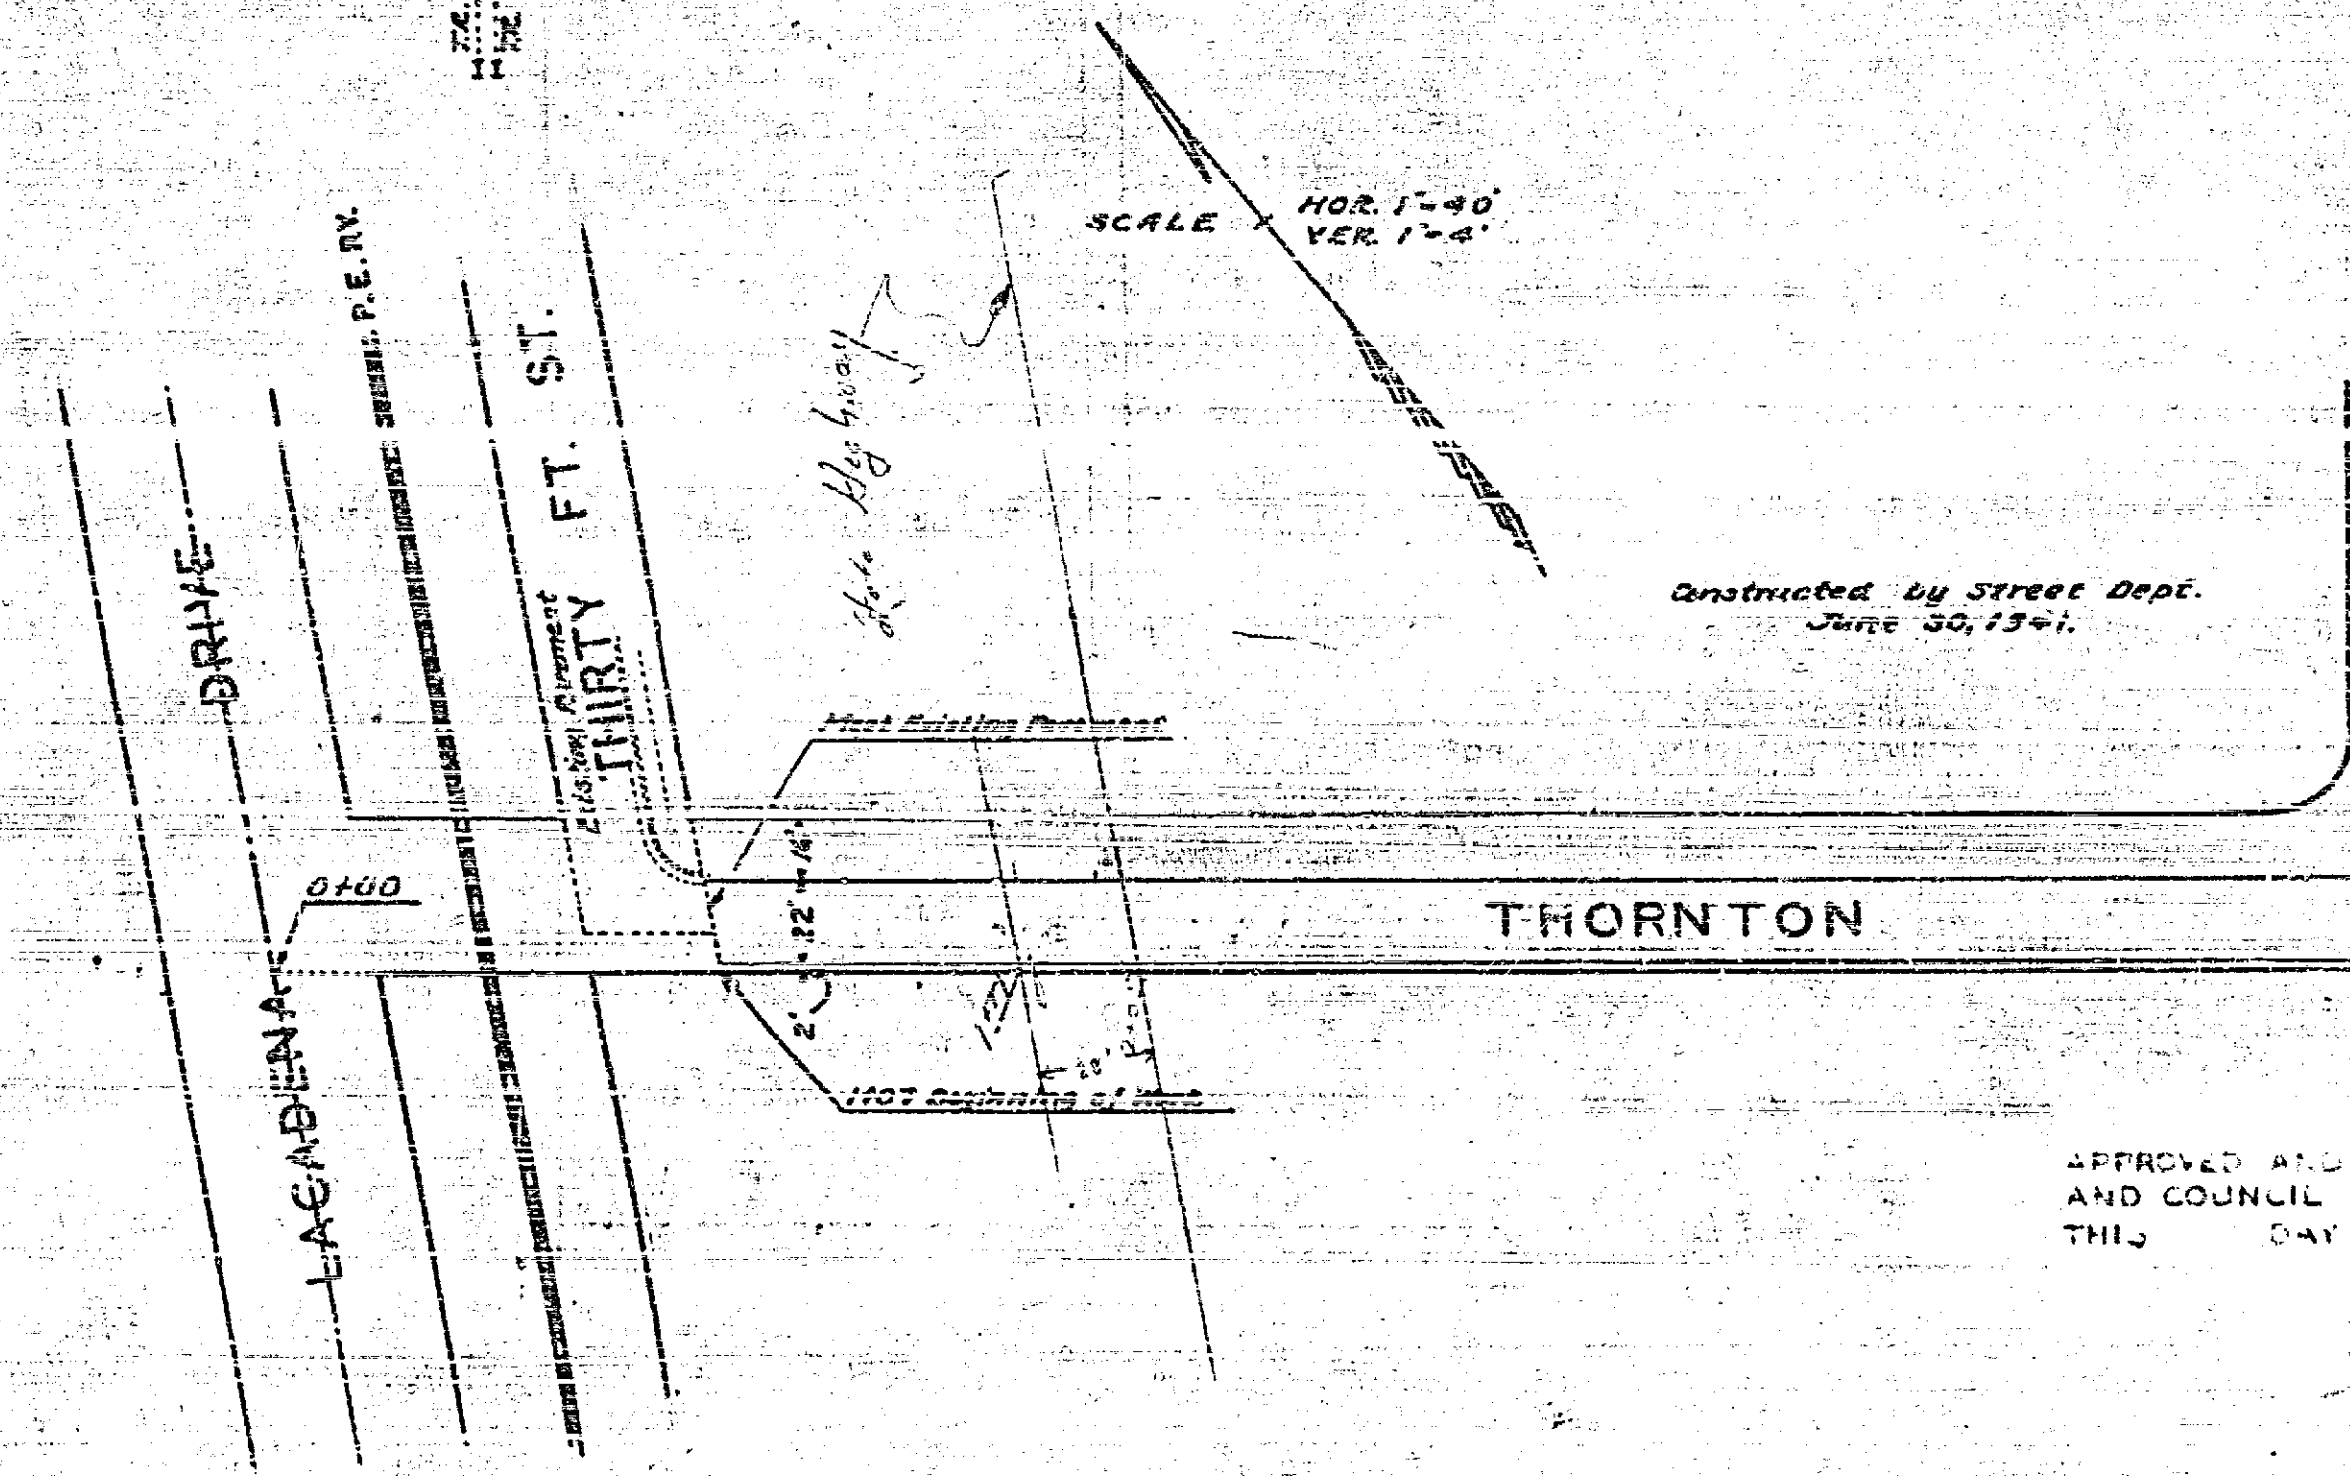

Constructed by Street Dept.
June 30, 1941.

APPROVED AND ADOPTED BY THE MAYOR
AND COUNCIL OF THE CITY OF RIVERSIDE
THIS DAY OF 1941.

CITY ENGINEER, RIVERSIDE, CALIF.

R.W. CO.