


N 61°.00' W
 4.10
 65.10

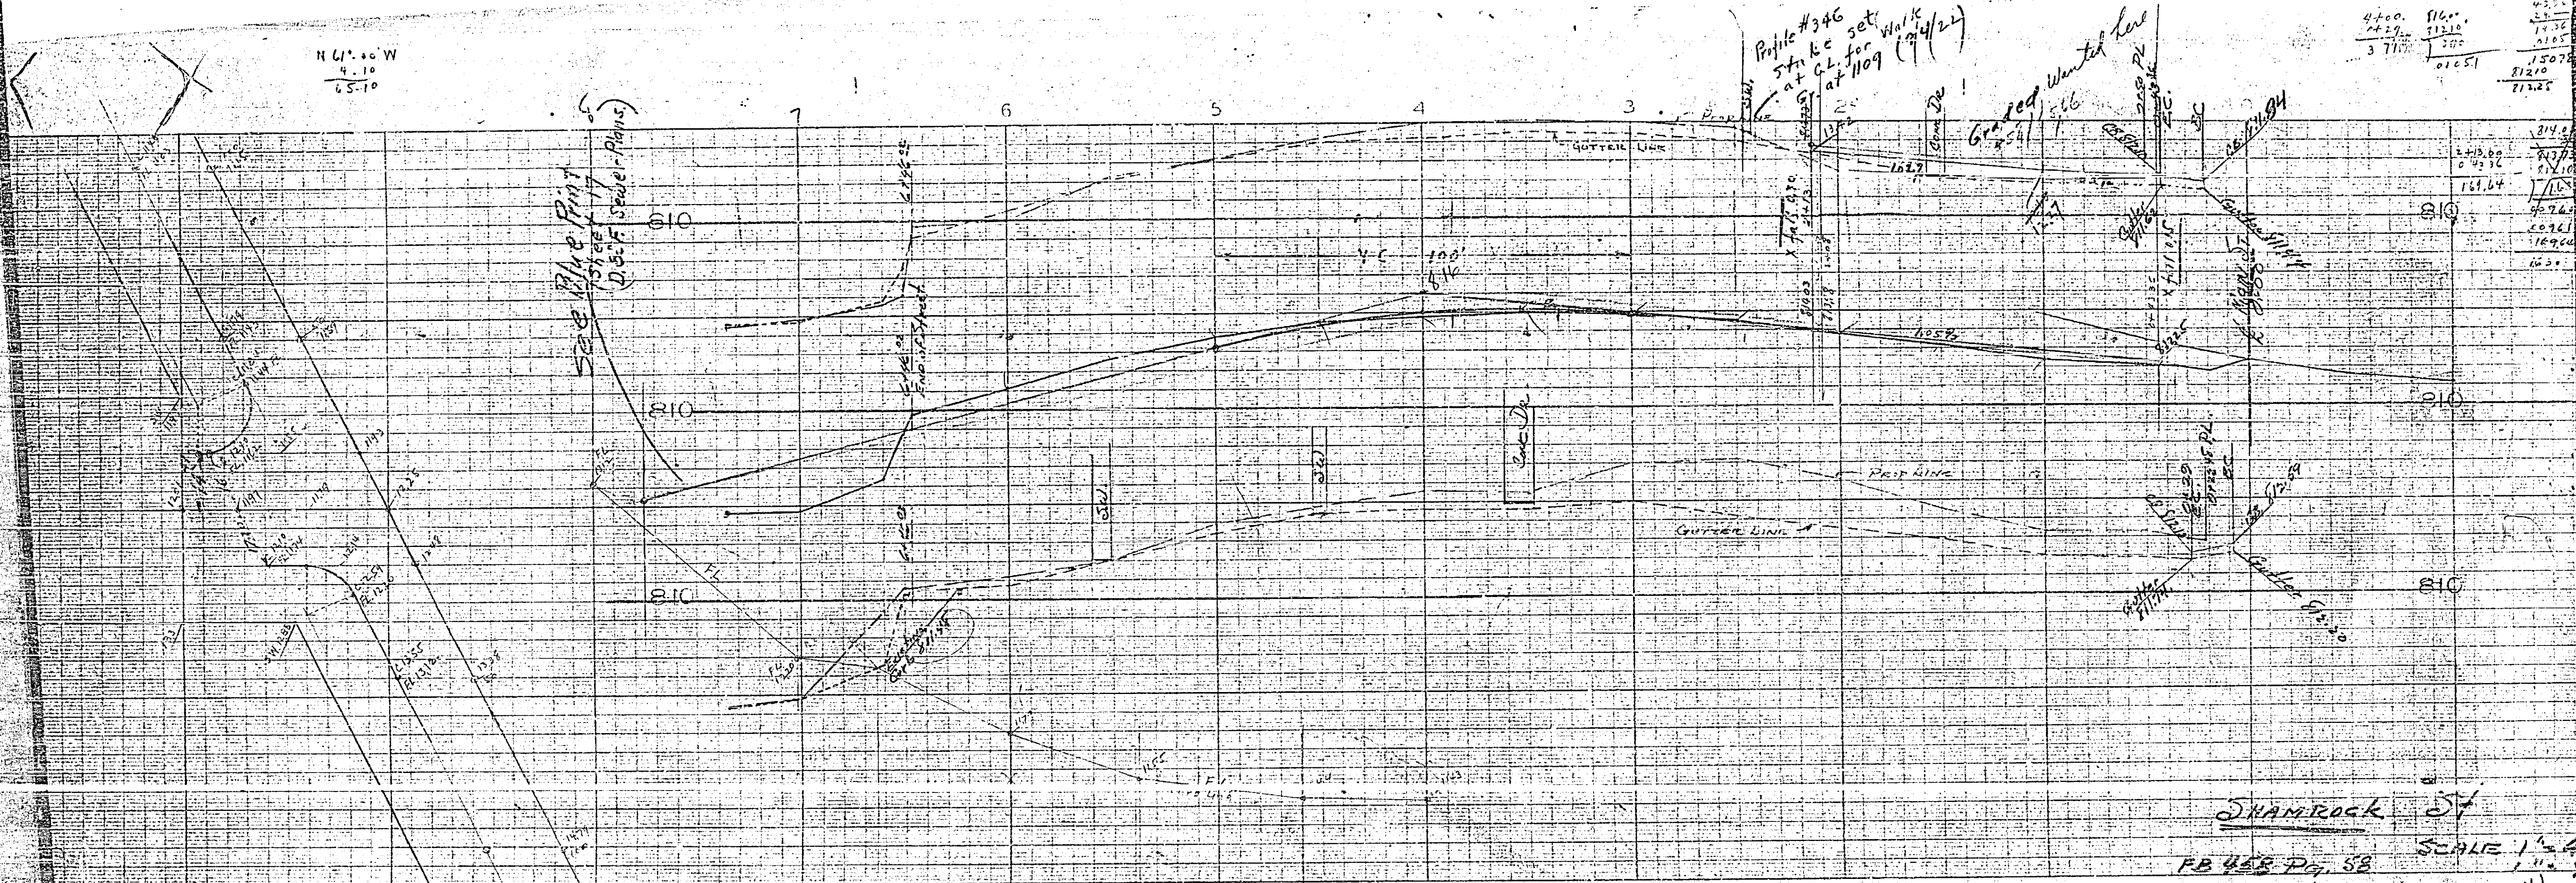

PRINTED IN U.S.A.
 ON 100% RAG PAPER MADE IN U.S.A.

"PERFECT" PROFILE
 PLATE A
 EUGENE DIETZEN CO.

PRINTED IN U.S.A.
 ON 100% RAG PAPER MADE IN U.S.A.

346A

FB 458 Pg. 58
 Staked 4/5/56

SHAMROCK ST
 SCALE 1" = 20'
 File with 346-A