


210 / 2-50

PROFILE  
EAST SEVENTH STREET  
BETWEEN  
CHICAGO AVENUE & KANSAS AVENUE  
JANUARY 1900  
P.B. 210, P. 2-50

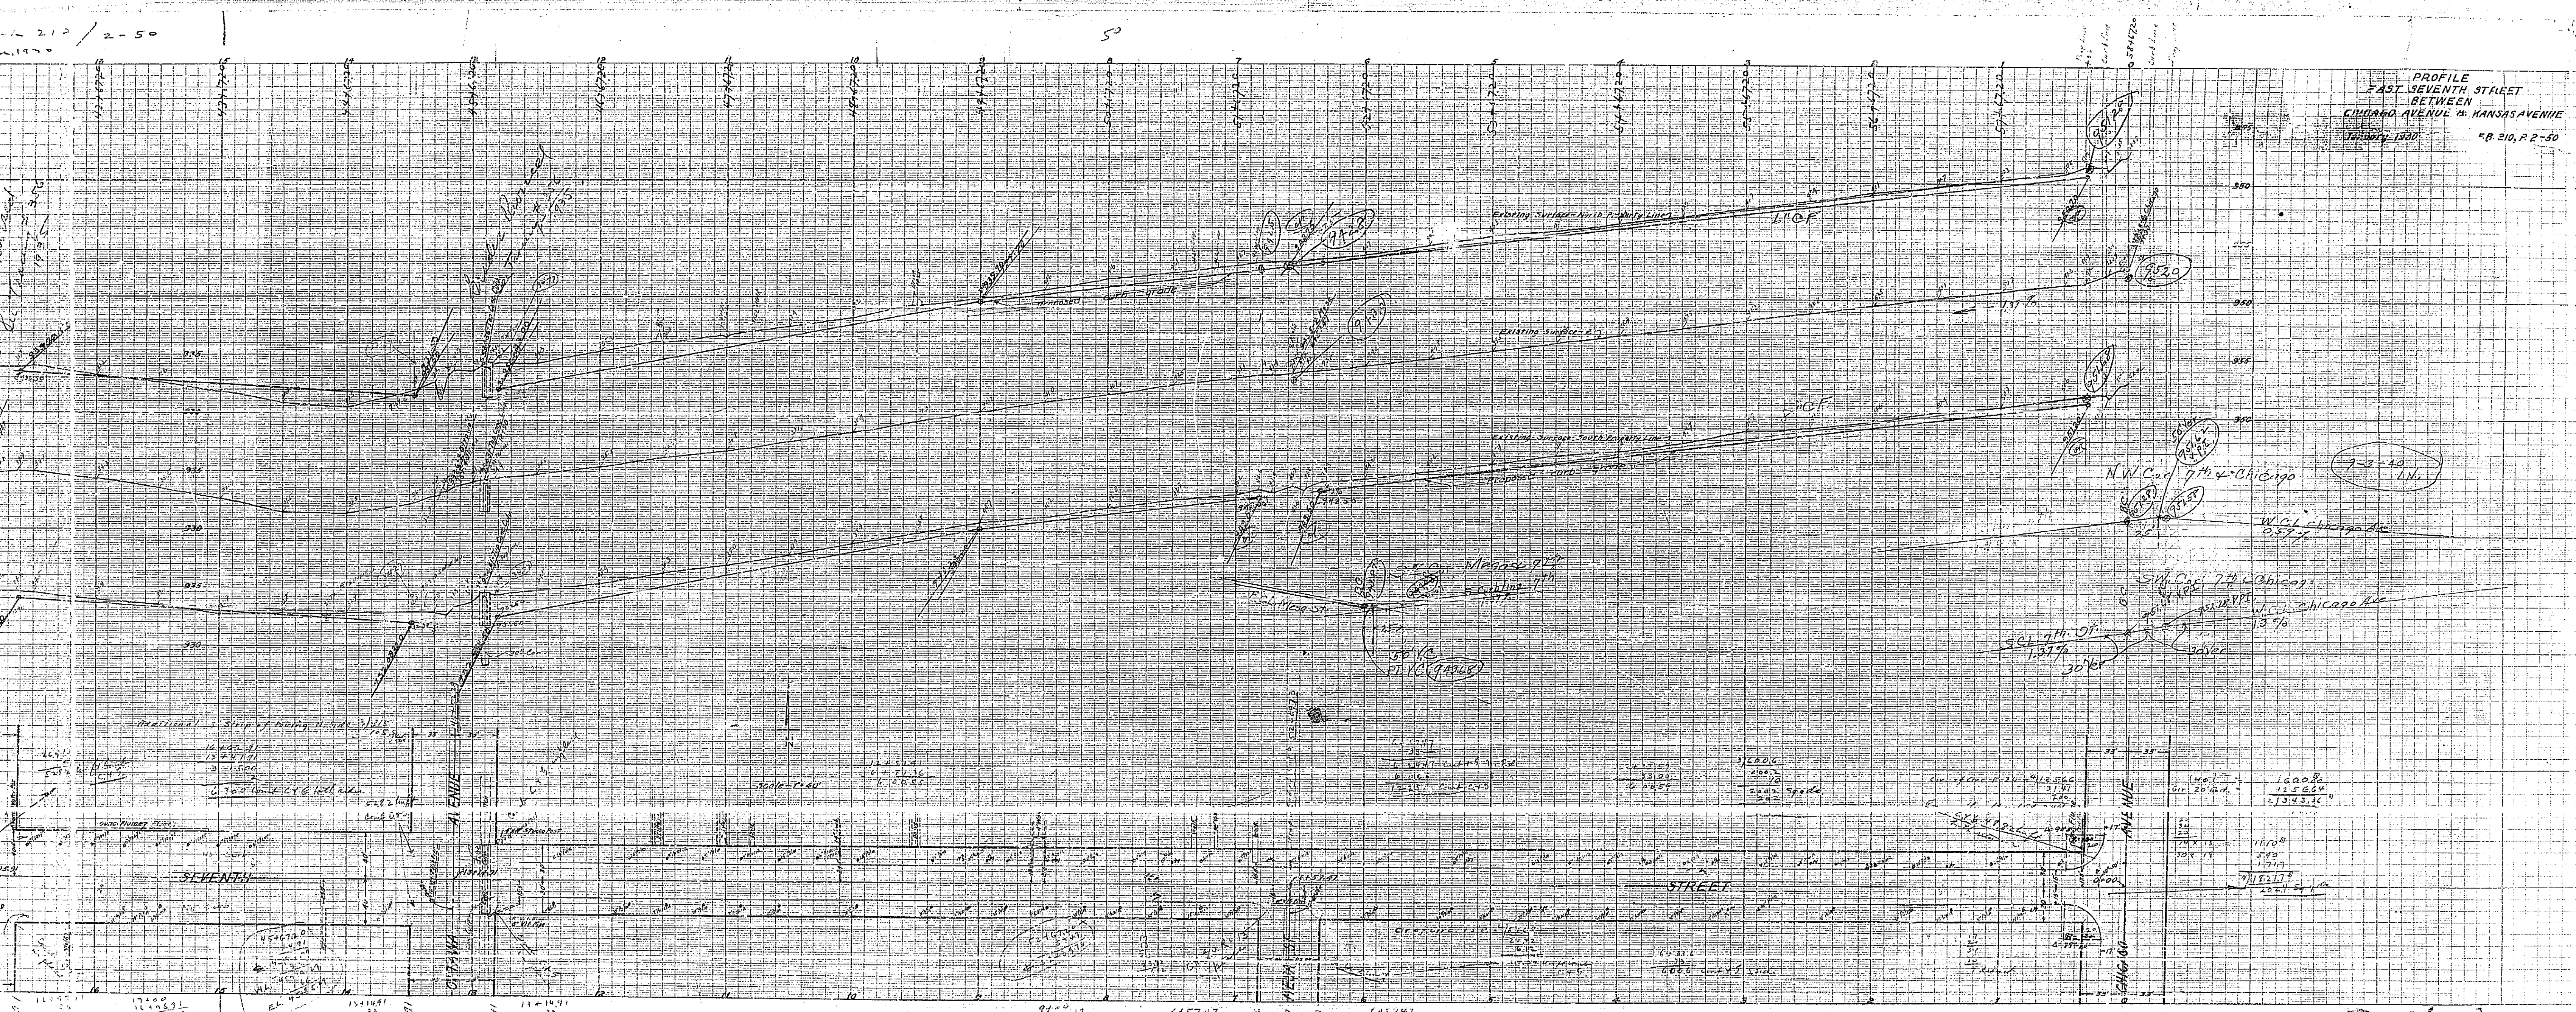

FRAME 1 OF 2 356 A



