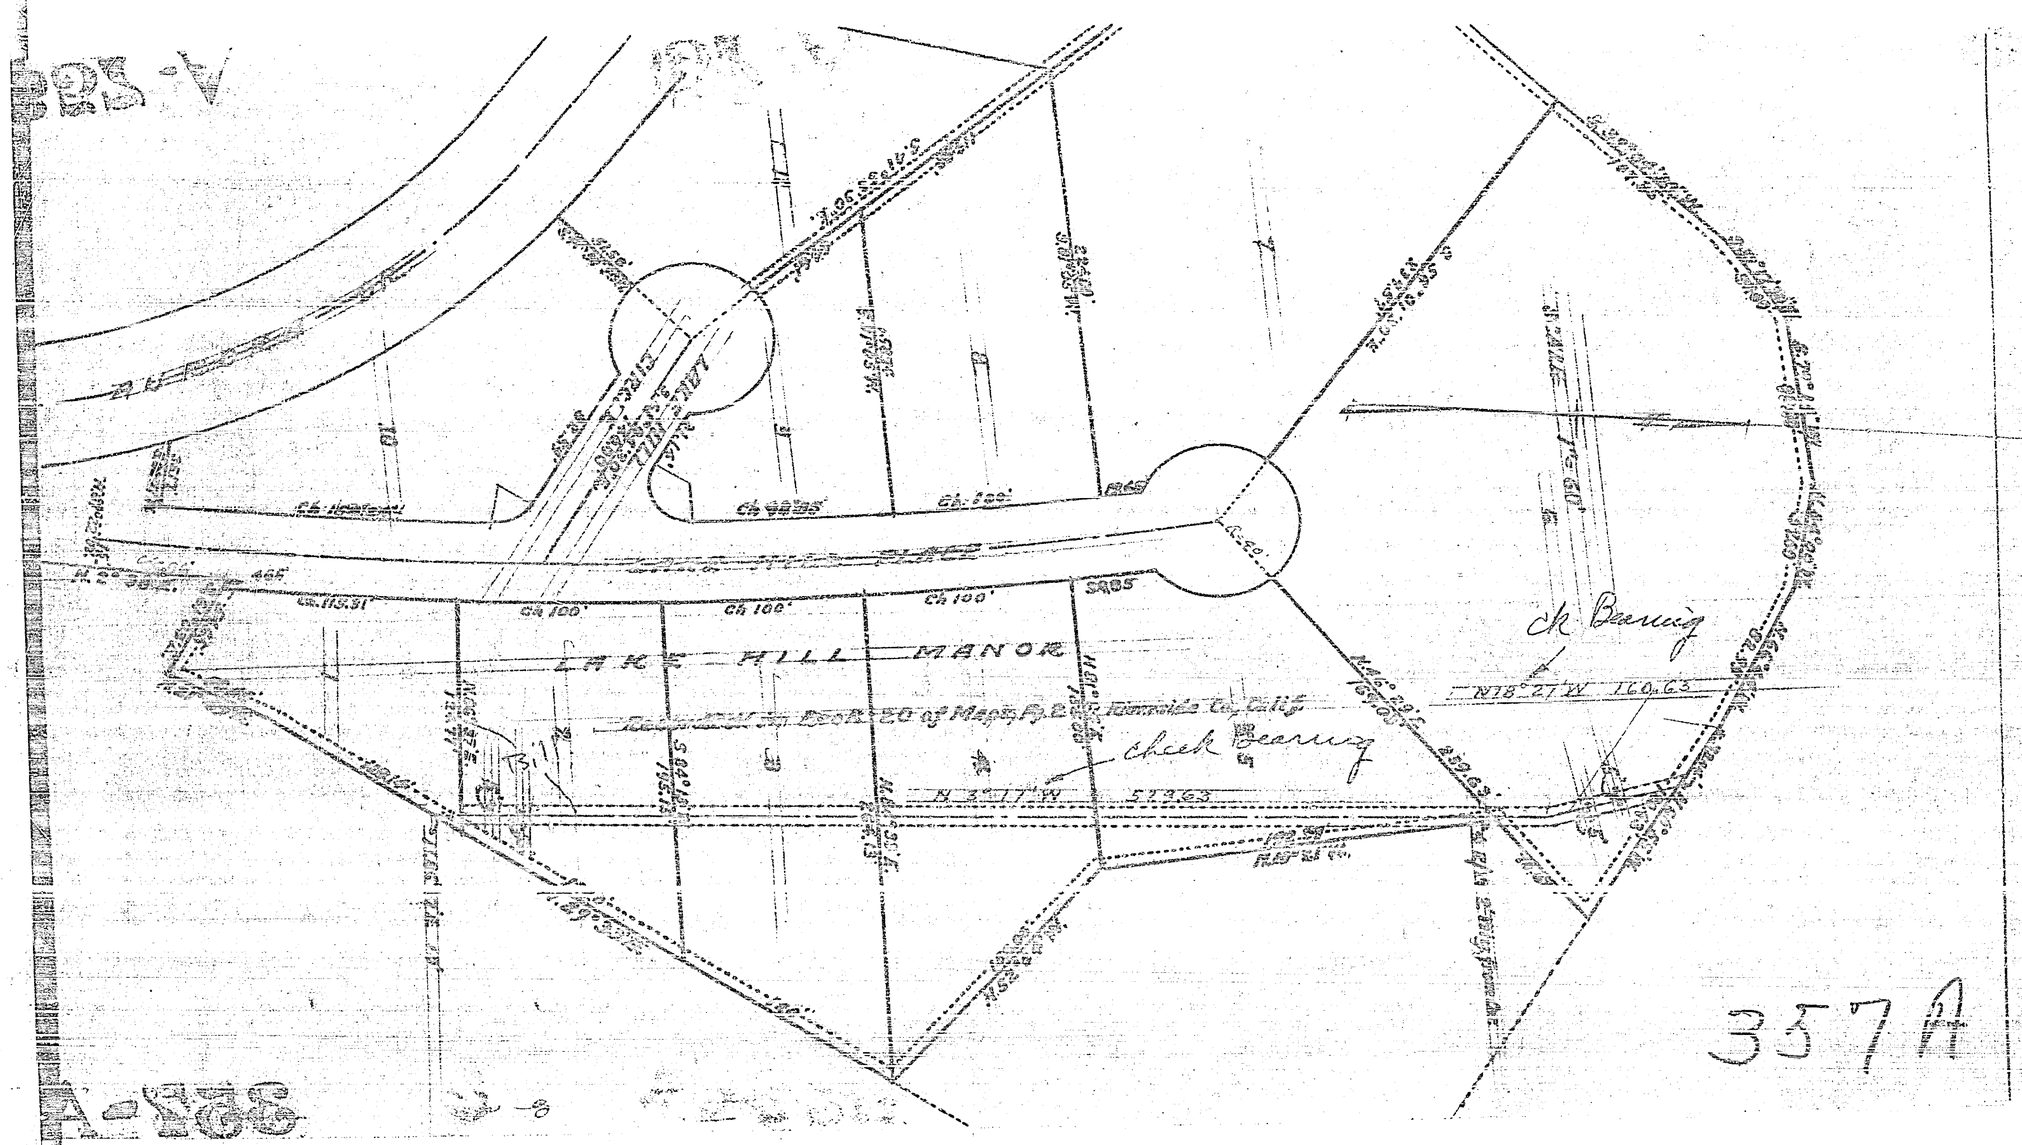
LAKE HILL MANOR
Ch 100'
Ch 100'
Ch 100'
Ch 100'
Ck Bearing
N18°27'W 160.63
Check Bearing
N 3°17'W 579.63
357A