


325-B
357-B

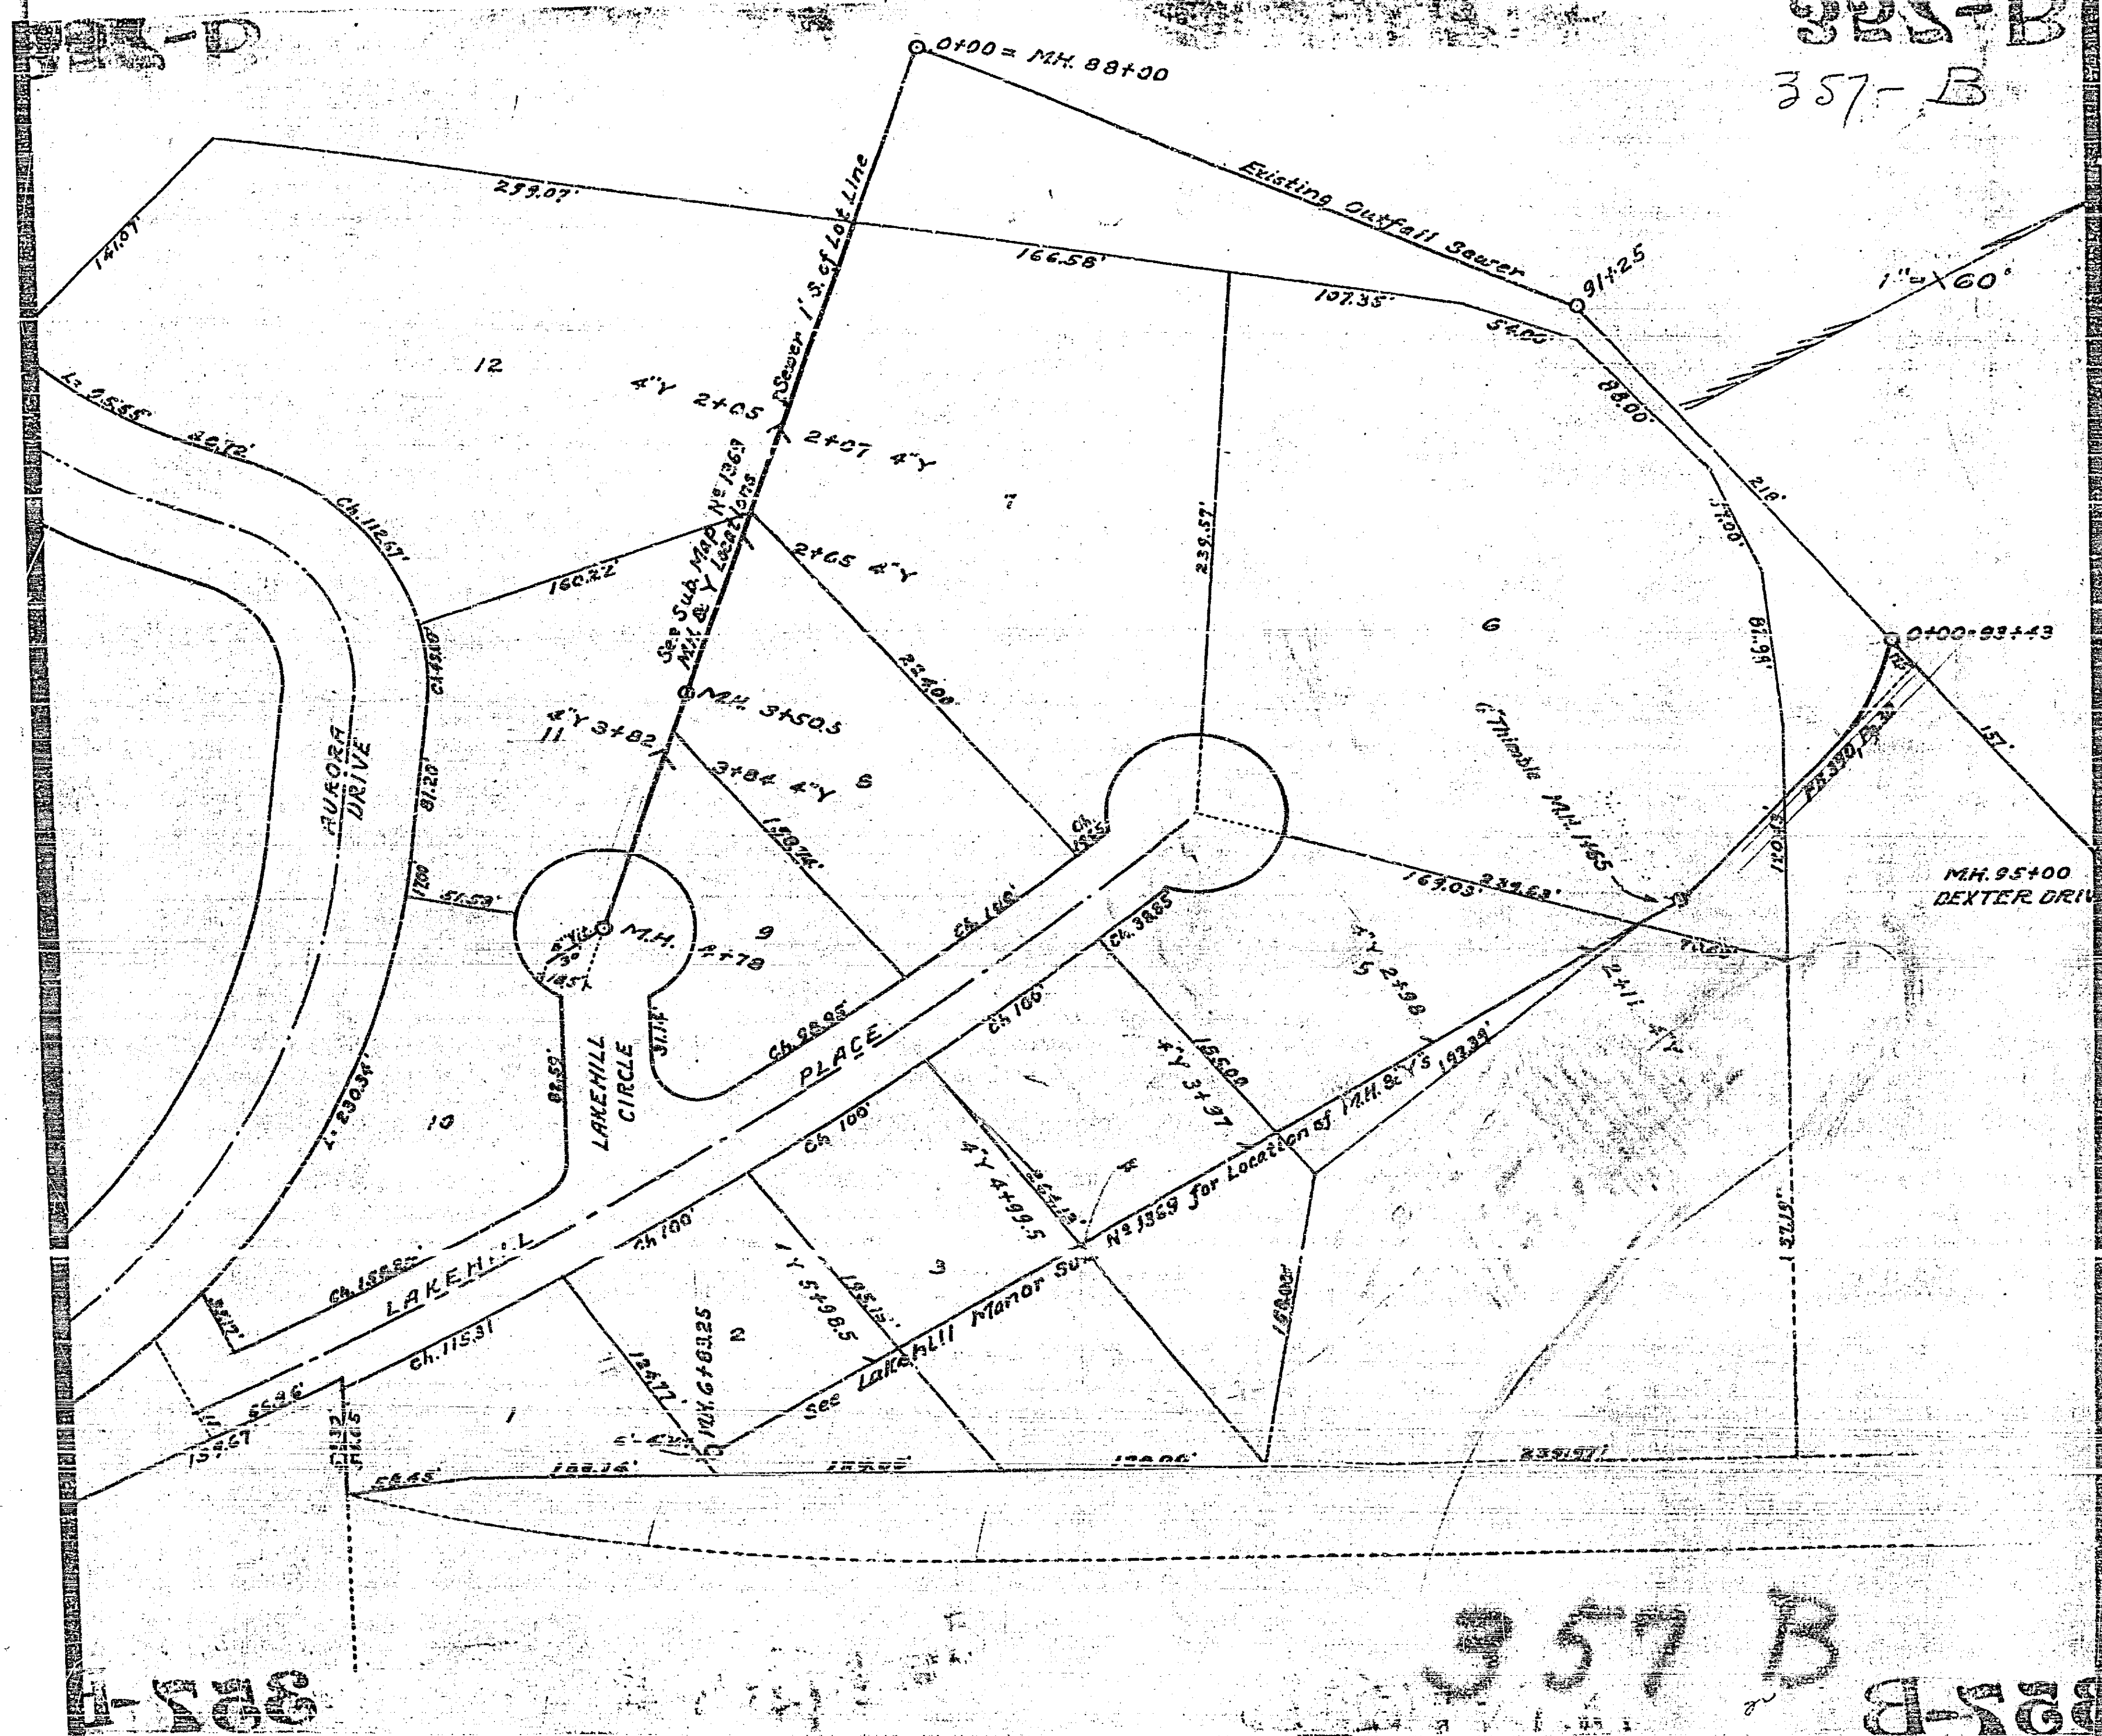

357 B

357-B