


48 V

MAP
SHOWING PRESENT DRAINAGE
DITCH
 FROM MARKET STREET TO THE
 TEQUESQUITE CANAL.
 Scale: 1 inch = 20 feet
 1906

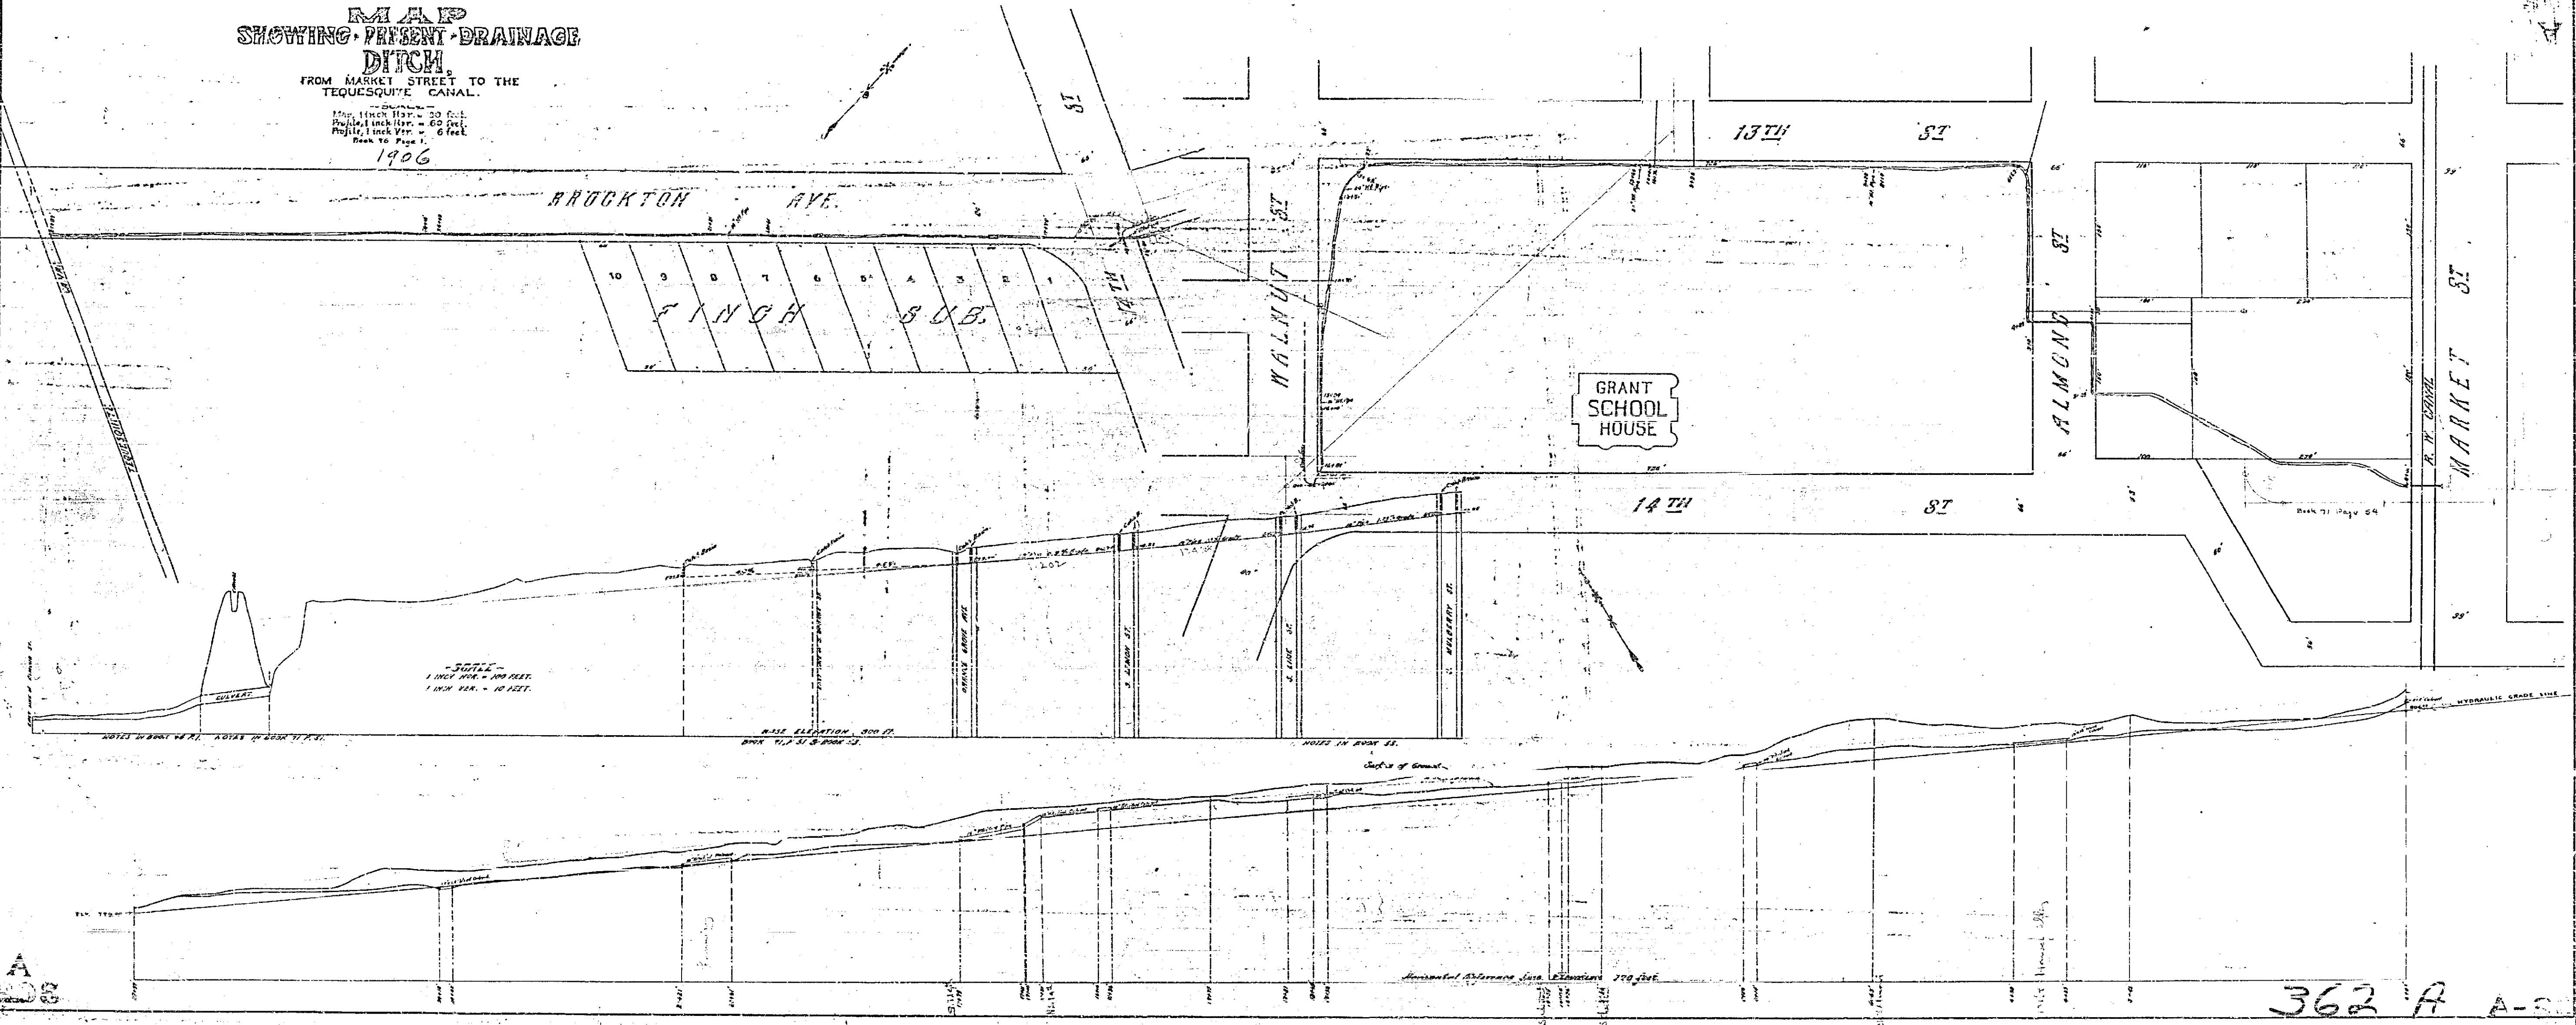

362 A A-2