

PLAN AND PROFILE

OF THE PROPOSED IMPROVEMENT OF

NINTH STREET

BETWEEN WALNUT ST. & PEPPER ST.

ENG. DEPT. CITY OF RIVERSIDE 1935.


CITY (U. S. G.S.) DATUM PLANE

FIELD BOOK 308 PAGES 4-25

Constructed by Street Dept. 1135.


APPROVED AND ADOPTED BY THE MAYOR
AND COUNCIL OF THE CITY OF RIVERSIDE
THIS 4TH DAY OF JUNE 1935.

Frank Rivers
CITY CLERK, CITY OF RIVERSIDE.

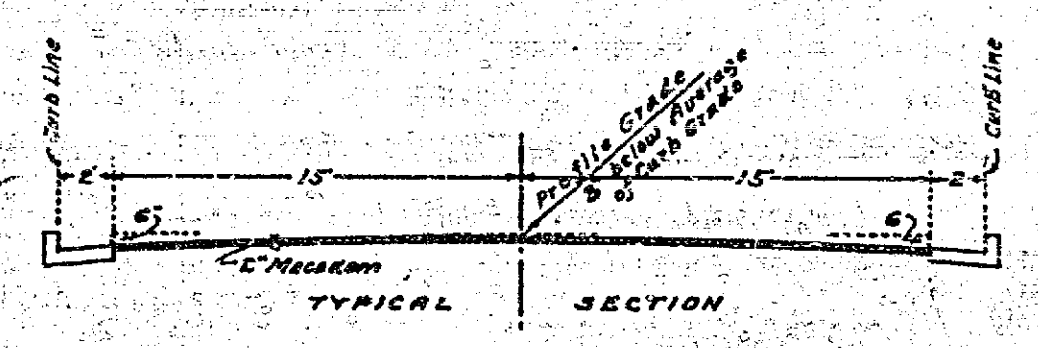

SCALE: HOR. 1"=40'
VER. 1"=4'

PLAN

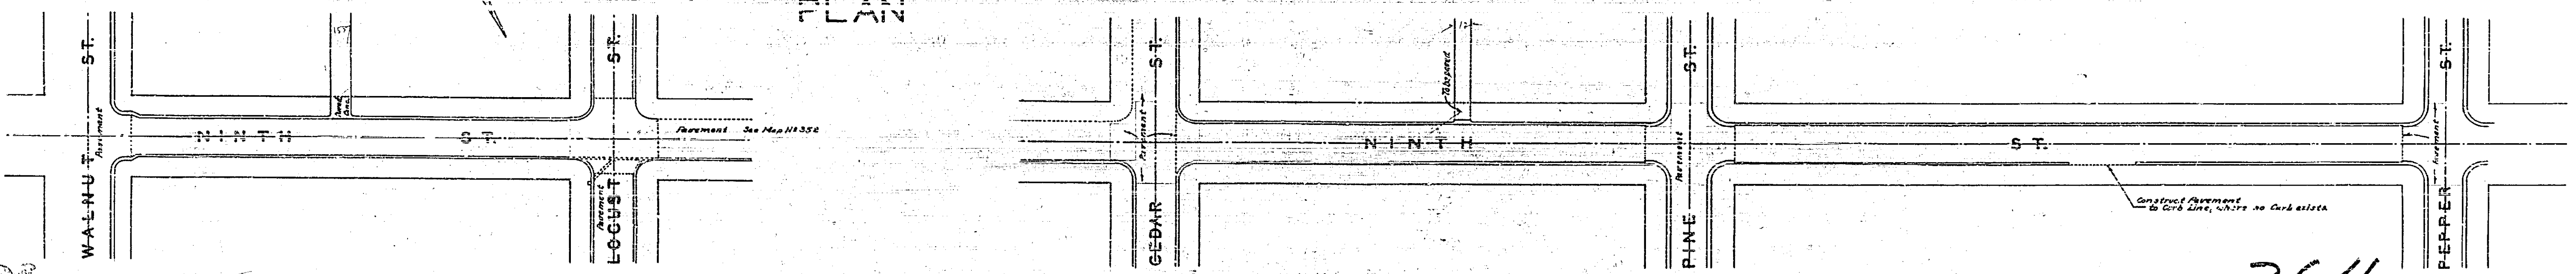

364