


1 inch = 12 ft

Ref # 977 thru paper profile

Profile along Fairmount Blvd.

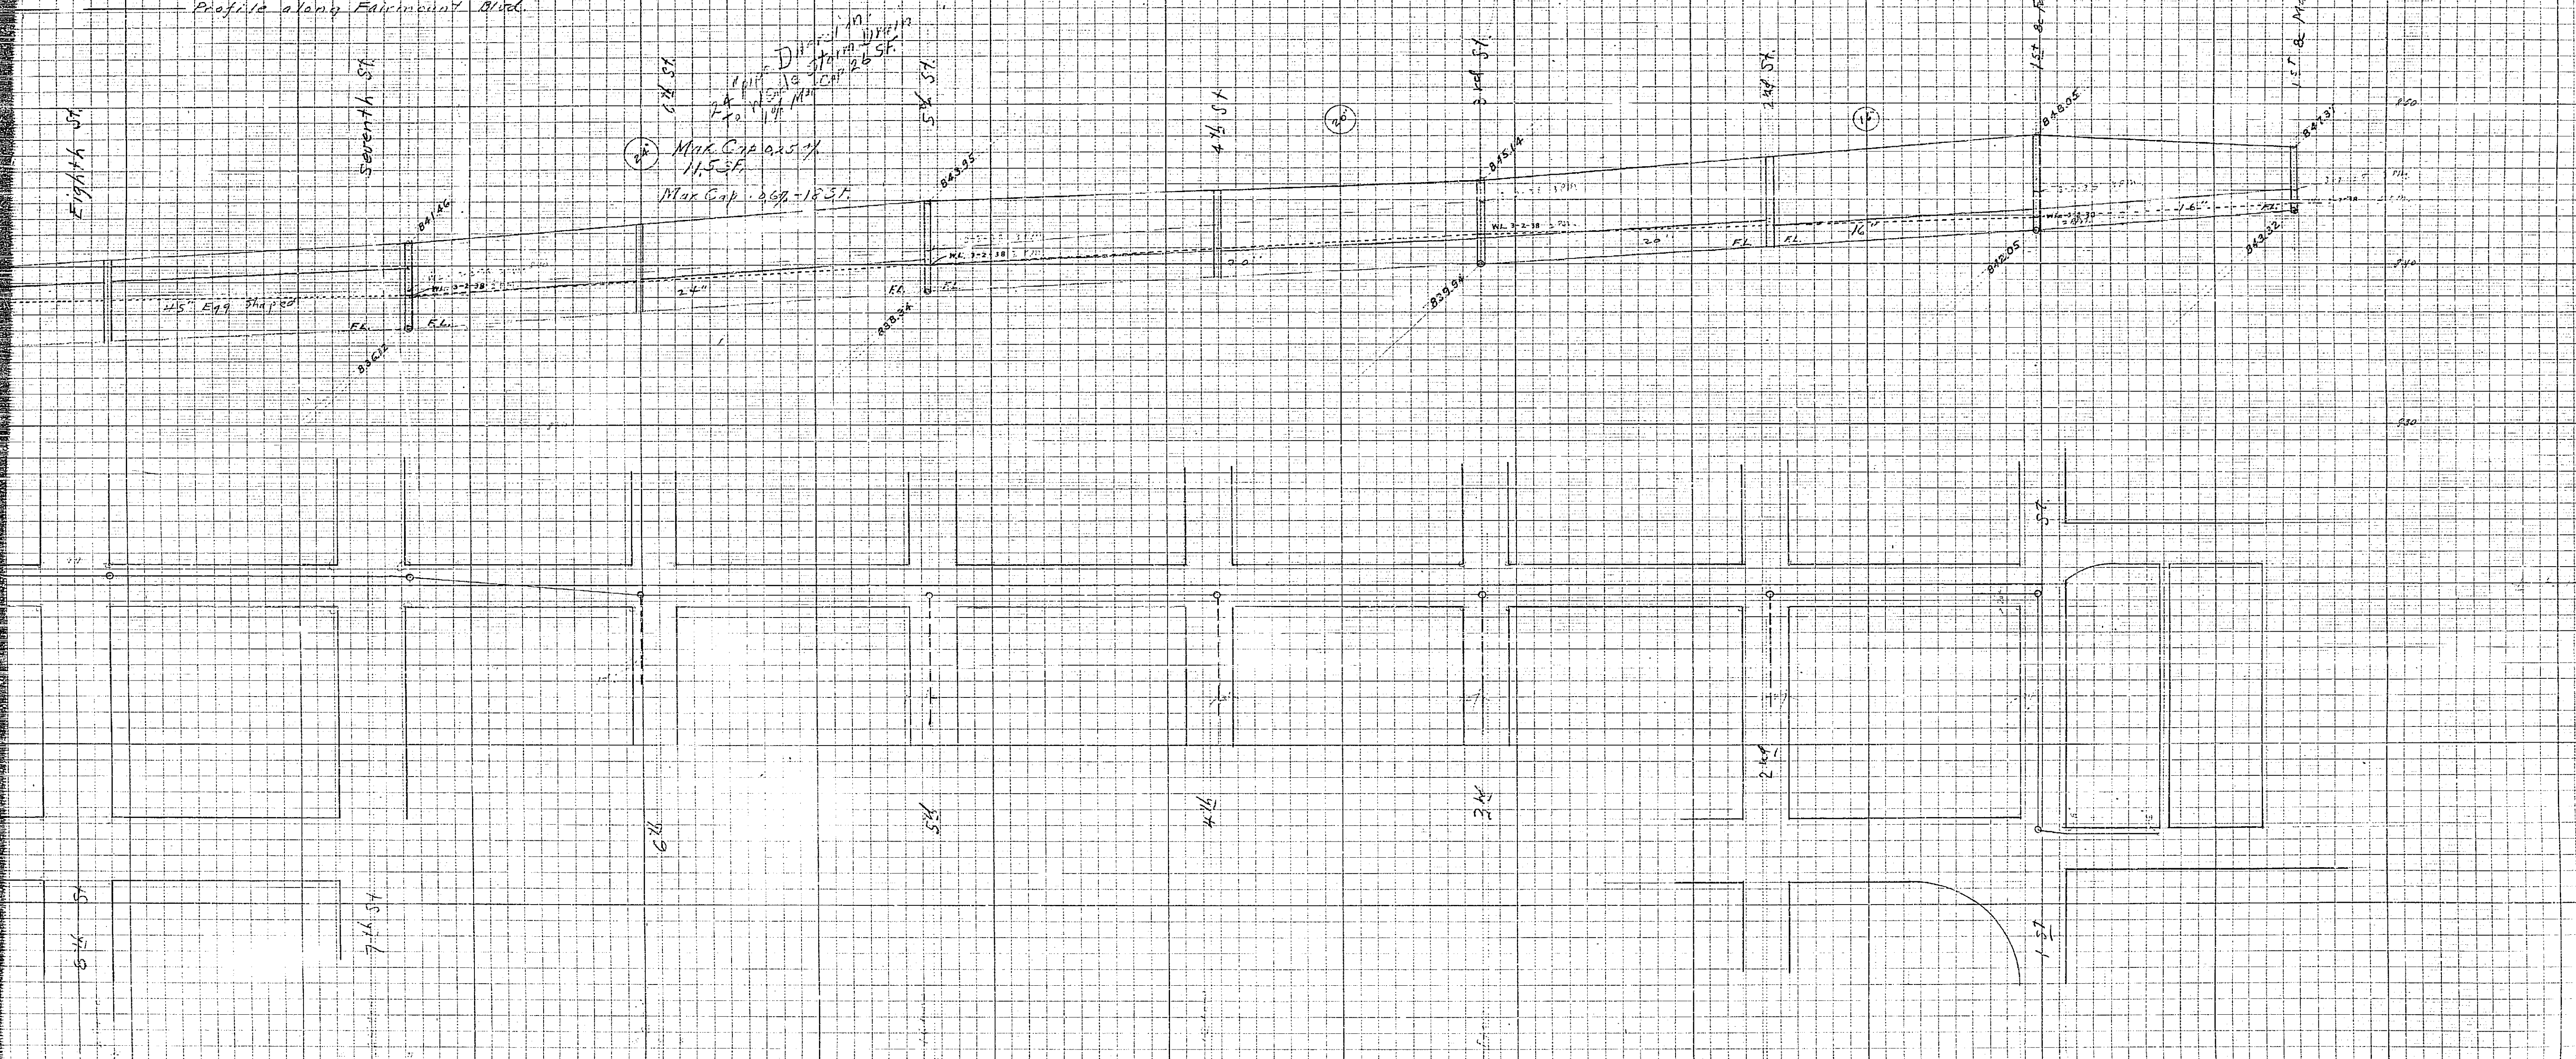


FRAME 1 of 2

Sheet 1

55 50 45 40 35 30 25

Market St. - Fairmount Blvd. 1st St. To Arroyo.
 Market St. - 12th St.
 Riv. Water Co. Canal To Market St.
 BK 3164 Pg. 21-23
 37
 June 1938
 Ref # 977. thin paper profile

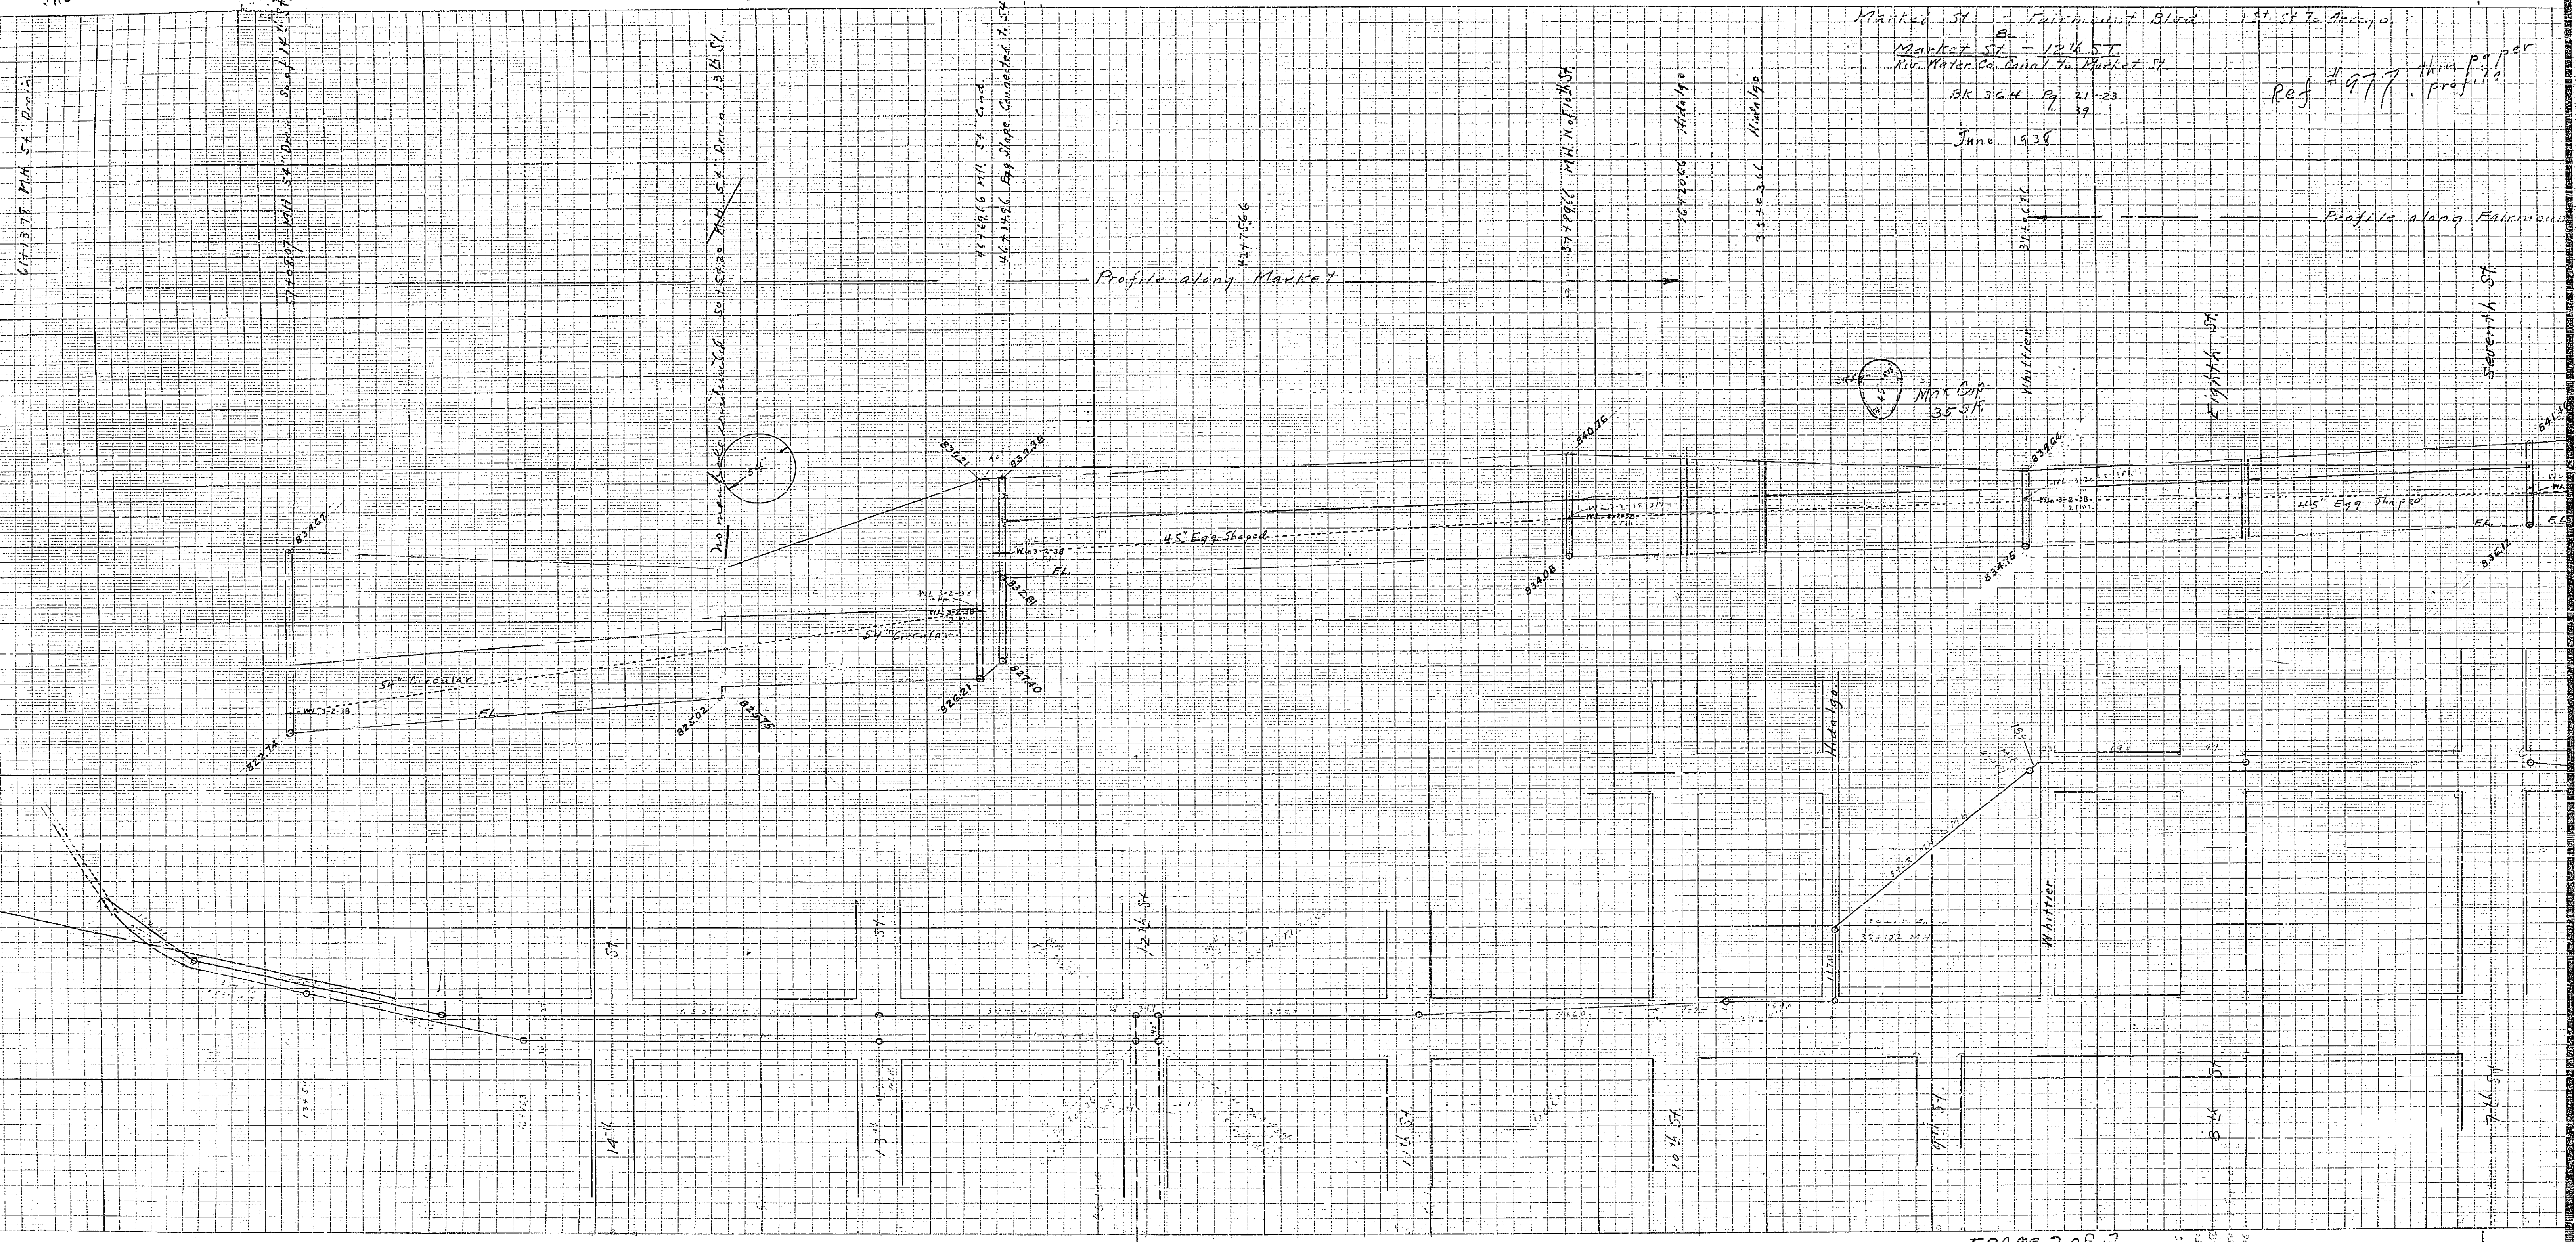

FRAME 2 OF 2

31725
 2725
 405
 2725
 405