

Sheet # 37

BK 364, P 41

June 1938

16+00

Market

ST

M.H. 1914

82621


82633

M.H. 1914

82621

82633


82641

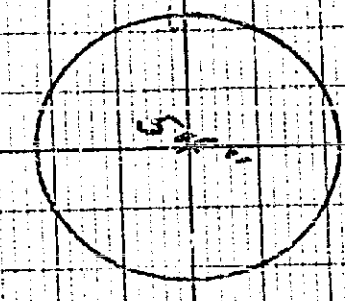

+57.24

Main

ST

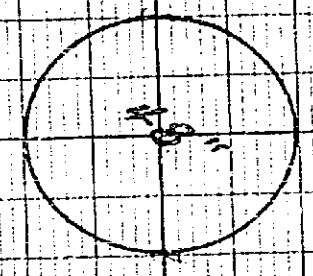

21

+2+60

M.H.

82610

82610

82621

+170.62

Orange

ST

82139

82139

82914

82914

82224

6

37-A

+4673

Lenox

ST