


MAP OF PROPOSED SEWER IN
E. 13TH ST.,
 FROM HOWARD AVE EASTERLY
 PROPERTY BENEFITED BOUNDED BY A GREEN LINE THUS:-----

SCALE --- 1 IN. HOR. = 60 FT. --- 1 IN. VER. = 6 FT.

A.P. Campbell,
 City Engineer.

Ord 7.33

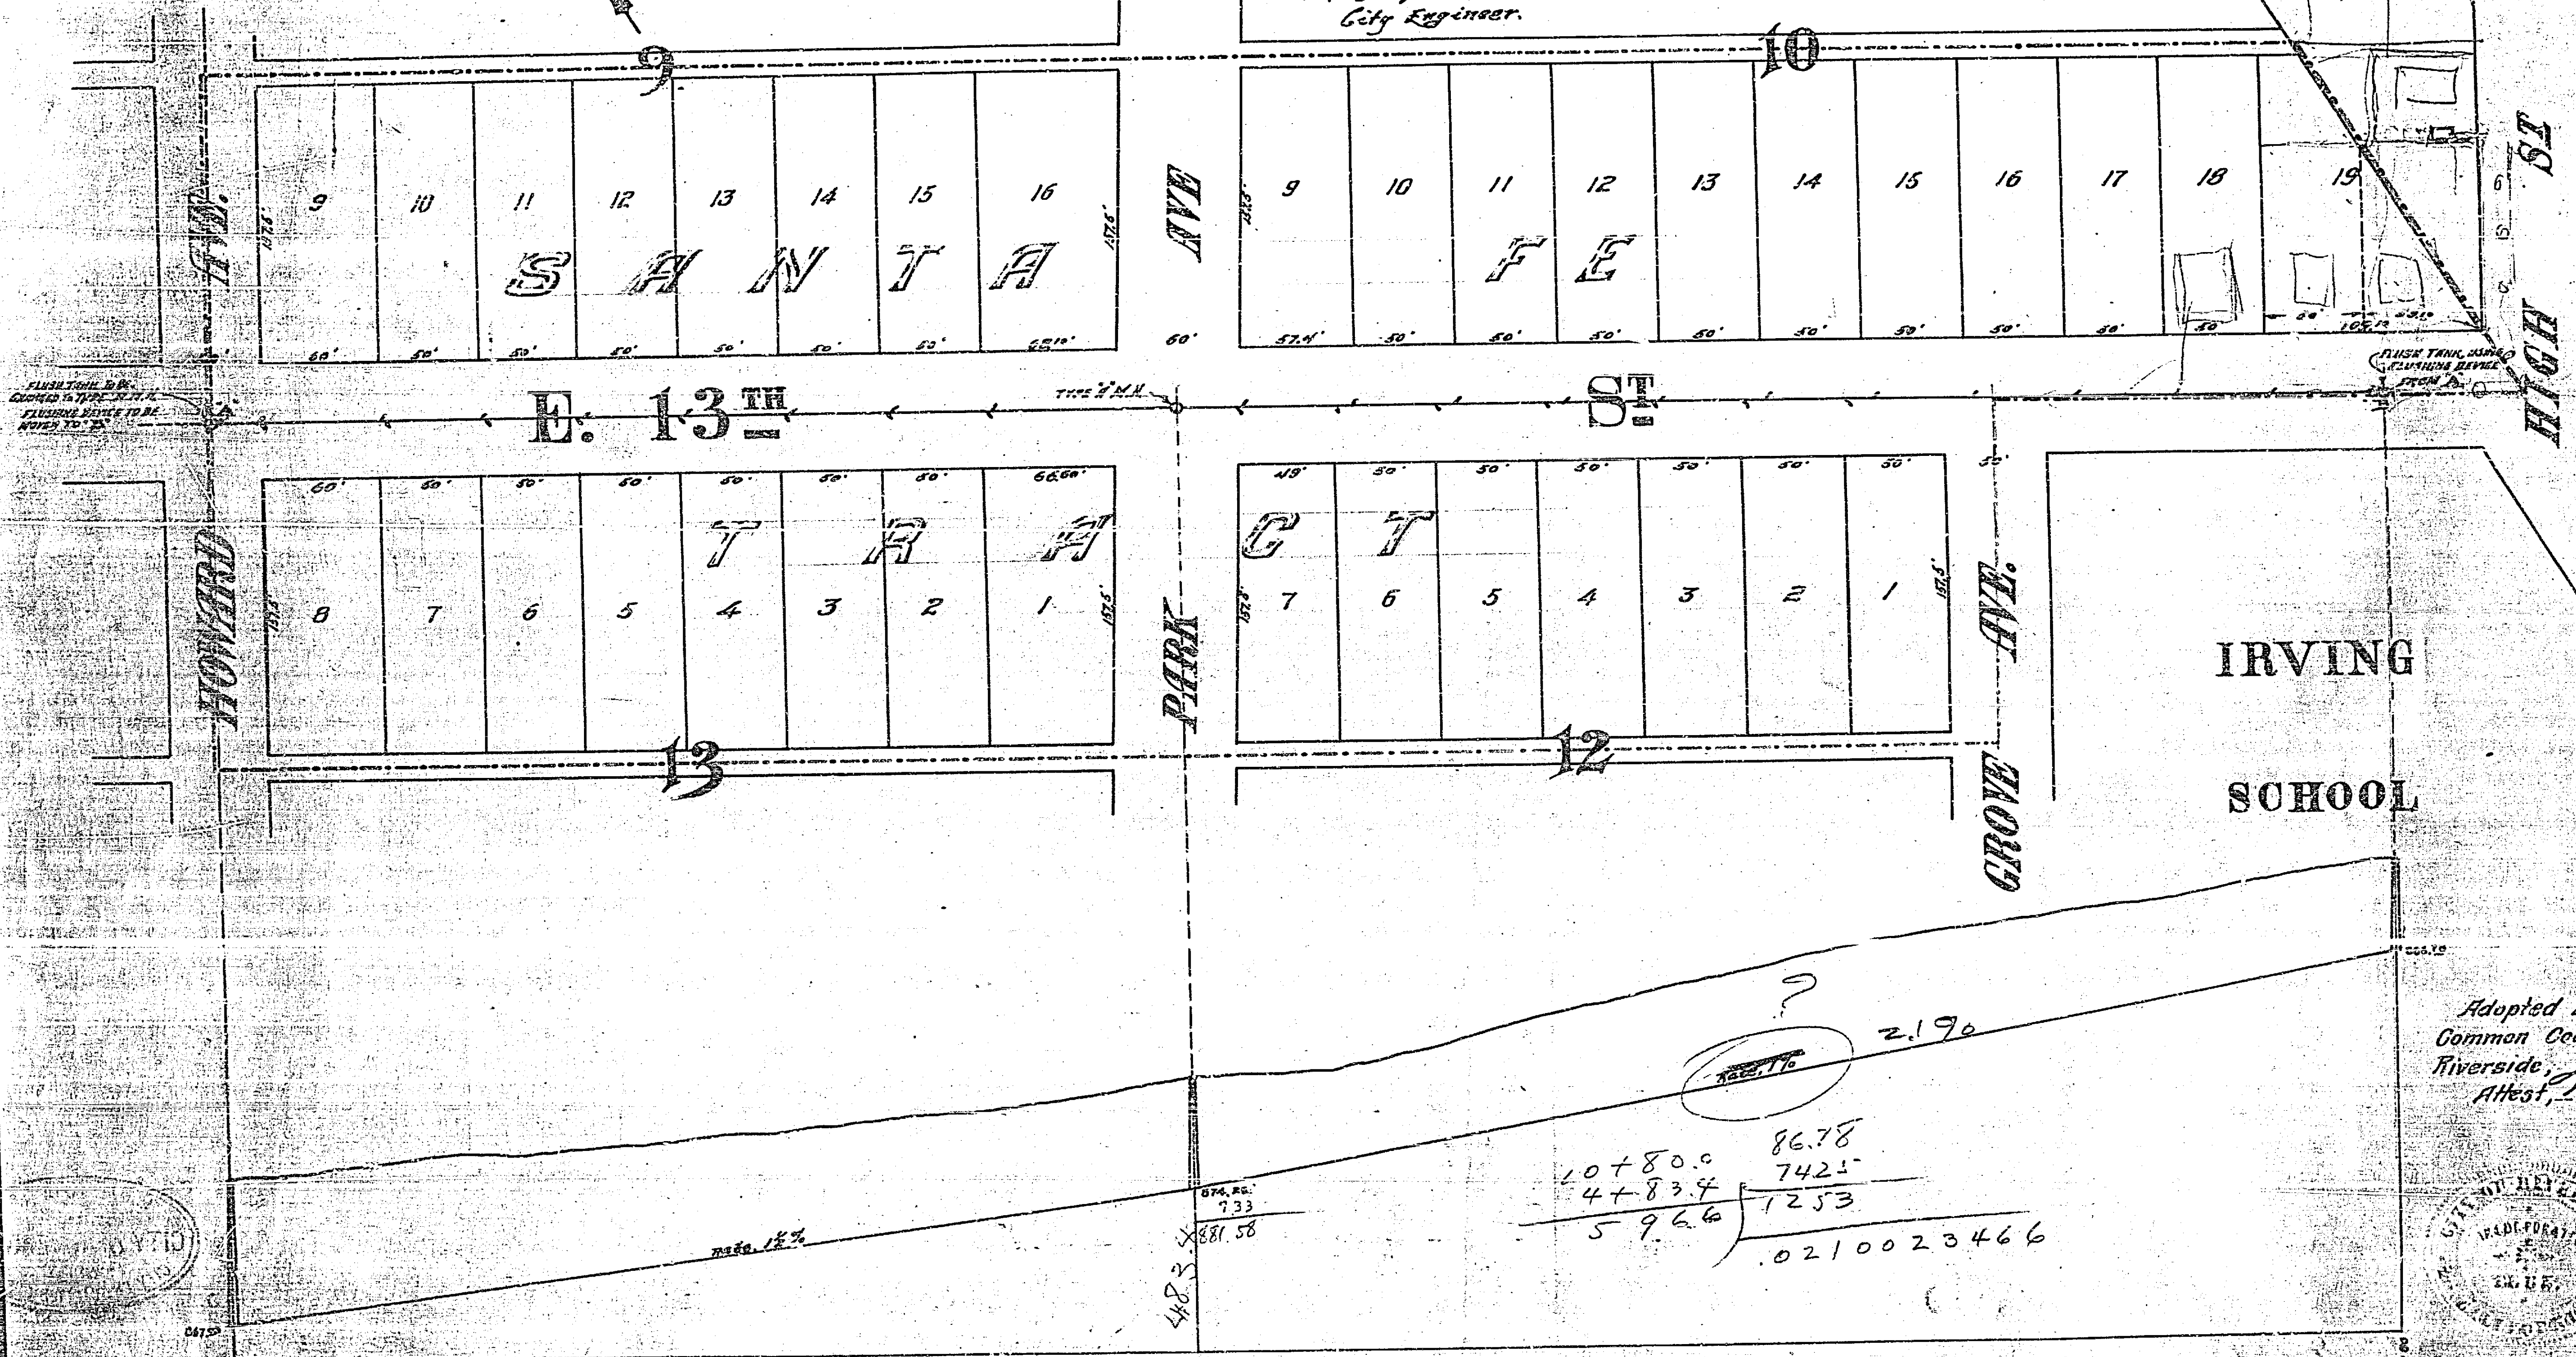

$$\begin{array}{r} 10780.0 \\ 4783.4 \\ \hline 5966 \end{array}$$

$$\begin{array}{r} 86.78 \\ 742.5 \\ \hline 1253 \end{array}$$

$$.0210023466$$

Adopted by the Mayor and
 Common Council of the City of
 Riverside, Aug. 18, 1908.
 Attest, *[Signature]*
 City Clerk.



38815