


A-3

File with 398-B

LINWOOD PLACE			
BROCKTON AVE. TO PALM AVE.			
Drawing Number	Sheet Number	Sheet Size	Scale
398-A	1	1	371
Drawn by	Checked	Approved	

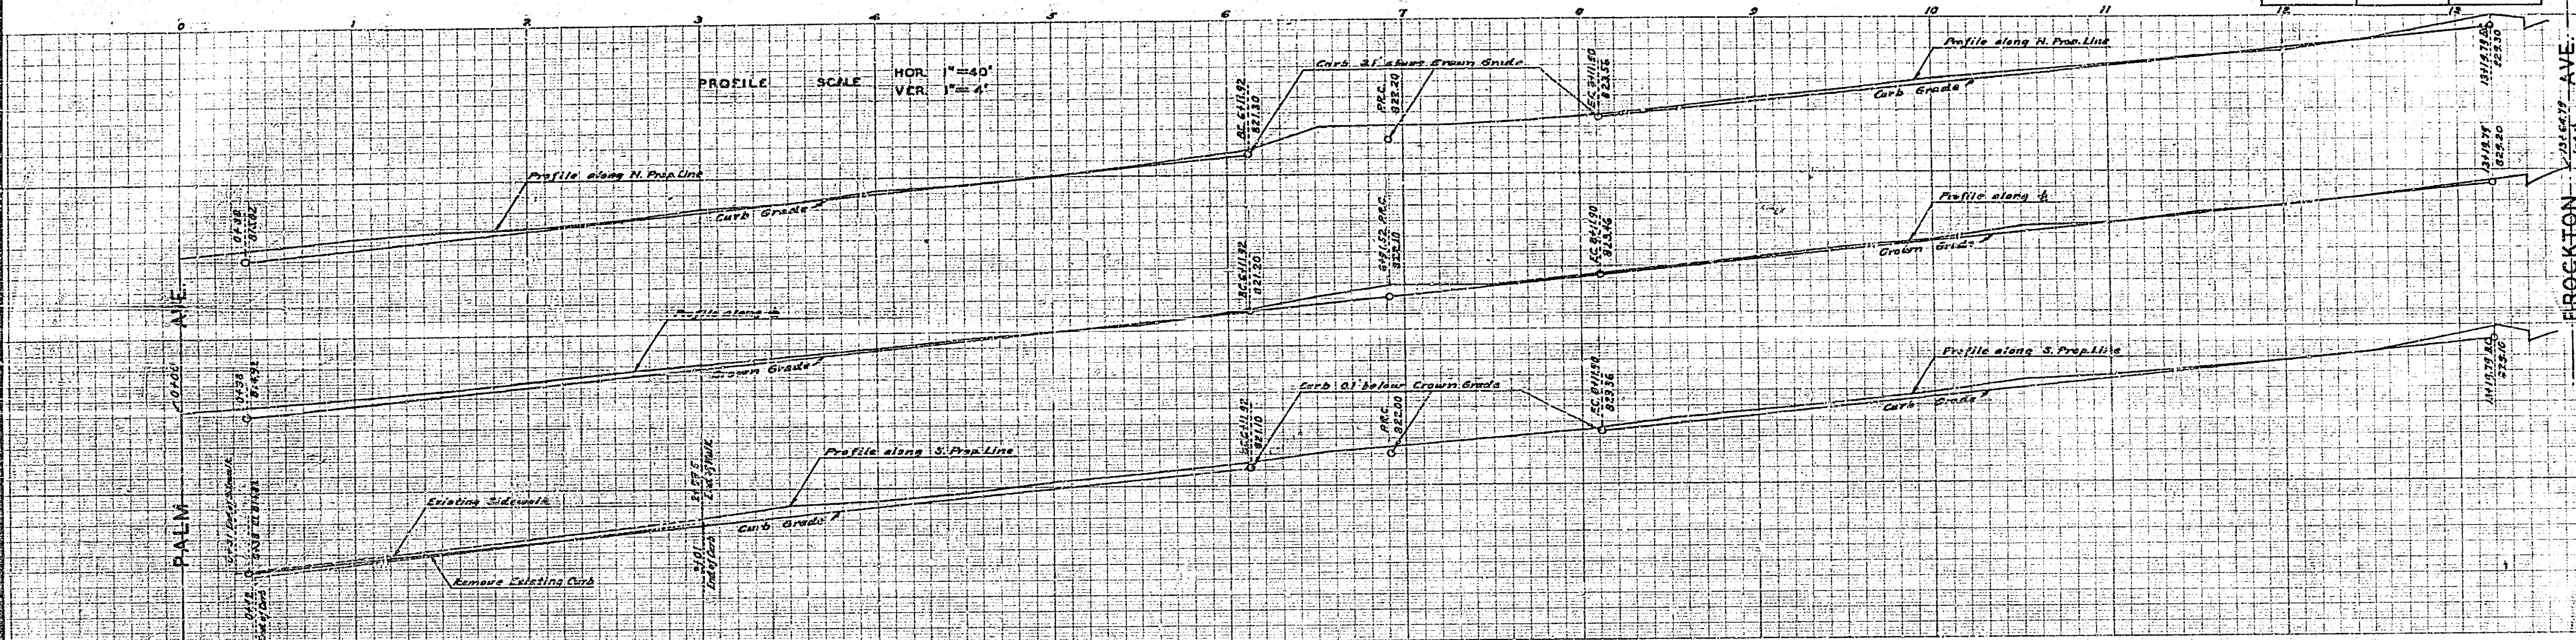

PLAN AND PROFILE
 OF THE PROPOSED IMPROVEMENT ON
LINWOOD PLACE
 PALM AVE. TO BROCKTON AVE.


SCALE 1"=40'

APPROVED AND ADOPTED BY THE MAYOR
 AND COUNCIL OF THE CITY OF RIVERSIDE
 THIS DAY OF 1940.

ENGINEER DEPT. RIVERSIDE CALIF. 1940.
 CITY (U.S.G.S.) DATUM PLANE.
 FIELD BOOK 37: PAGES 51-57-76

APPROVED
 CITY ENGINEER
 REG. ENG. 1312

*with side
 limit of sidewalk?*

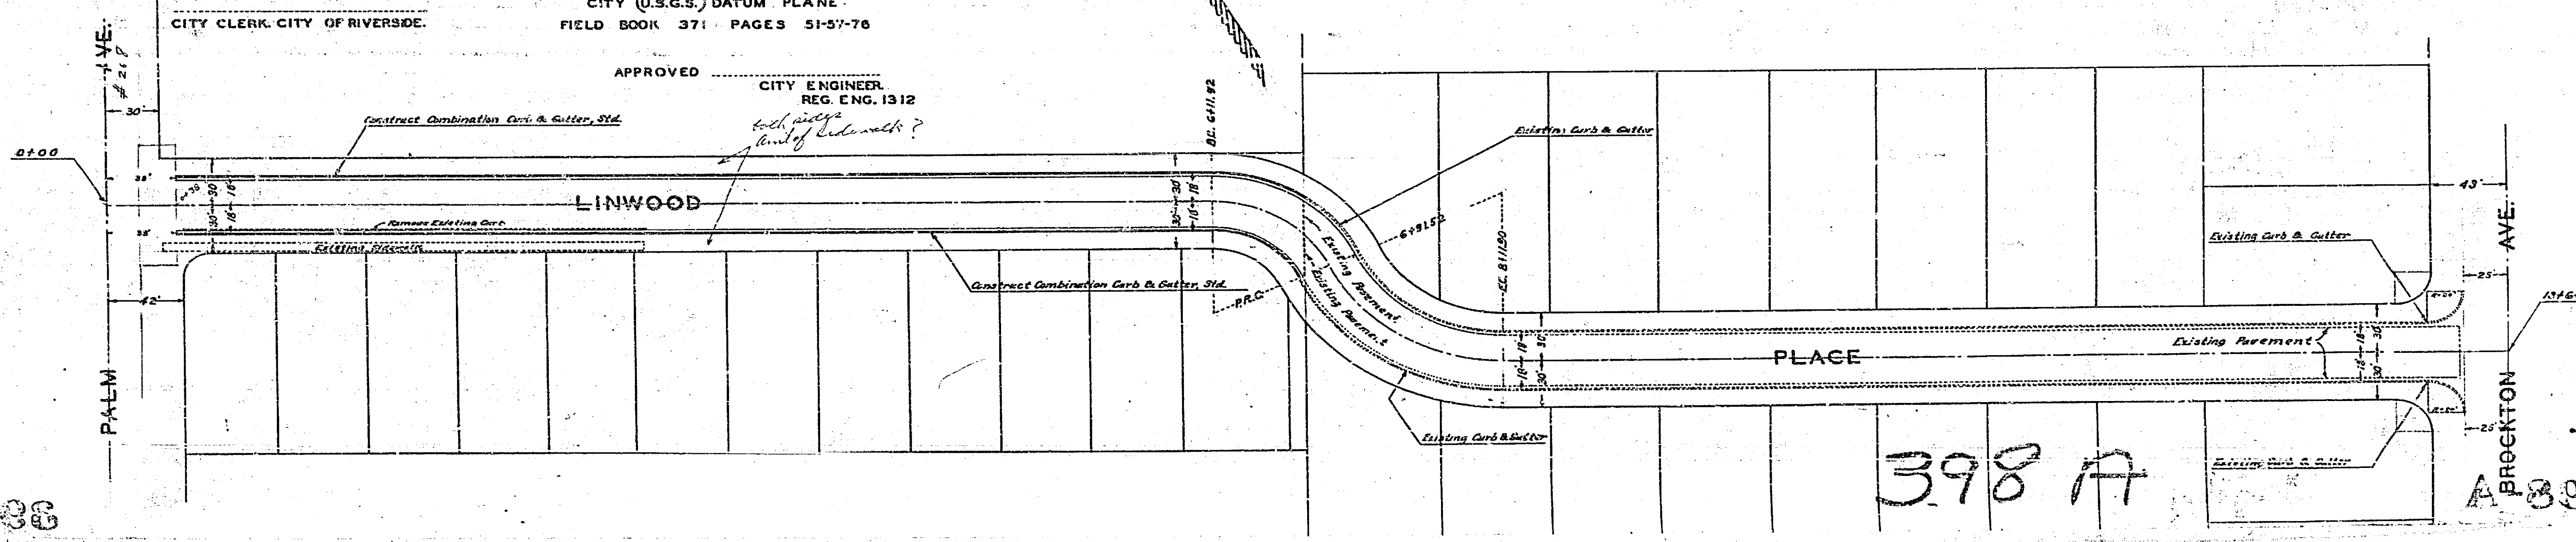

398 A

A-808

A 398