

File with 109

SHEET 1, TOTAL

# DIAGRAM

## EXHIBITING PLEASANT-PROSPECT IMPROVEMENT DISTRICT


IN THE CITY OF RIVERSIDE ON WHICH WORK HAS BEEN DONE UNDER MY OFFICIAL CONTRACT AS SUPERINTENDENT OF STREETS OF SAID CITY WITH THE HOGAN CO. DATED JANUARY 8, 1951, FOR THE CONSTRUCTION OF CONCRETE CURBS & GUTTERS, DOUBLE GUTTER & CURBS AS IS MORE PARTICULARLY DESCRIBED IN SAID CONTRACT TO WHICH REFERENCE IS HEREBY MADE FOR FURTHER PARTICULARS; SAID DIAGRAM ALSO SHOWS THE RELATIVE LOCATION OF EACH LOT, PORTION OF LOT, PIECE OR PARCEL OF LAND ASSESSED FOR THE WORK DONE NUMBERED IN CIRCLES TO CORRESPOND TO THE RED INK NUMBERS IN THE ASSESSMENT HEREIN FIGURES NEXT TO PROPERTY LINES SHOW LENGTH OF SAID LINES IN FEET. THE MARK (V) MEANS FEET. PROPERTY LINES THAT DIFFER FROM THE RECORDED SUBDIVISIONS ARE SHOWN BY BROKEN LINES. THE DISTRICT BENEFITED IS BOUNDARY COVERED BY HEAVY DASHED LINE. PROPERTY COVERED BY THIS ASSESSMENT IS SHOWN ON THE FOLLOWING RECORDED MAPS:

SANTA FE TRACT MAP BK 9 PG 14 REC. OF SAN BERNARDINO  
 HALL'S ADDITION MAP BK 9 PG 3 REC. OF SAN BERNARDINO

I HEREBY CERTIFY THAT THIS ASSESSMENT DIAGRAM WAS APPROVED BY THE CITY COUNCIL OF THE CITY OF RIVERSIDE AT A MEETING THEREOF HELD ON THE \_\_\_\_\_ DAY OF \_\_\_\_\_ 19\_\_\_\_

\_\_\_\_\_  
 CITY CLERK OF THE CITY OF RIVERSIDE.

HEREIN THE LEGEND OF THE DIFFERENT KINDS OF WORK PERFORMED IS SHOWN AS FOLLOWS:

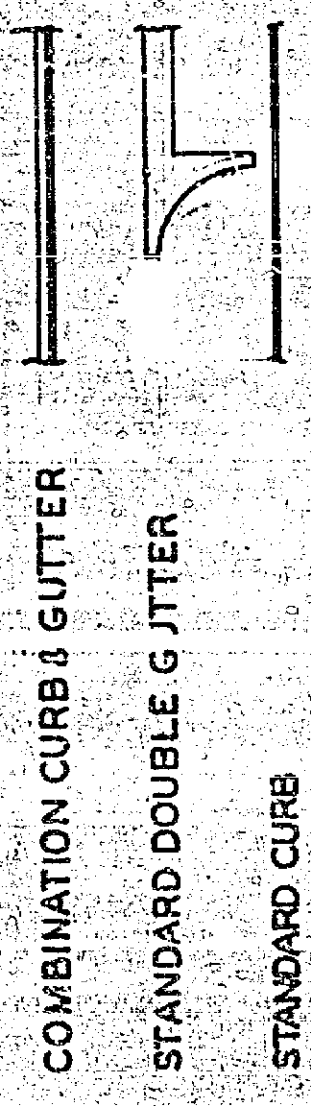

SUPERINTENDENT OF STREETS OF THE CITY OF RIVERSIDE THE FOLLOWING IS A STATEMENT OF AMOUNTS OF DIFFERENT KINDS OF WORK DONE BY THE HOGAN CO. UNDER CONTRACT DATED JANUARY 8, 1951 PURSUANT TO RESOLUTION OF INTENTION NO. 4809, ADOPTED BY THE CITY COUNCIL OF THE CITY OF RIVERSIDE ON THE 26TH DAY OF SEPTEMBER 1950.

### LIST OF QUANTITIES

35765.7 LIN. FT.	COMBINATION CONCRETE CURB & GUTTER
1000.54 SQ. FT.	STANDARD DOUBLE GUTTER
4875 LIN. FT.	STANDARD CURB

AT SAID CITY OF RIVERSIDE THIS \_\_\_\_\_ DAY OF \_\_\_\_\_

\_\_\_\_\_  
 SUPERINTENDENT OF STREETS OF THE CITY OF RIVERSIDE.

I HEREBY CERTIFY THAT THE ABOVE WORK WAS DONE IN ACCORDANCE WITH LINES AND GRADES FURNISHED BY ME AND THAT THE DIAGRAM OF THE ASSESSMENT DISTRICT FOR THE SAME IS CORRECT.

*M. H. Lawrence*  
 CITY ENGINEER OF THE CITY OF RIVERSIDE.

RECORDED AT \_\_\_\_\_ O'CLOCK \_\_\_\_\_ M.  
 THIS \_\_\_\_\_ DAY OF \_\_\_\_\_ 19\_\_\_\_

\_\_\_\_\_  
 SUPERINTENDENT OF STREETS OF THE CITY OF RIVERSIDE.

412

File with 109