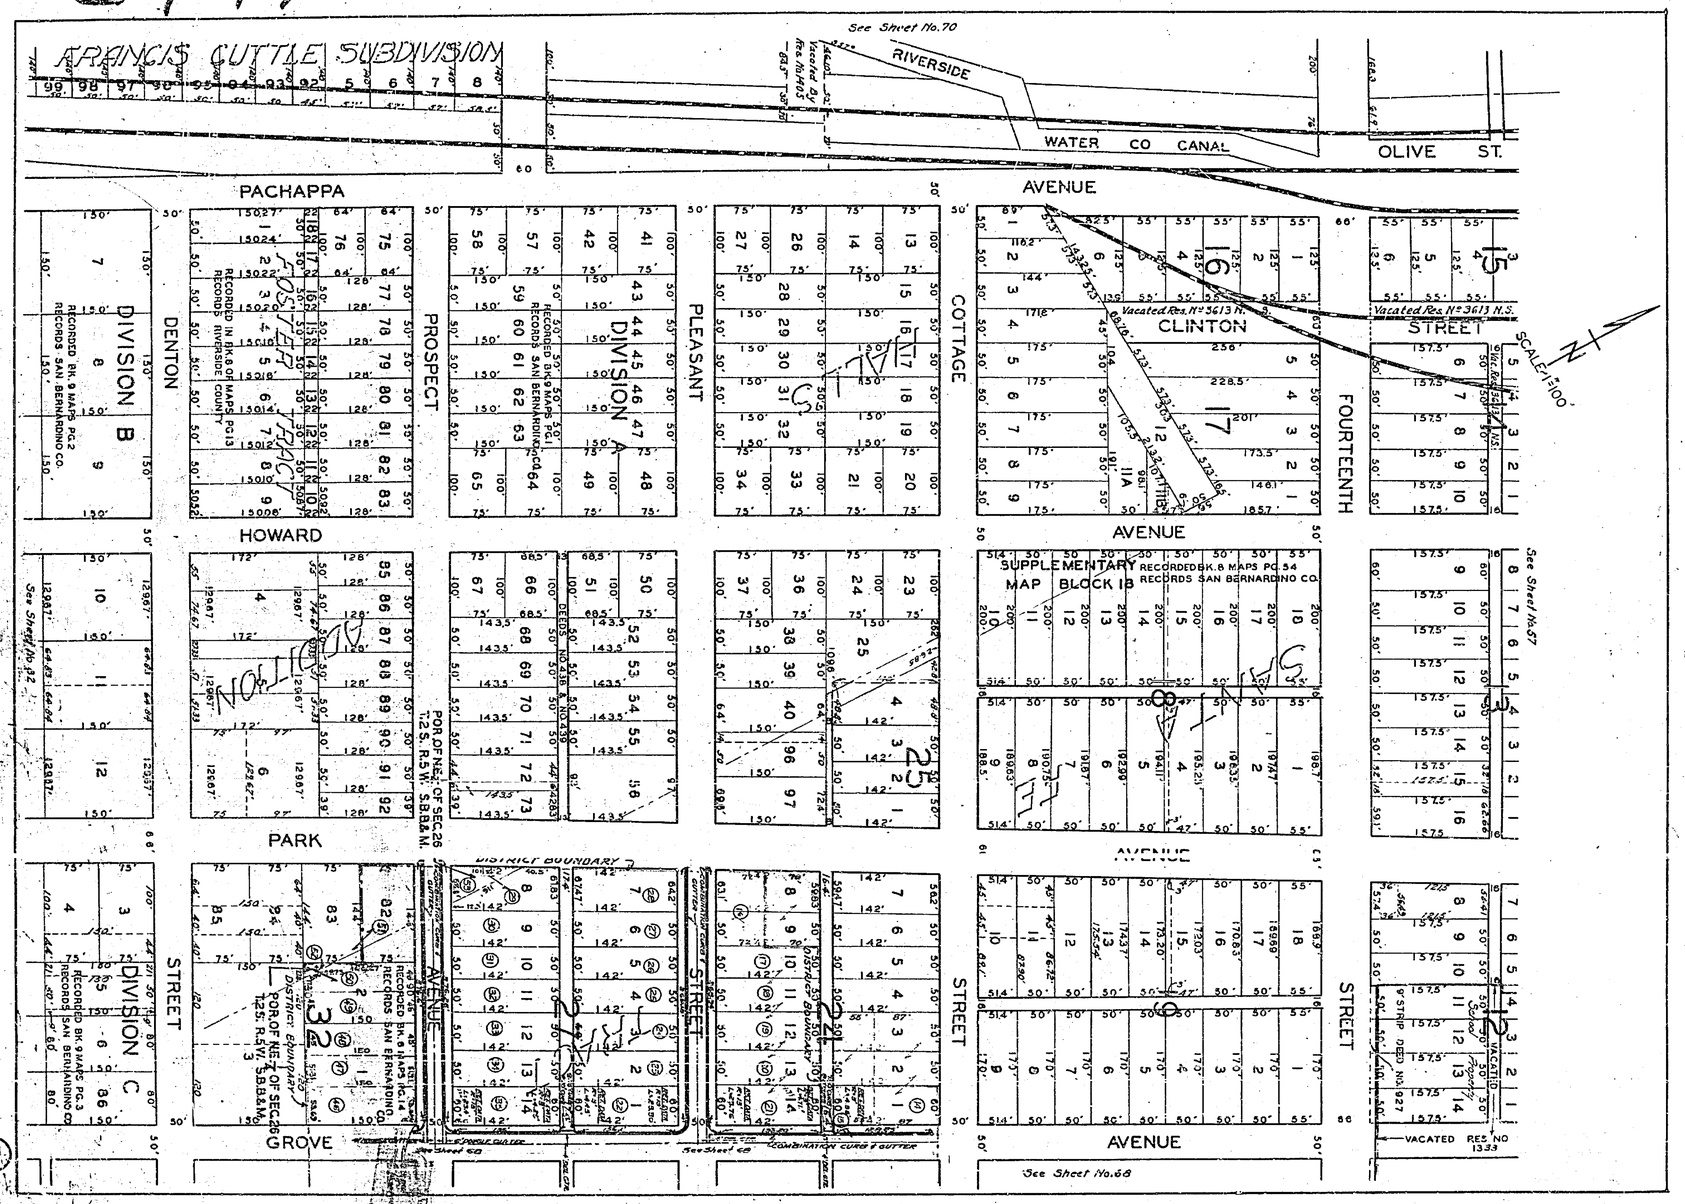

FRANCIS CUTTLE SUBDIVISION
See Sheet No.70
RIVERSIDE
WATER CO CANAL
OLIVE ST.
PACHAPPA
AVENUE
DENTON
PROSPECT
PLEASANT
COTTAGE
CLINTON
STREET
FOURTEENTH
HOWARD
AVENUE
PARK
AVENUE
STREET
GROVE
AVENUE
DIVISION B
DIVISION A
DIVISION C
SUPPLEMENTARY MAP BLOCK 18
RECORDED BK. 8 MAPS PG. 54 RECORDS SAN BERNARDINO CO.
DISTRICT BOUNDARY
See Sheet No.68
See Sheet No.57
SCALE 1"=100'