


PROPERTY OF
CITY OF RIVERSIDE
CITY ENGINEERING DEPT.

PROPERTY OF
CITY OF RIVERSIDE
CITY ENGINEERING DEPT.

PRINTED IN U.S.A.
ON 100% RAG PAPER MADE IN U.S.A.

PRINTED IN U.S.A.
ON 100% RAG PAPER MADE IN U.S.A.


PRINTED IN U.S.A.
ON 100% RAG PAPER MADE IN U.S.A.

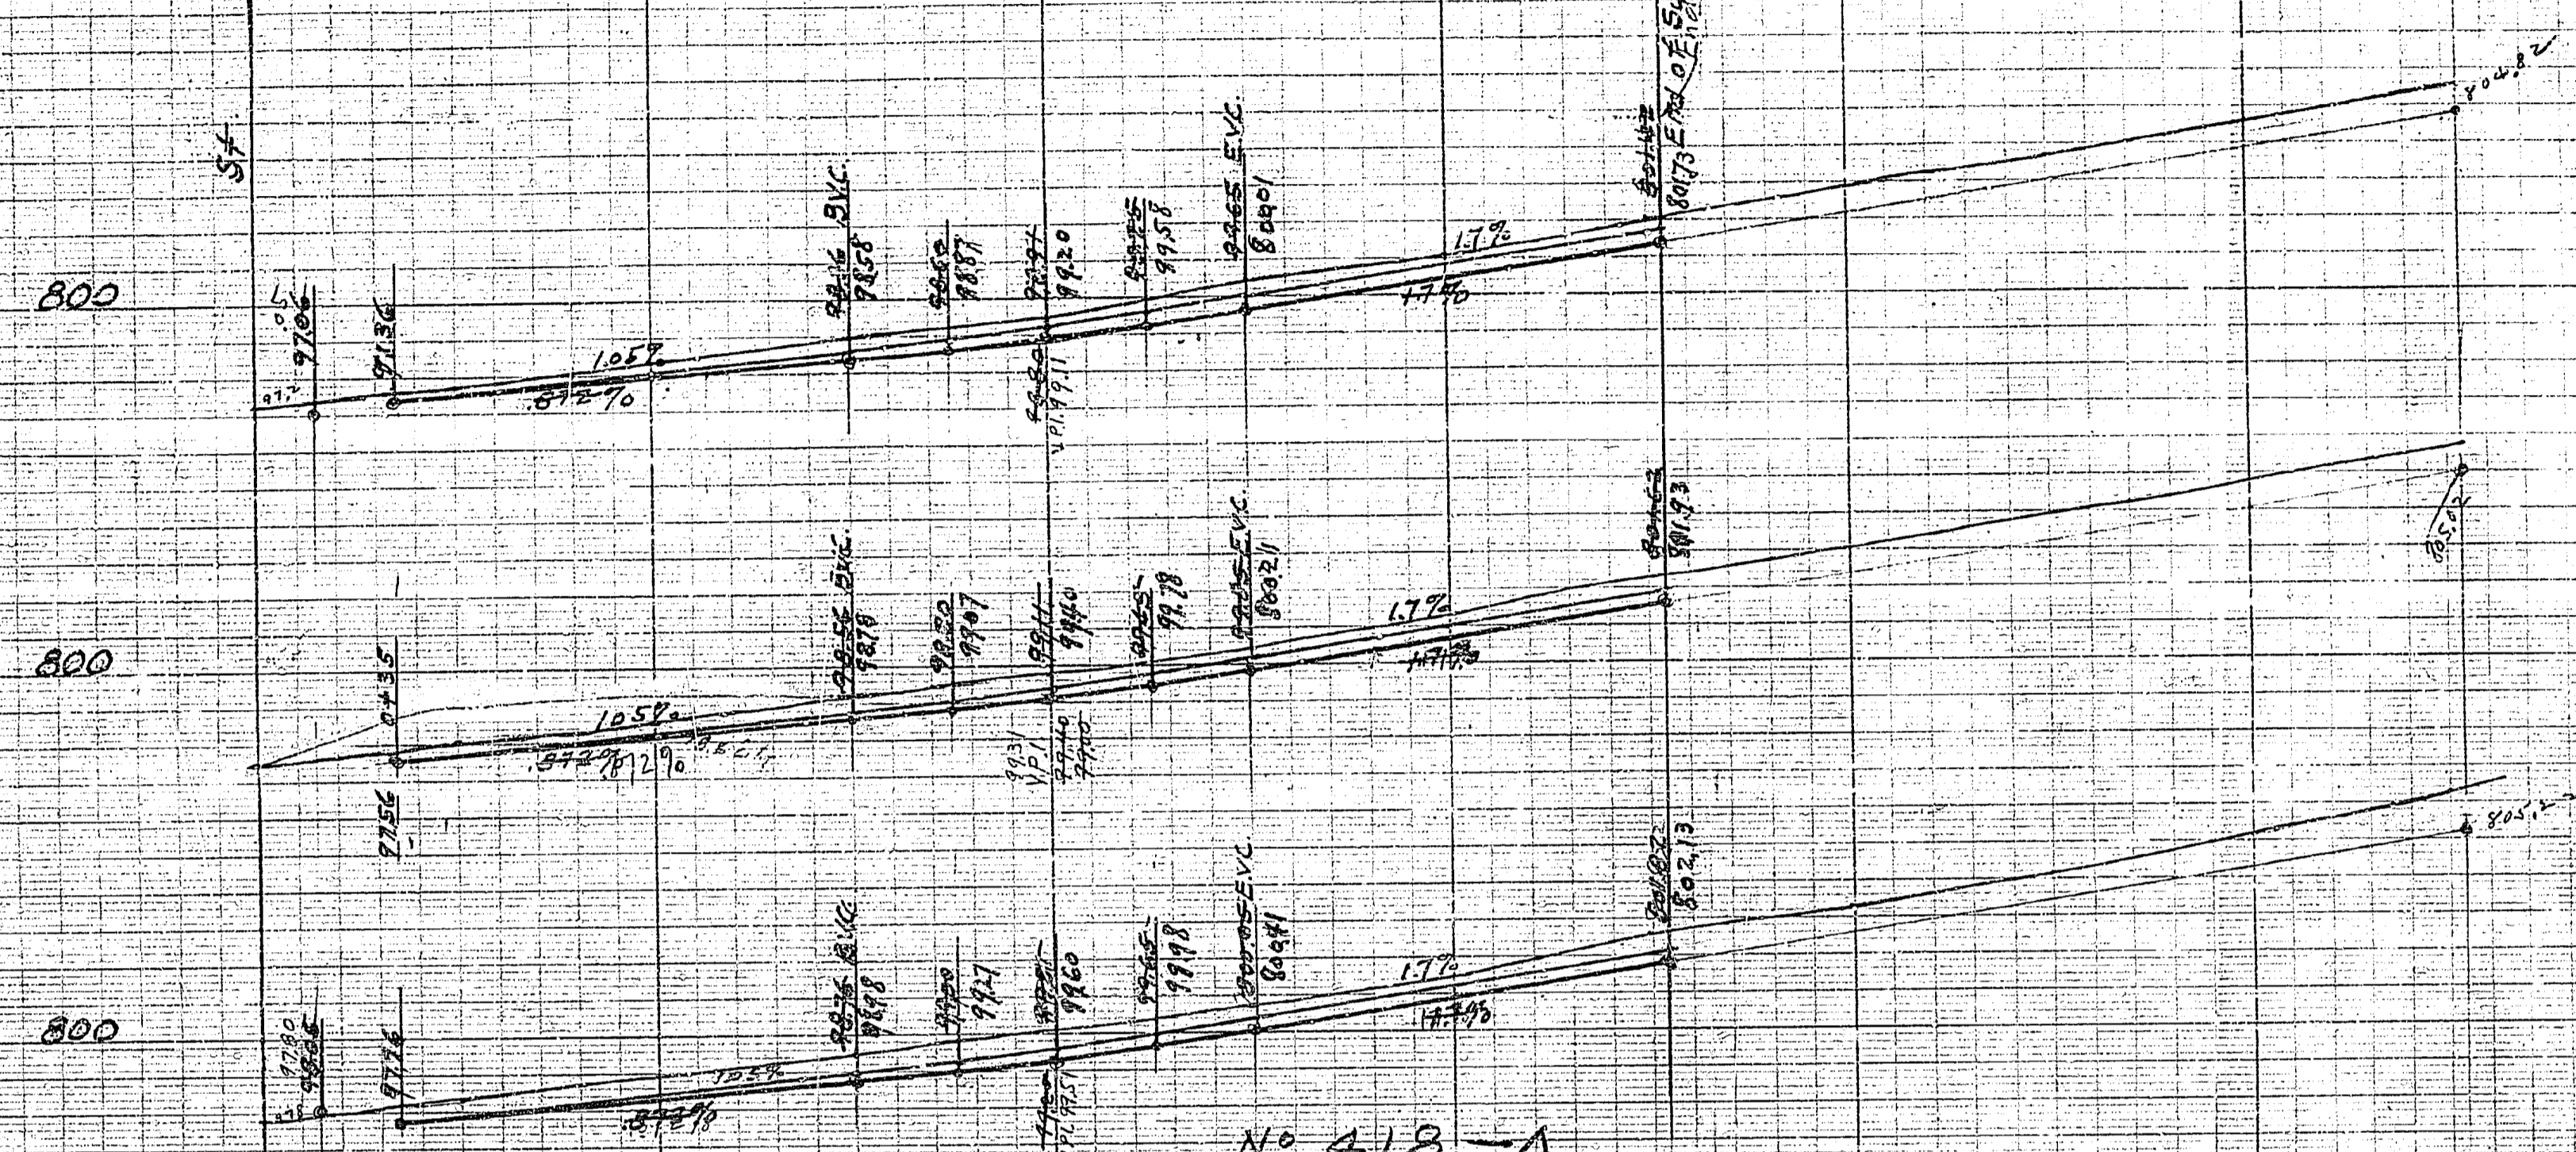

No 418-A
PROFILE EL DARYI

Scale { 1" = 40' Vert
1" = 200' Hor.

Valencia St

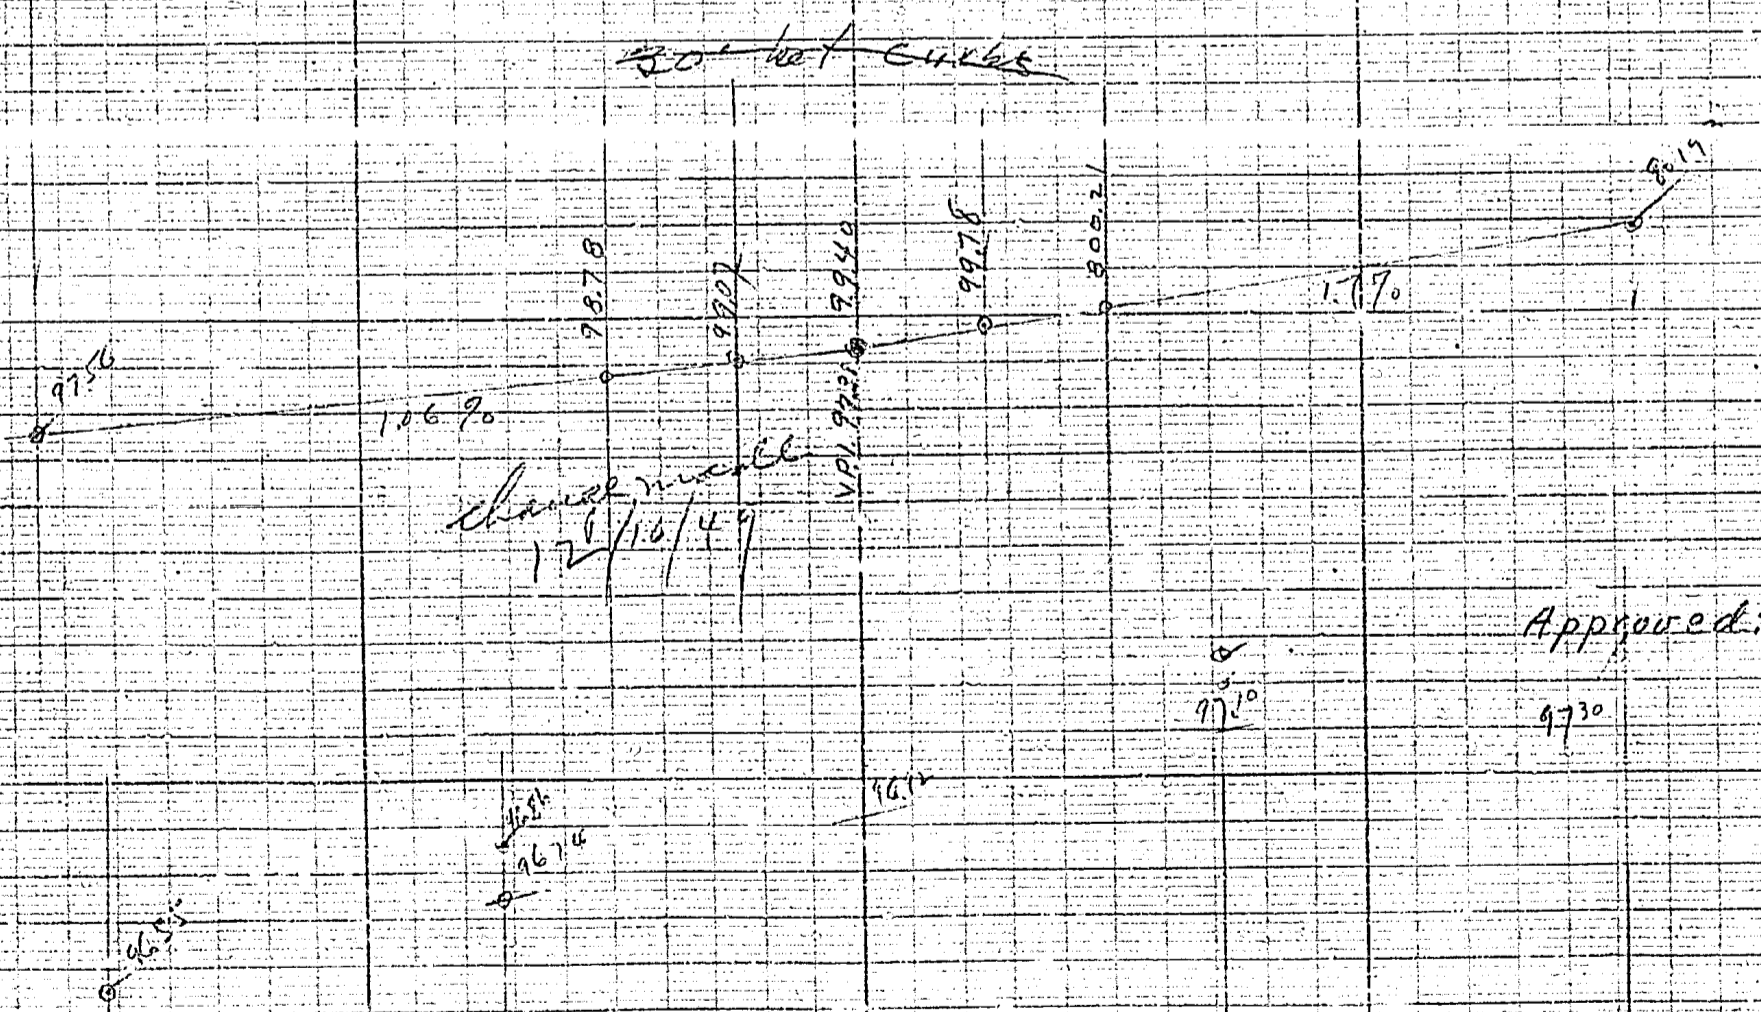

October 18, 1949.
Approved: M. H. Swine,
CITY ENGINEER.

PROPERTY OF
CITY OF RIVERSIDE
CITY ENGINEERING DEPT.

PROPERTY OF
CITY OF RIVERSIDE
CITY ENGINEERING DEPT.

E. side of
cut stakes Valencia St (N. & S. from El Daryi)
473/47-48

418A A-8