


Levels in
Rice's Property lot 37, 32, 31, land.


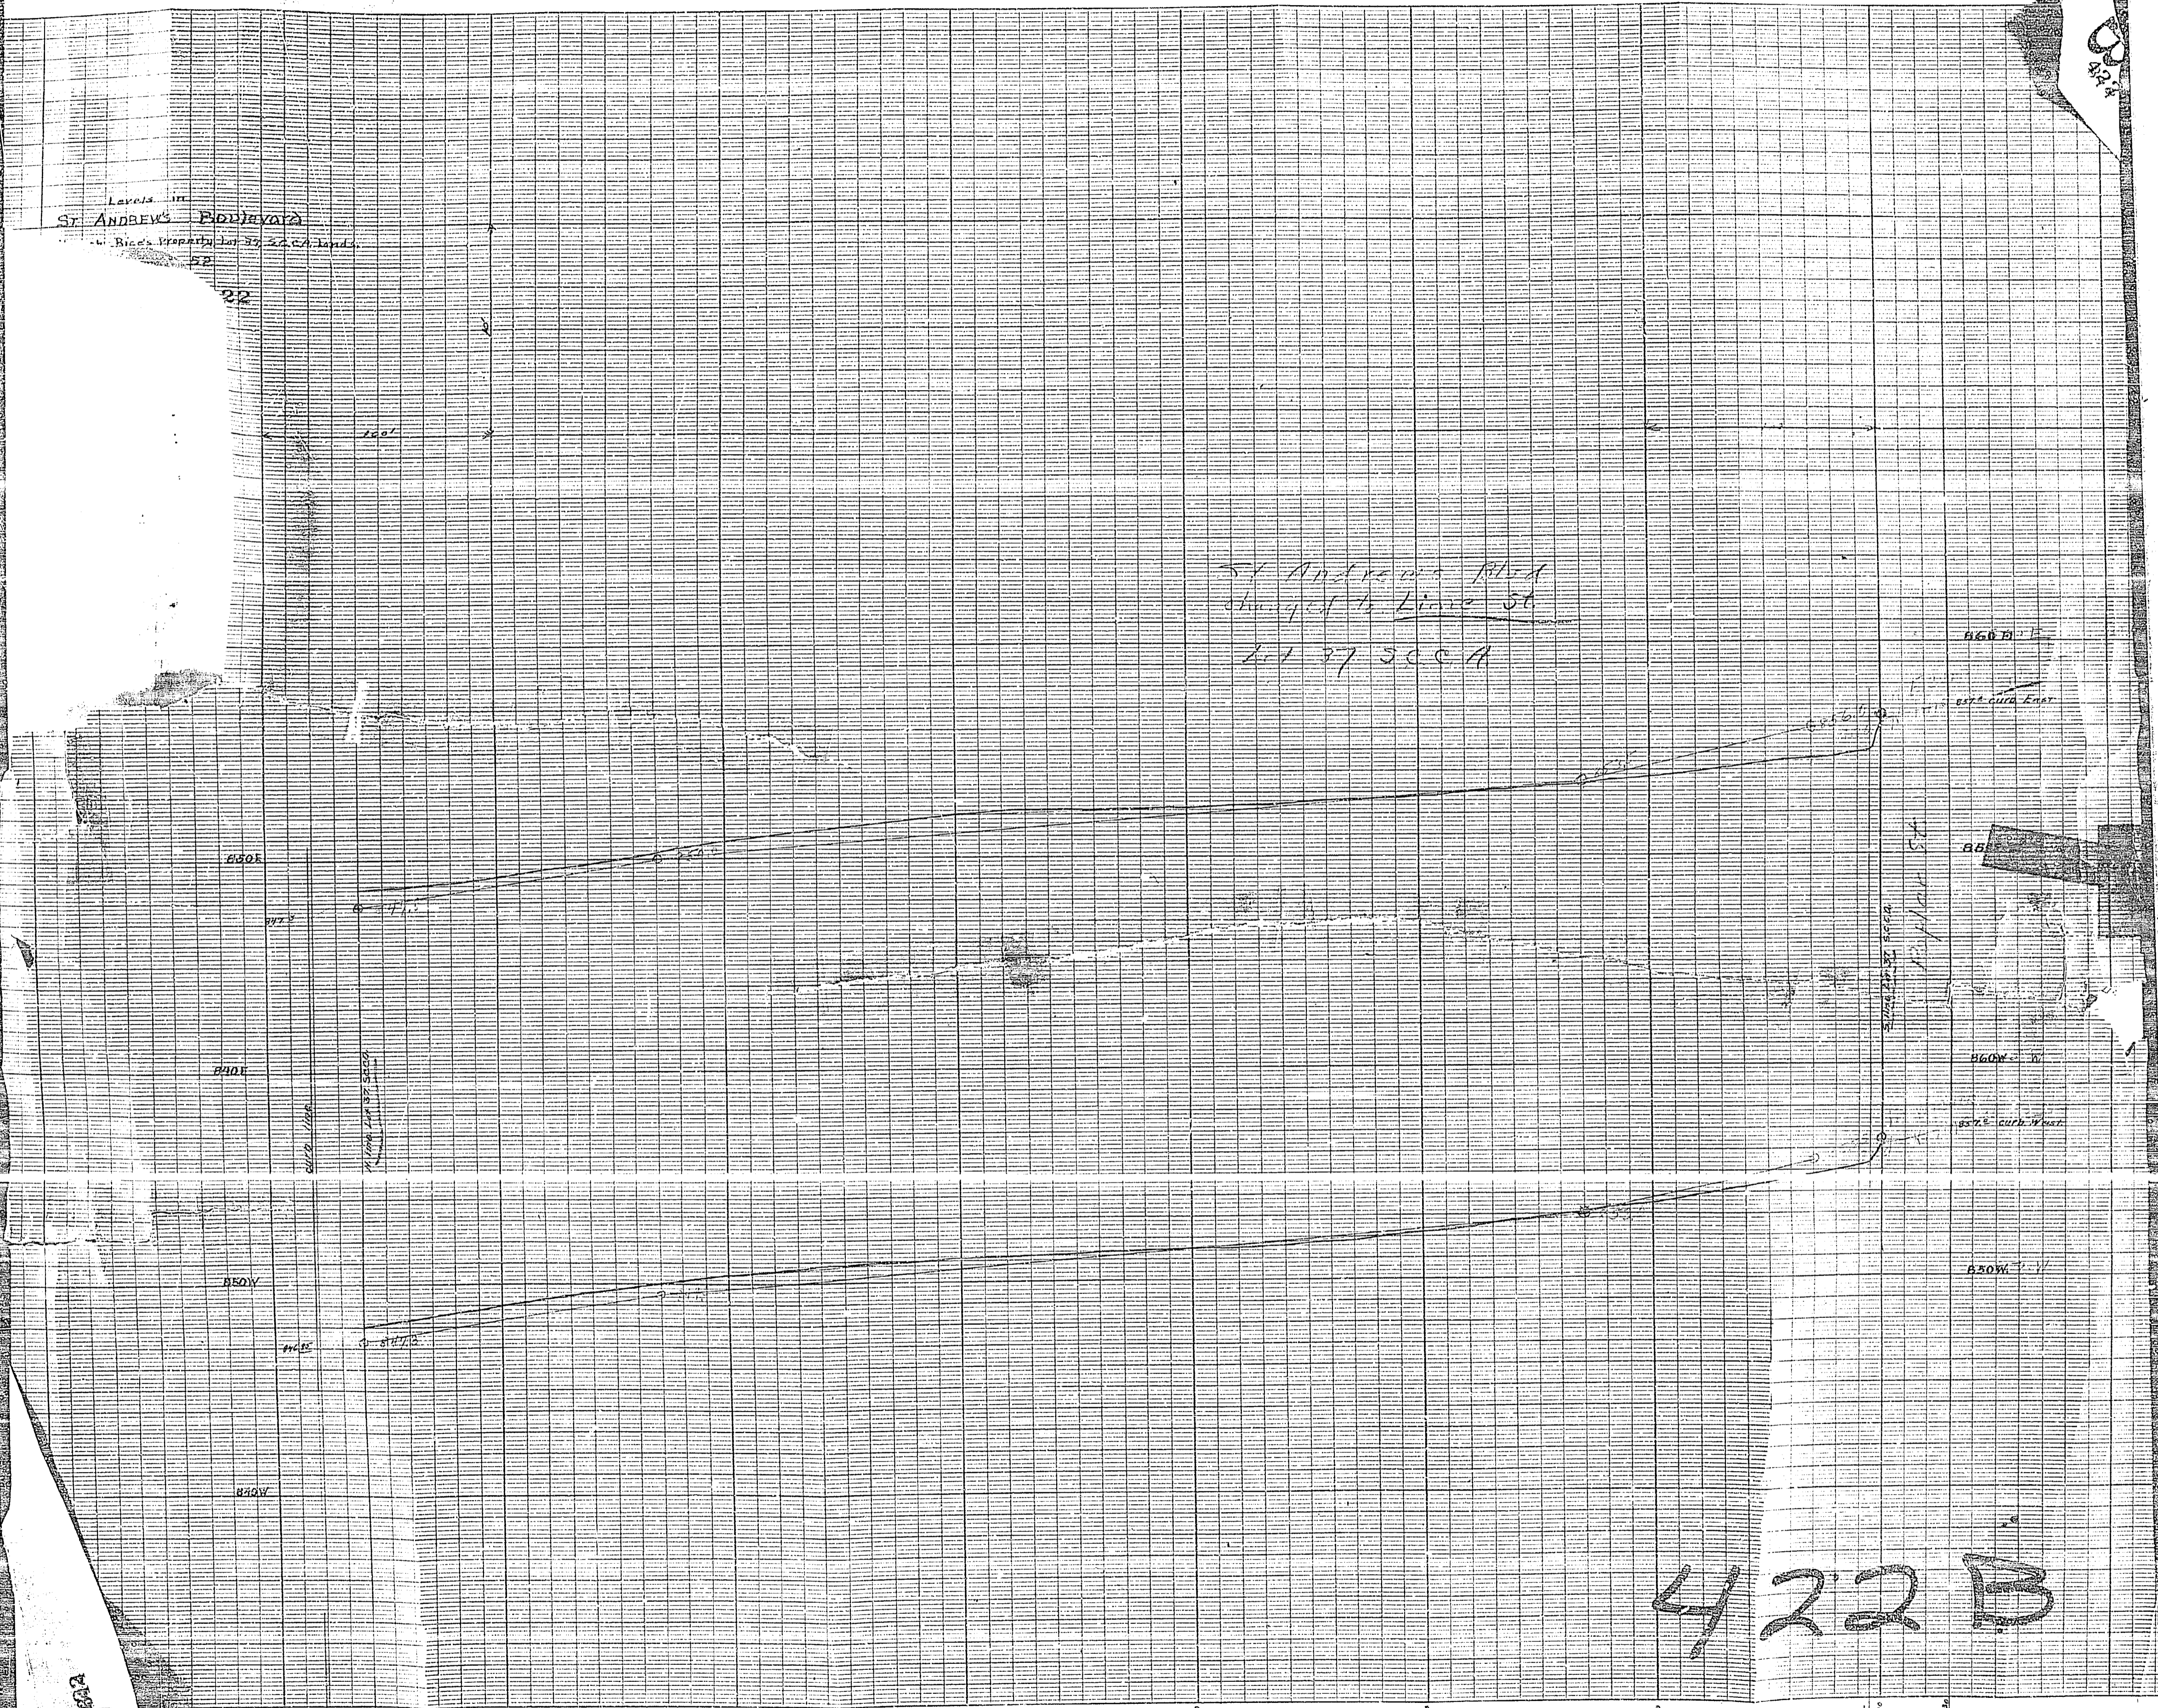

422B

PROF. DIETZGEN CO.
EUGENE DIETZGEN CO.

PROF. DIETZGEN CO.
EUGENE DIETZGEN CO.