


Scale of Profile
PLATE A
ENGINEER DISTRICT CO.
PRINTED IN U.S.A.
ON 100% RECYCLED PAPER MADE IN U.S.A.

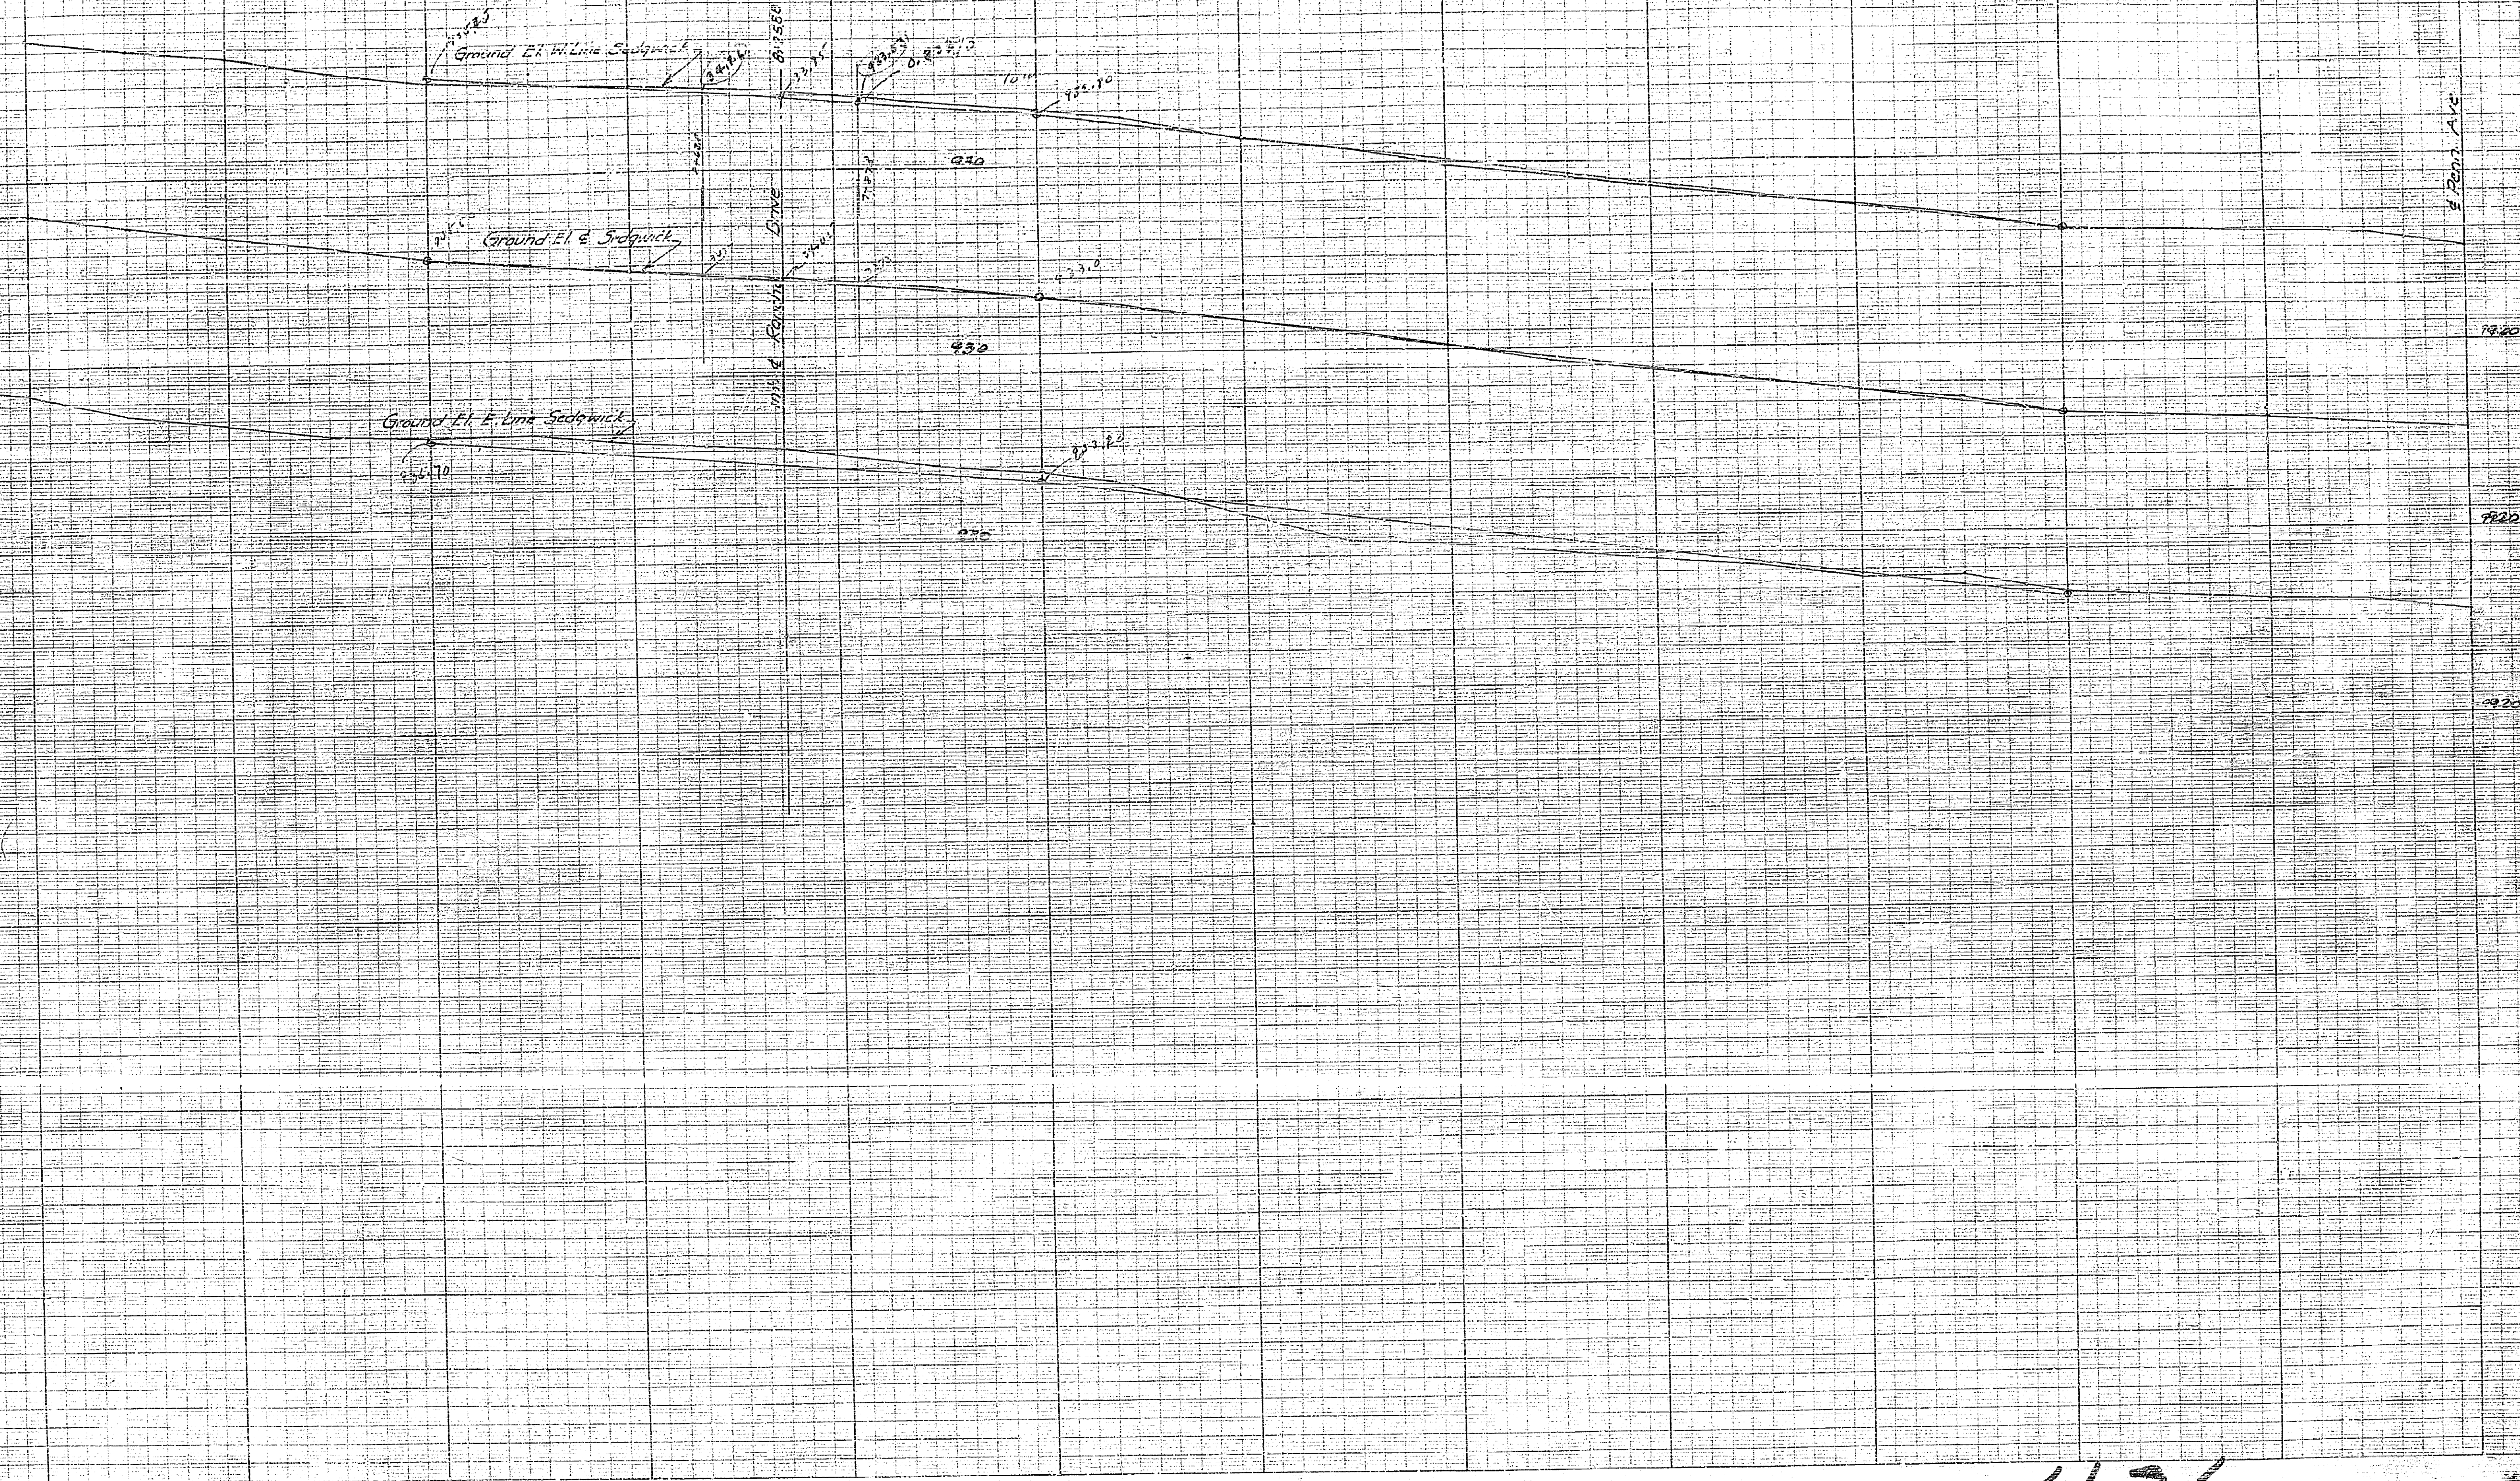


FRAME 1 OF 2 436

PLANS AND PROFILES
 W.P.L. 116 VIEW
 RANCHO VISTA TRACT

May 1948
 scales - 1/2" = 20' Hor
 1/4" = 4' Vert

Drawn by Donald J. Nickes

Approved M. N. Sweeney
 City Eng. City of Riverside

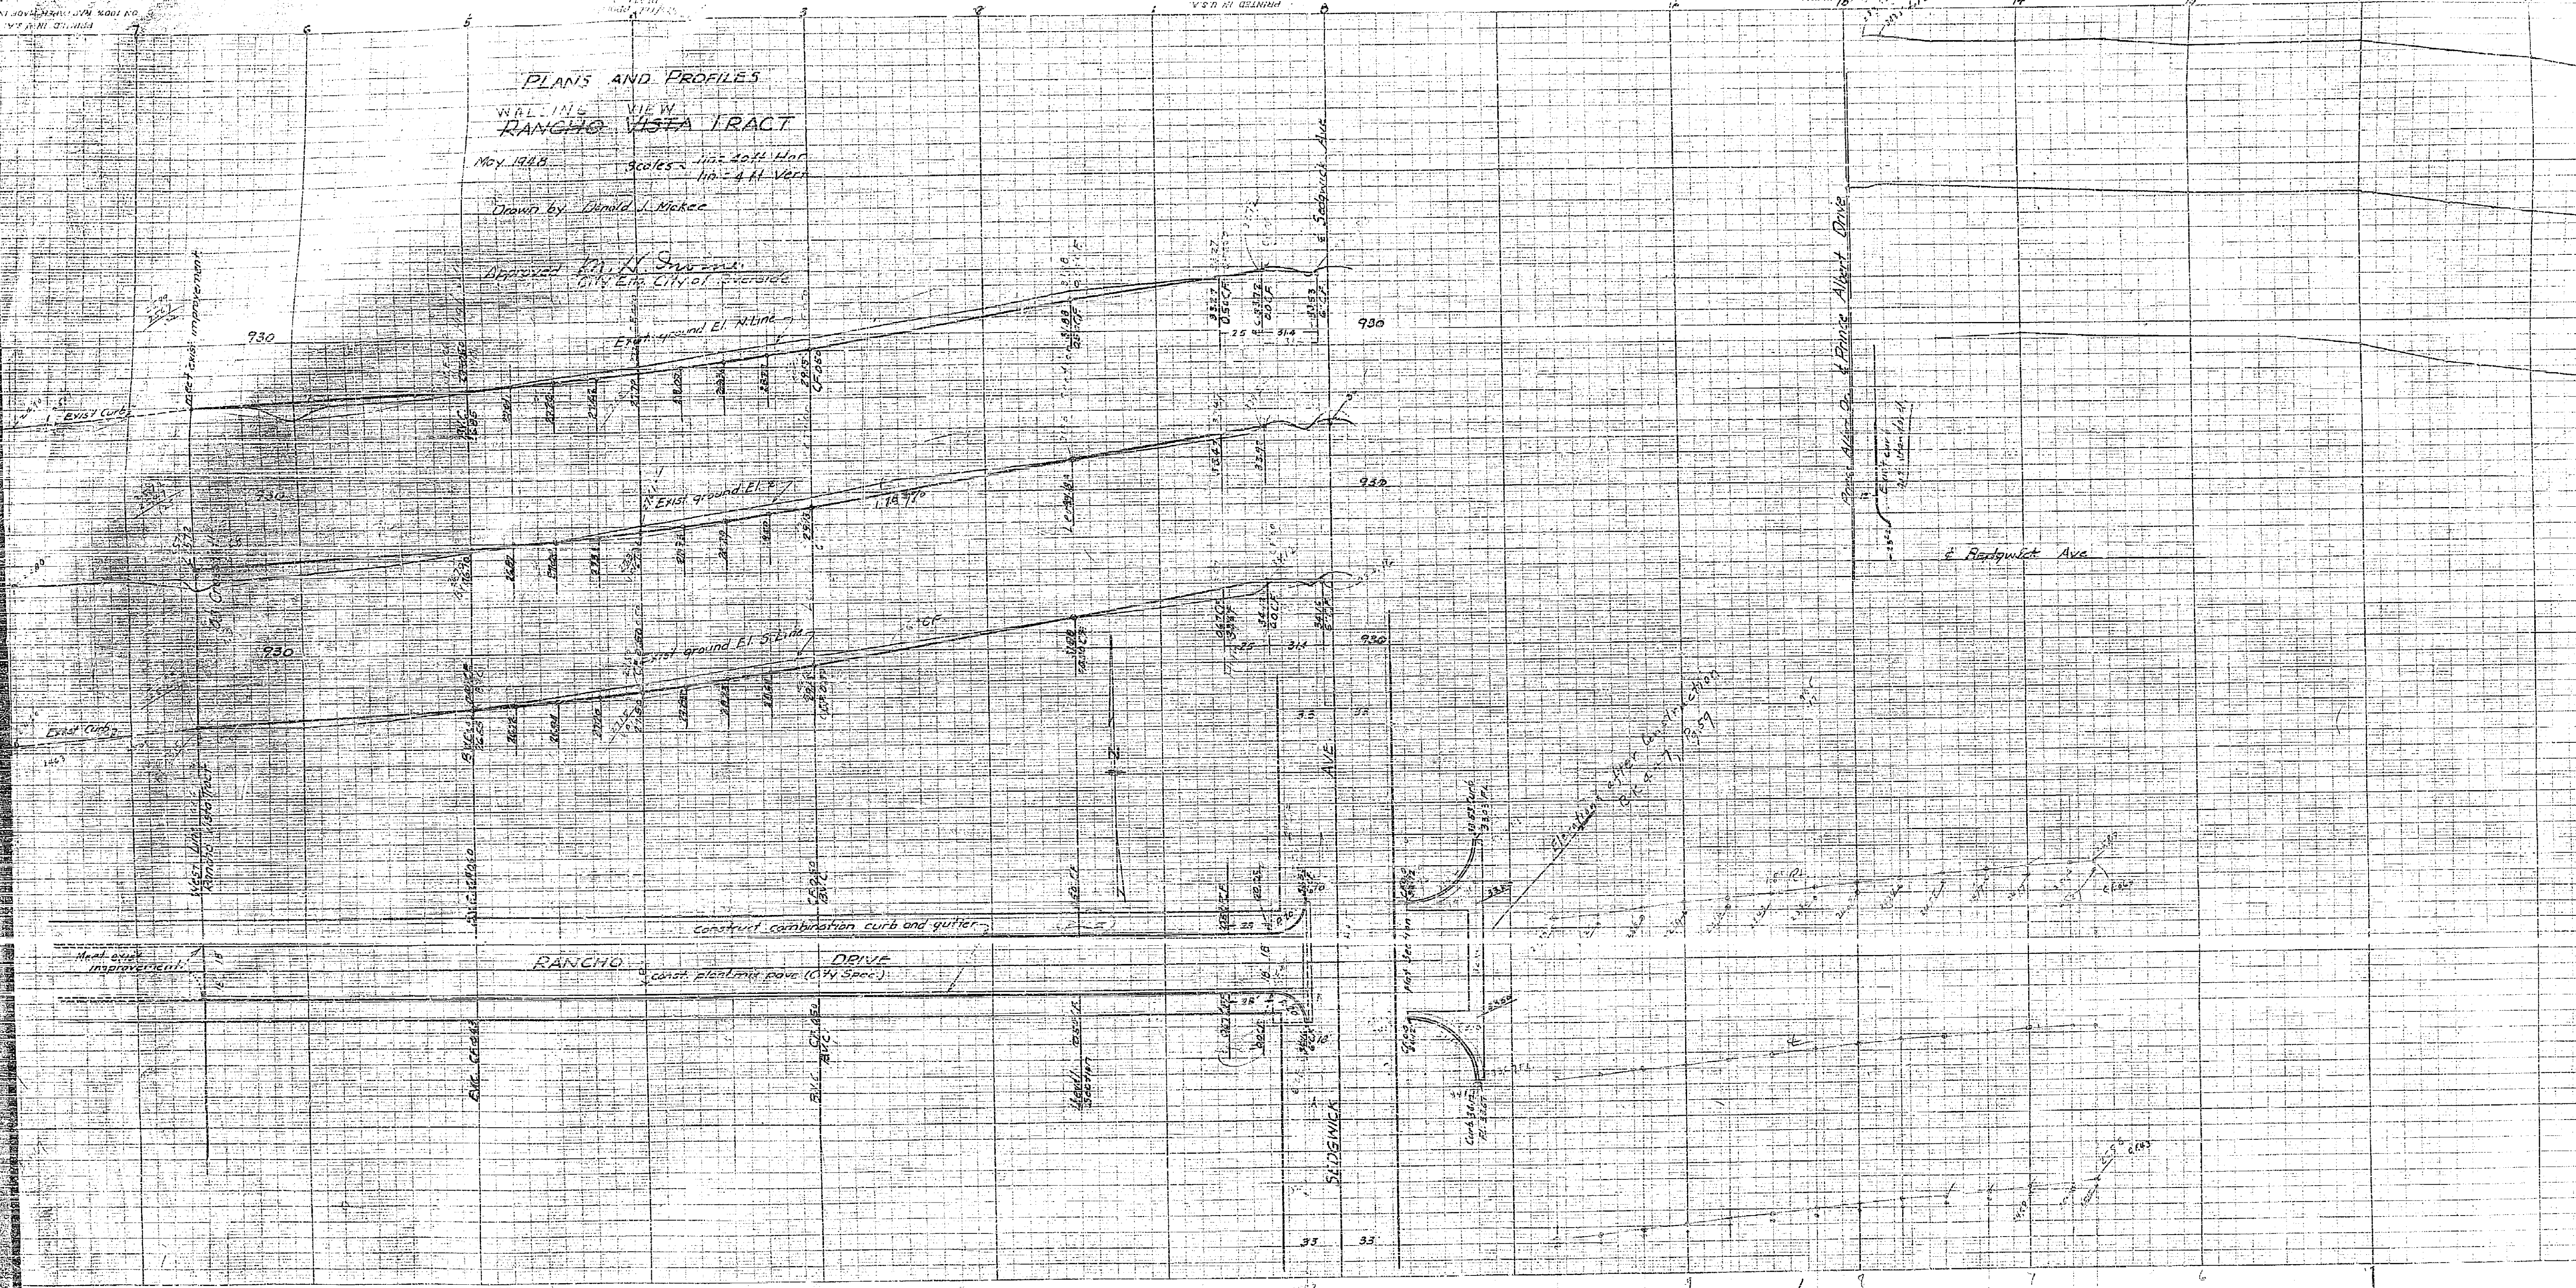

Elev. bases built
 F.B. 447/59

FRAME 2 OF 2

447/59