


Note:  
Temporary traffic island formed by  
beaded white line 12" wide.  
(Permanent island would be  
constructed with raised bars  
or curbed with Type C1 or  
Type C3 curb)

Traffic Island to be  
constructed.  
See note.

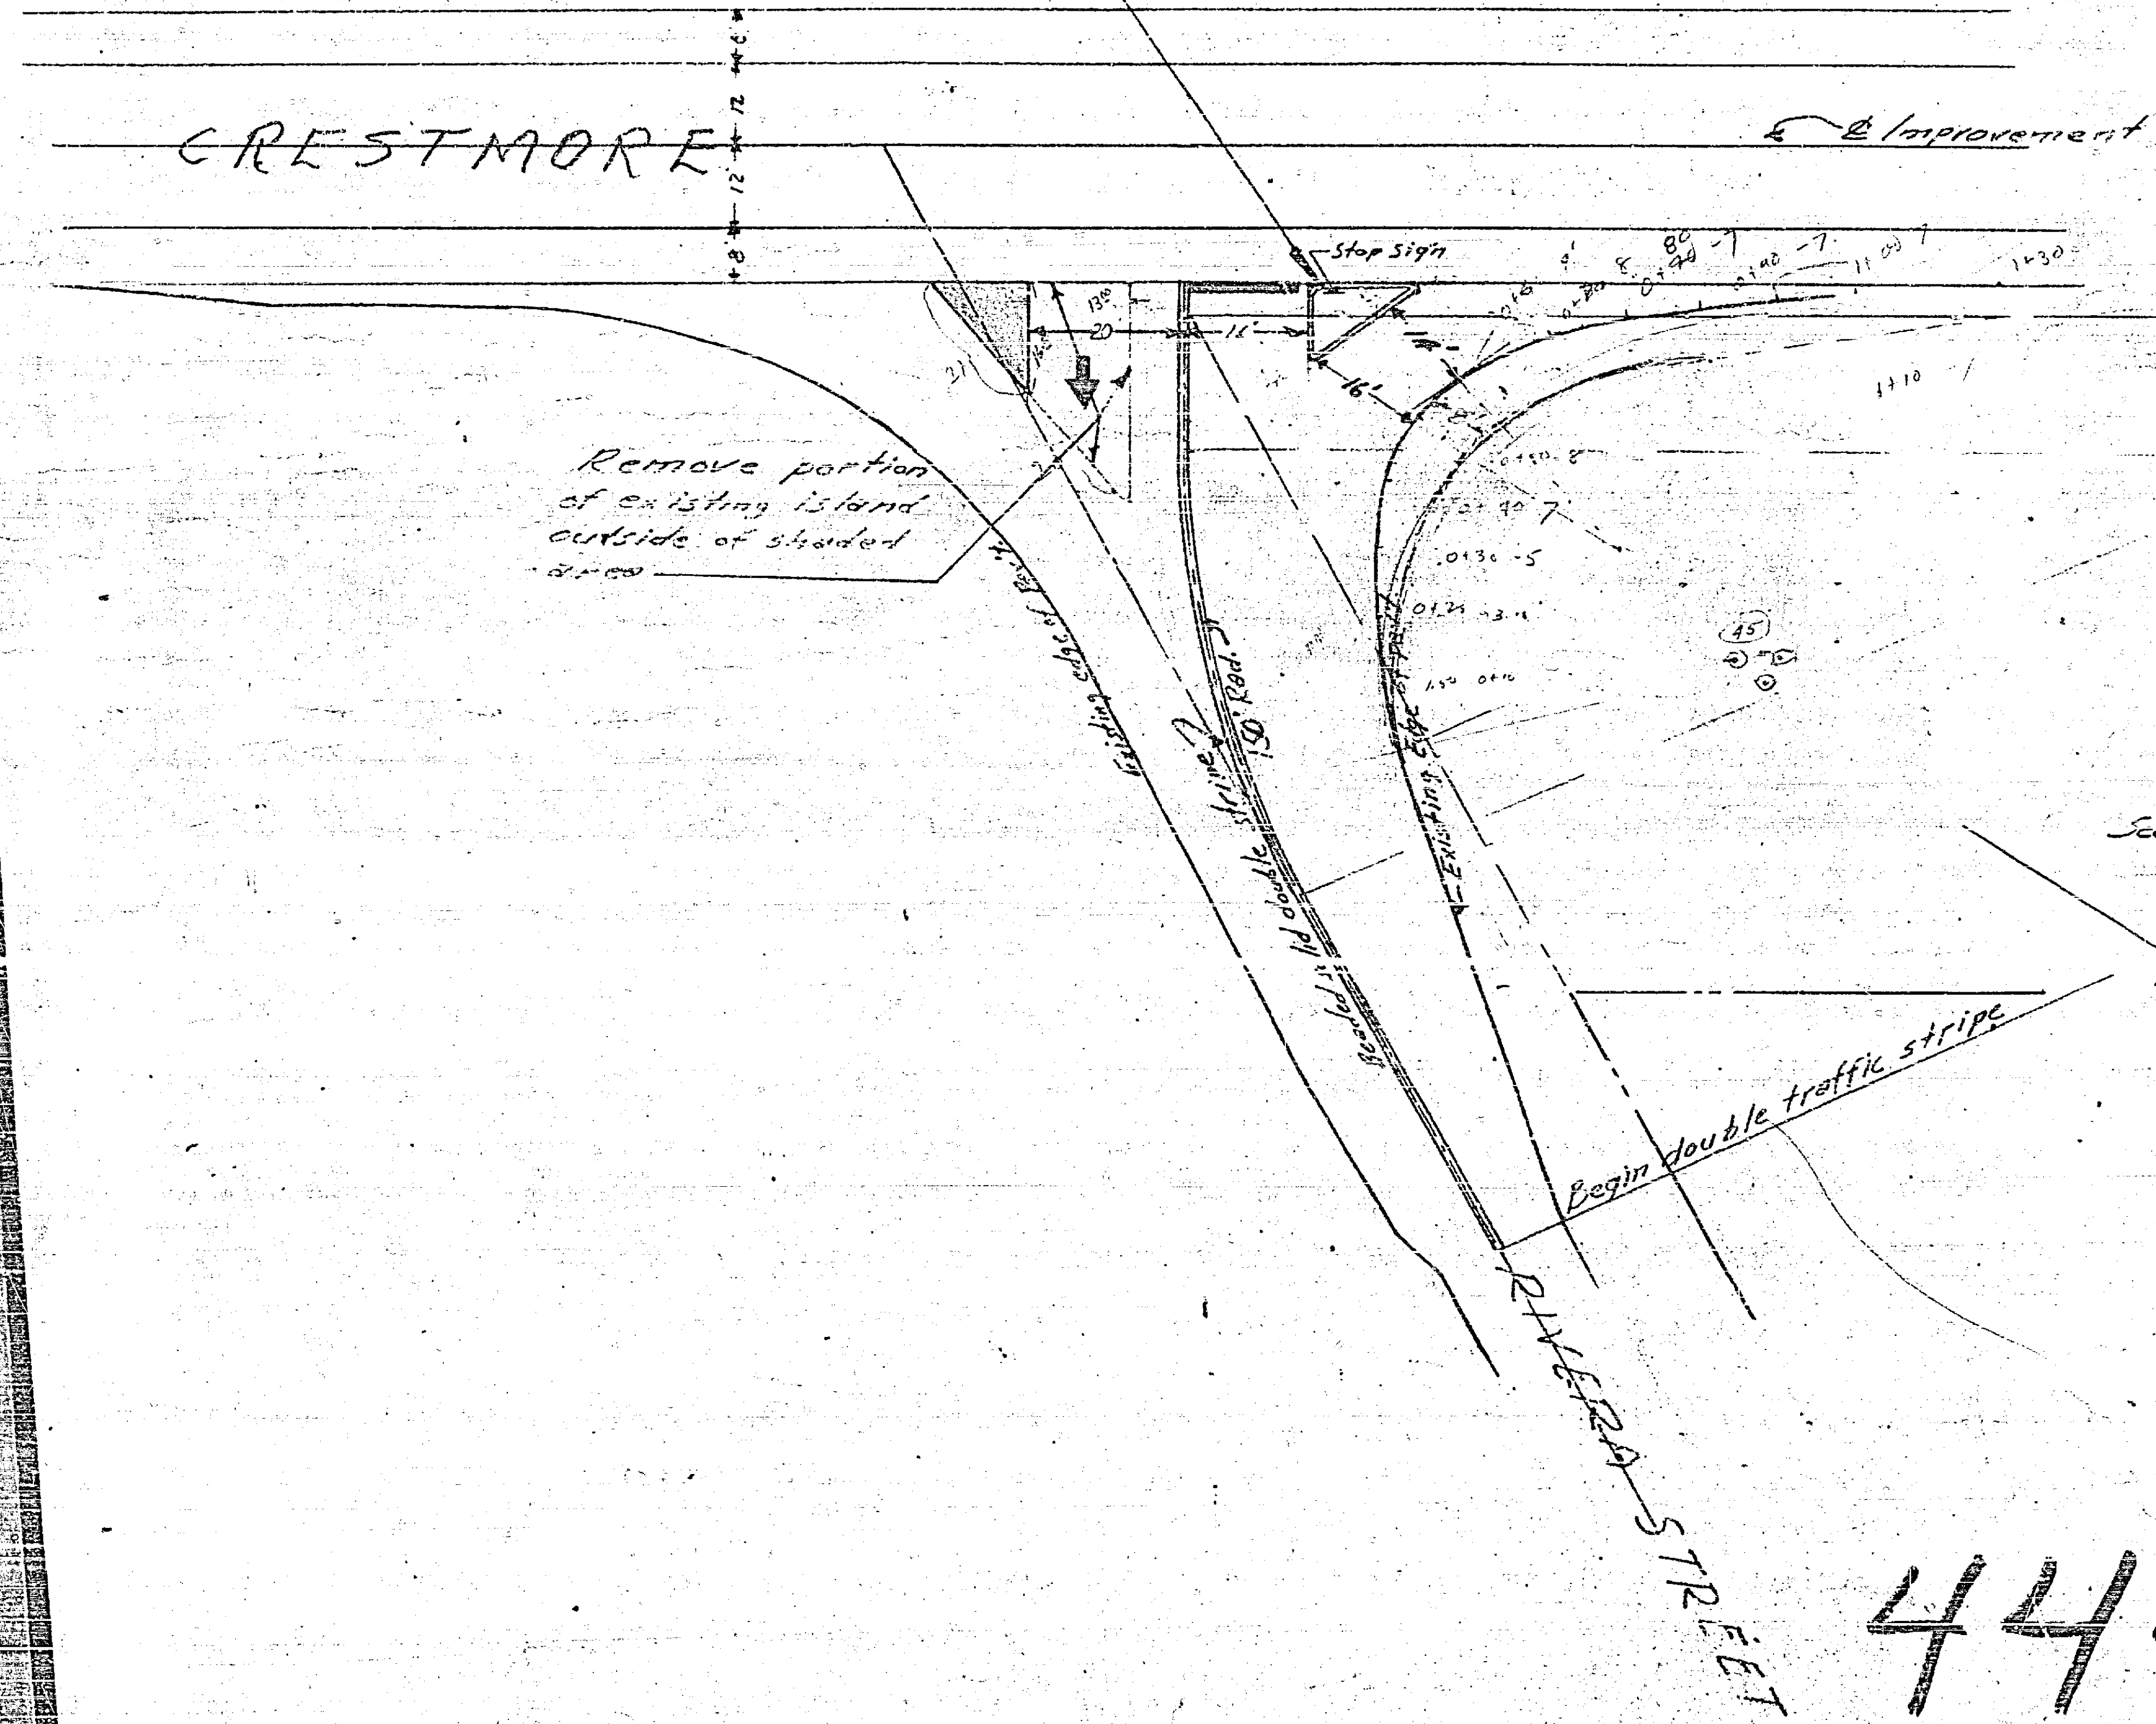

Scale: 1"=20'

REVISED  
RIVERA STREET  
INTERSECTION

444

CRESTMORE Ave Project  
File With S-444