


DIST. No.	STATE	PROJECT No.	FISCAL YEAR	SHEET No.	TOTAL SHEETS
	CALIF.				
COUNTY	ROUTE	SECTION	SHEET	TOTAL SHEETS	

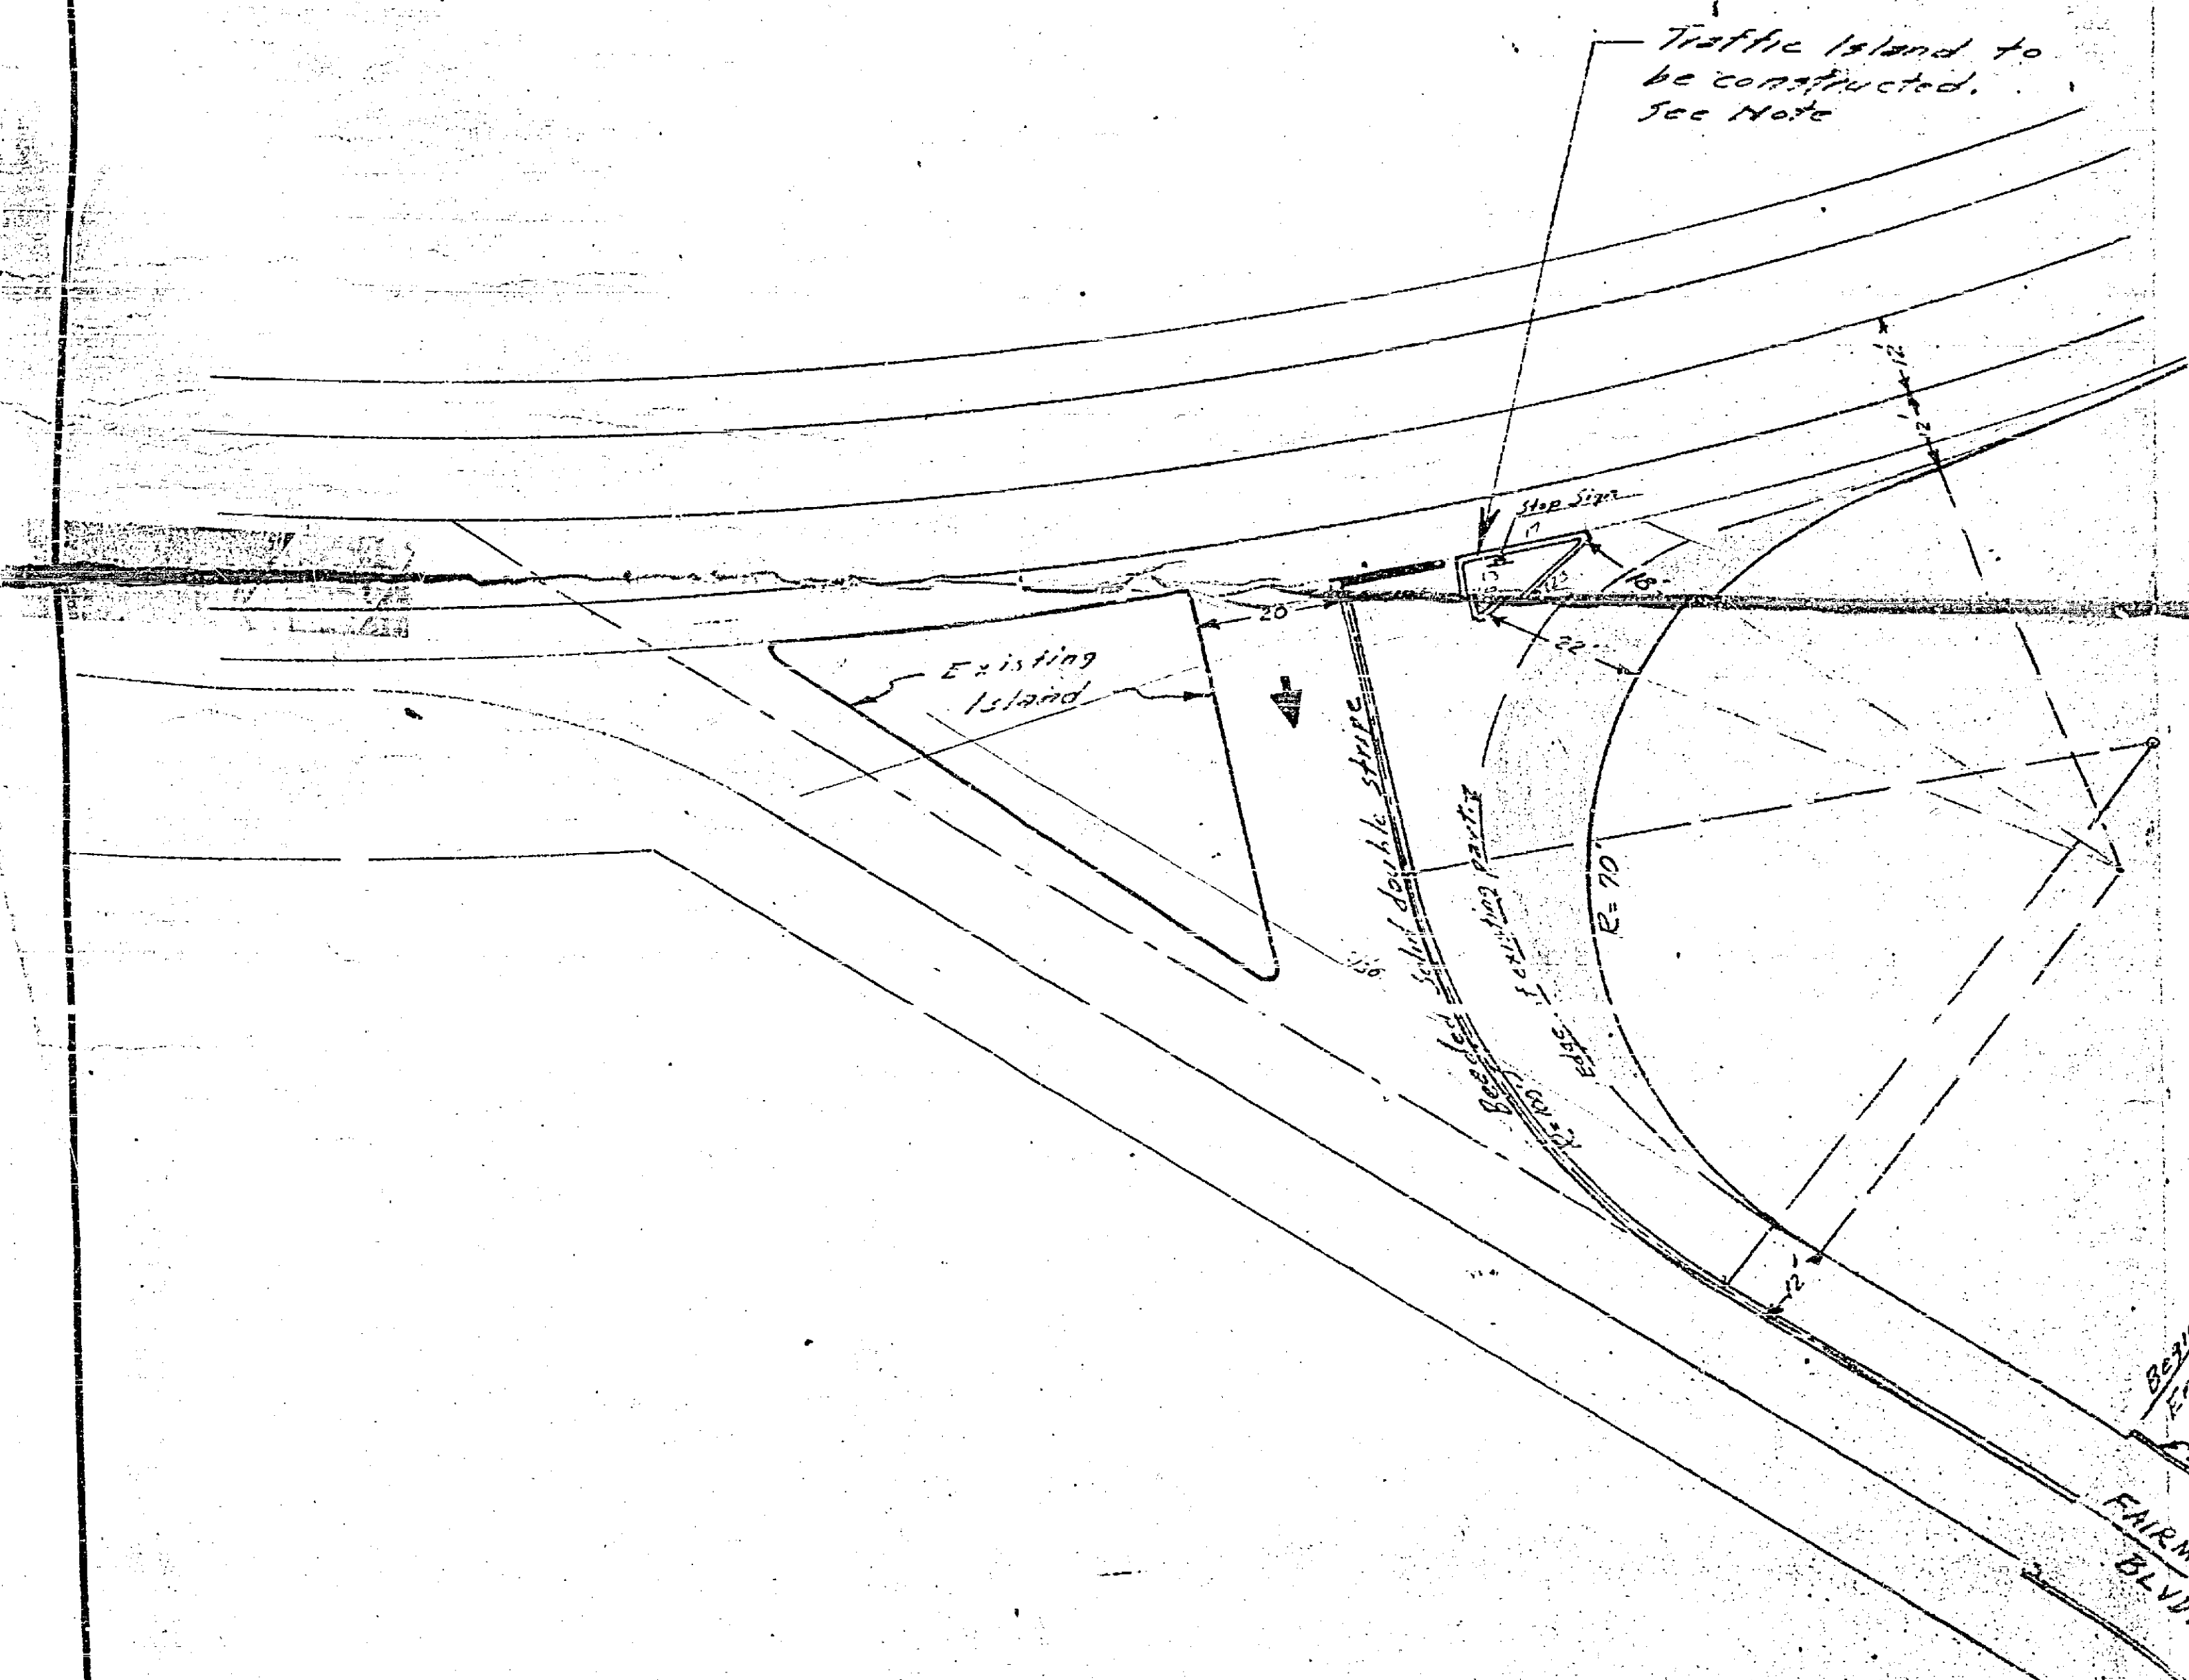

Note:
 Temporary traffic island formed by
 heated white line 12" wide.
 (Permanent island would be
 constructed with raised bars
 or curbed with Type C1 or
 Type C3 curb)

Proposed pavement widening

*Revised curb double stripe
 and of Standard Single Traffic Strip*

444

REVISED
 FAIRMOUNT BLVD
 INTERSECTION
 Scale 1" = 20'