



PROSPECT AVE. VICTORIA AVE. TO HIGH ST.			
DRAWING NUMBER	SHEET NUMBER	TOTAL SHEETS	FIELD BOOKS
3407A	1	3	182/19
DRAWN BY	CHECKED BY	APPROVED BY	

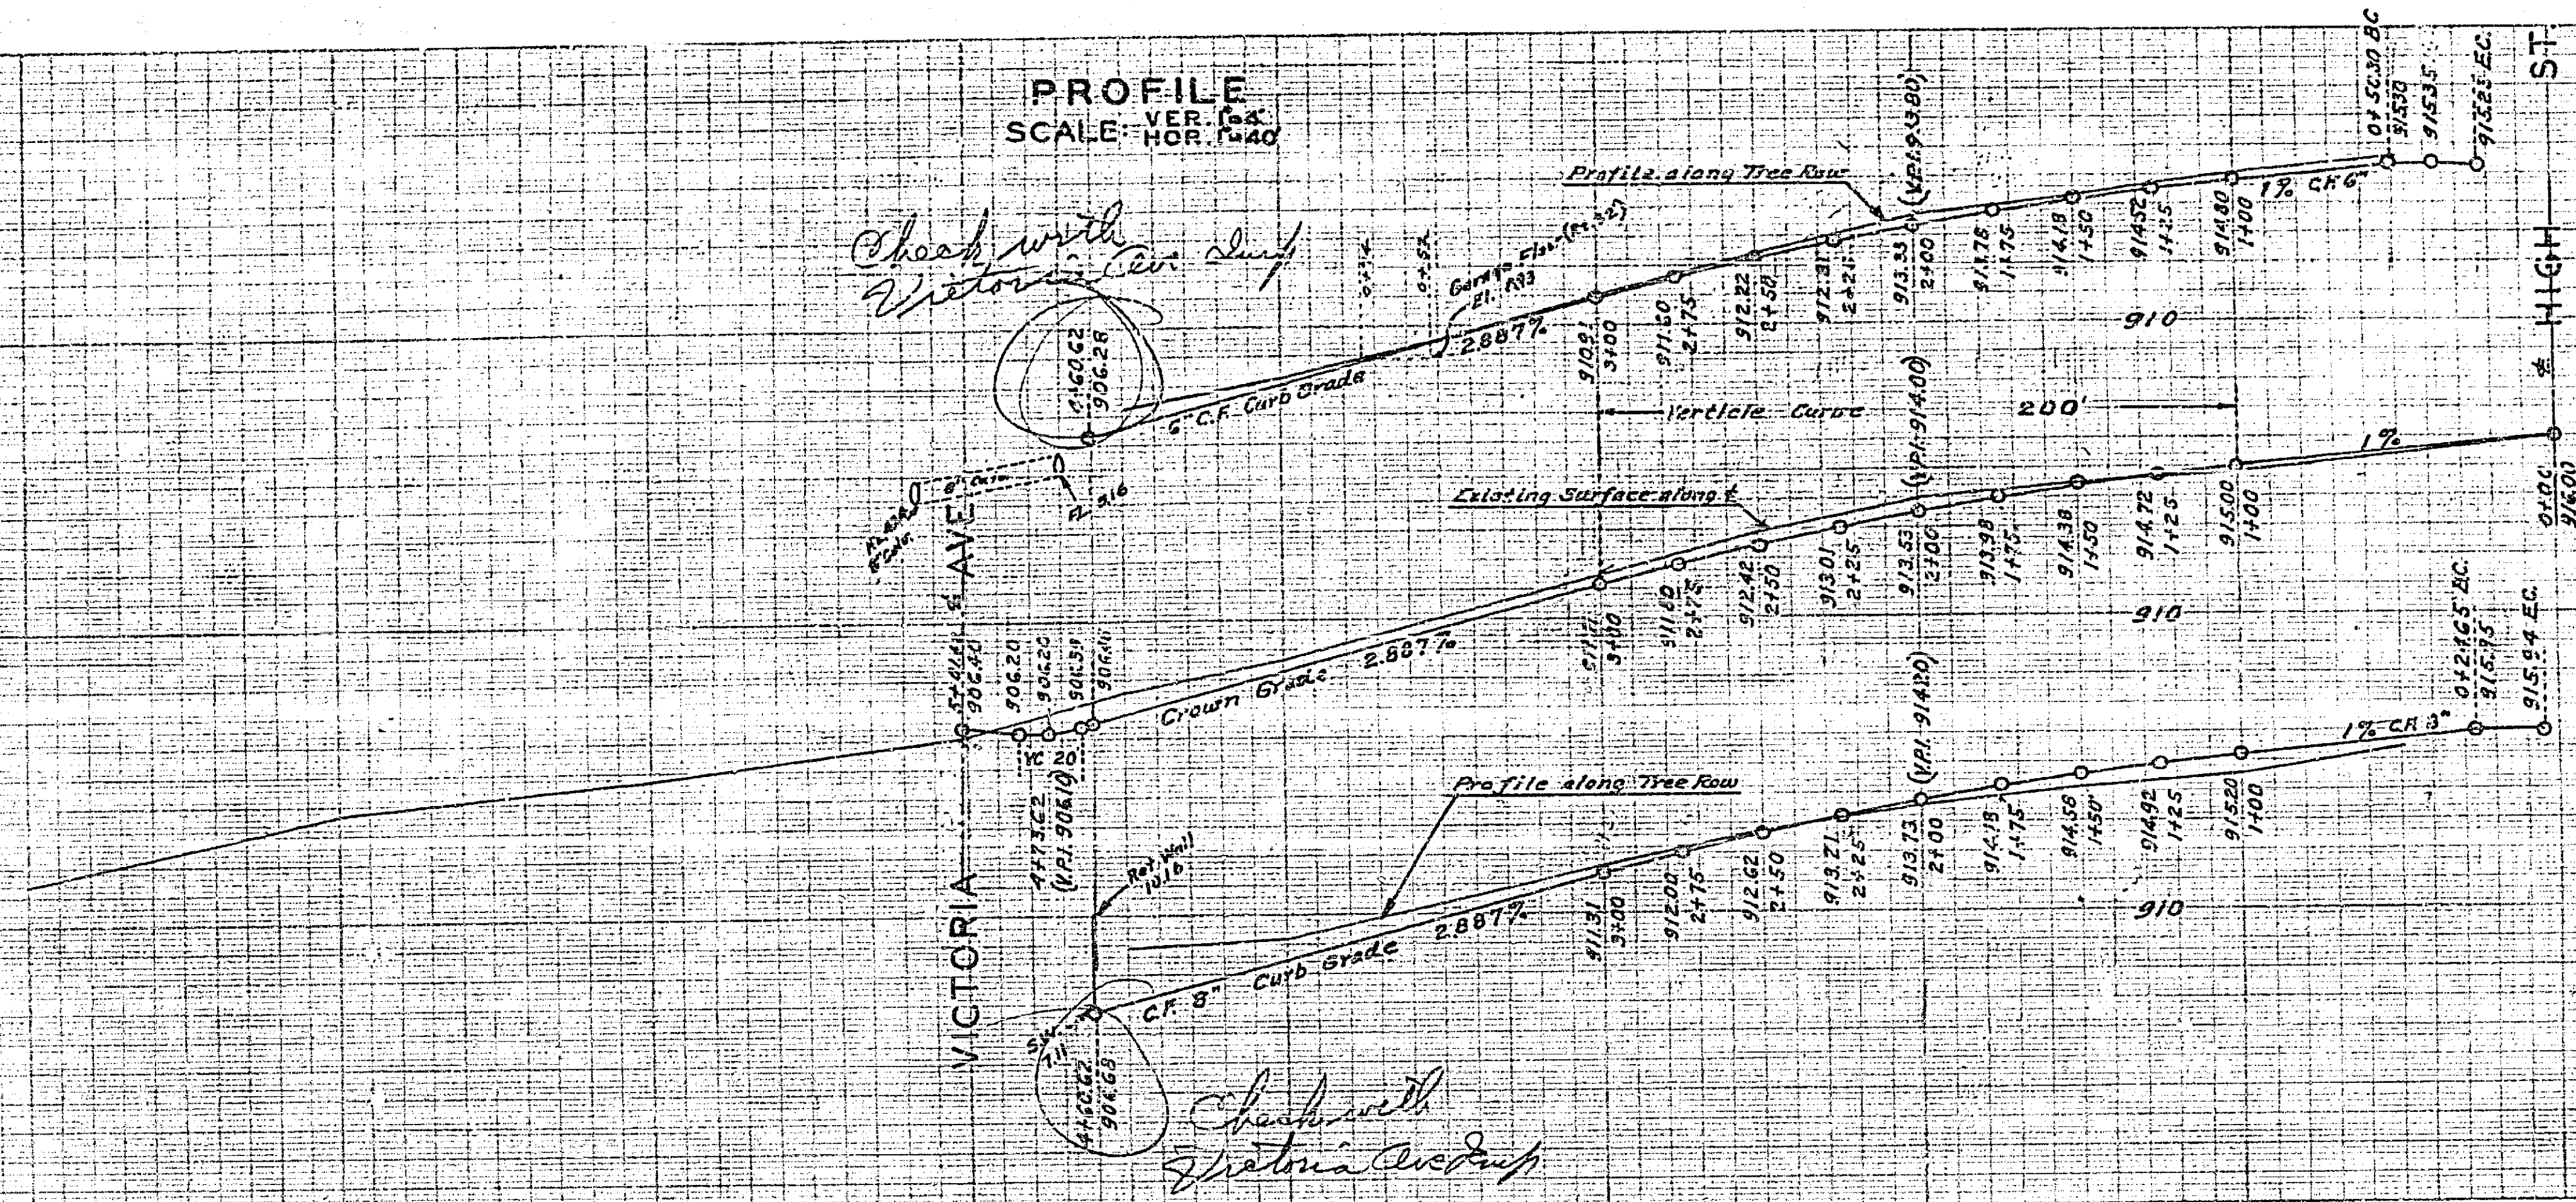

PLAN AND PROFILE OF THE PROPOSED IMPROVEMENT OF PROSPECT AVENUE BETWEEN VICTORIA AVE AND HIGH ST.

ENGINEERING DEPT. RIVERSIDE, CALIF.

PLAN
SCALE 1" = 40'

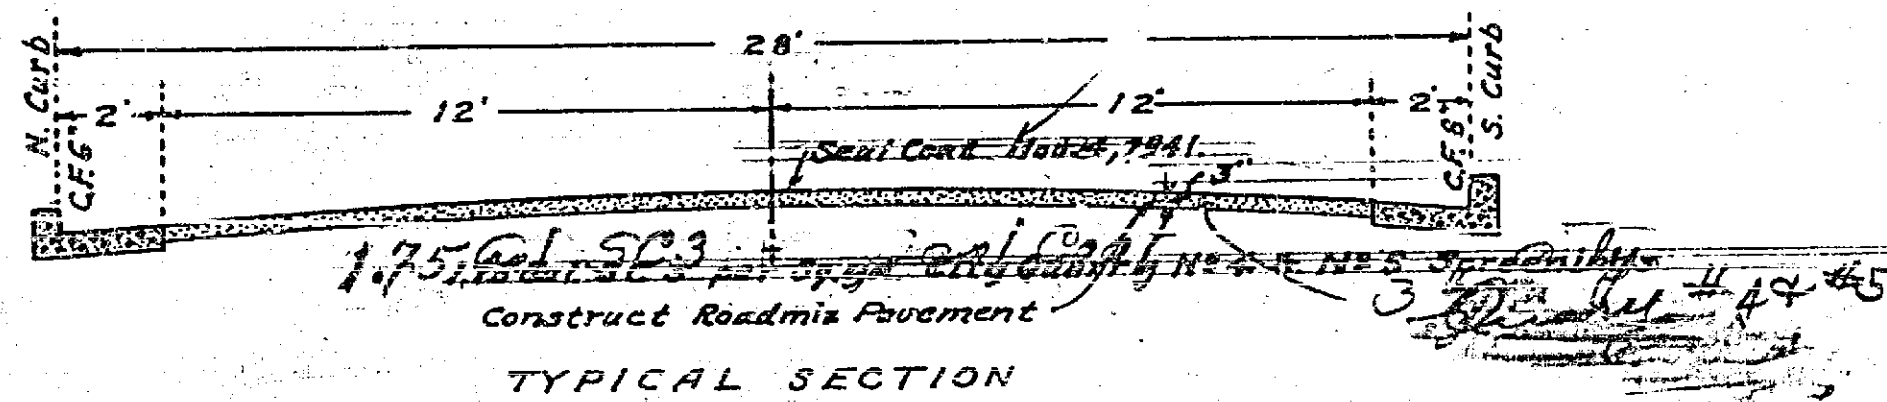

APPROVED CITY ENGINEER
REGISTERED ENGINEER NO. 1312

