

DRAWING NUMBER	SHEET NUMBER	TOTAL SHEETS	FIELD BOOKS
448	1	1	40, 41
DRAWN BY	CHECKED BY	APPROVED BY	

MARIELLA STREET

MAGNOLIA AVE. - MT. VERNON ST. - ORCHARD ST.



ENGINEERING DEPT. RIVERSIDE, CALIF. FEB. 1945.

CITY (U.S.G.S) DATUM PLANE

F.B. 411, PG. 67
" 406, " 56

Constructed by Contractor Ground March 1948
Magnolia Ave. to Mt. Vernon St.

SCALE
H. 1" = 40'
V. 1" = 4'

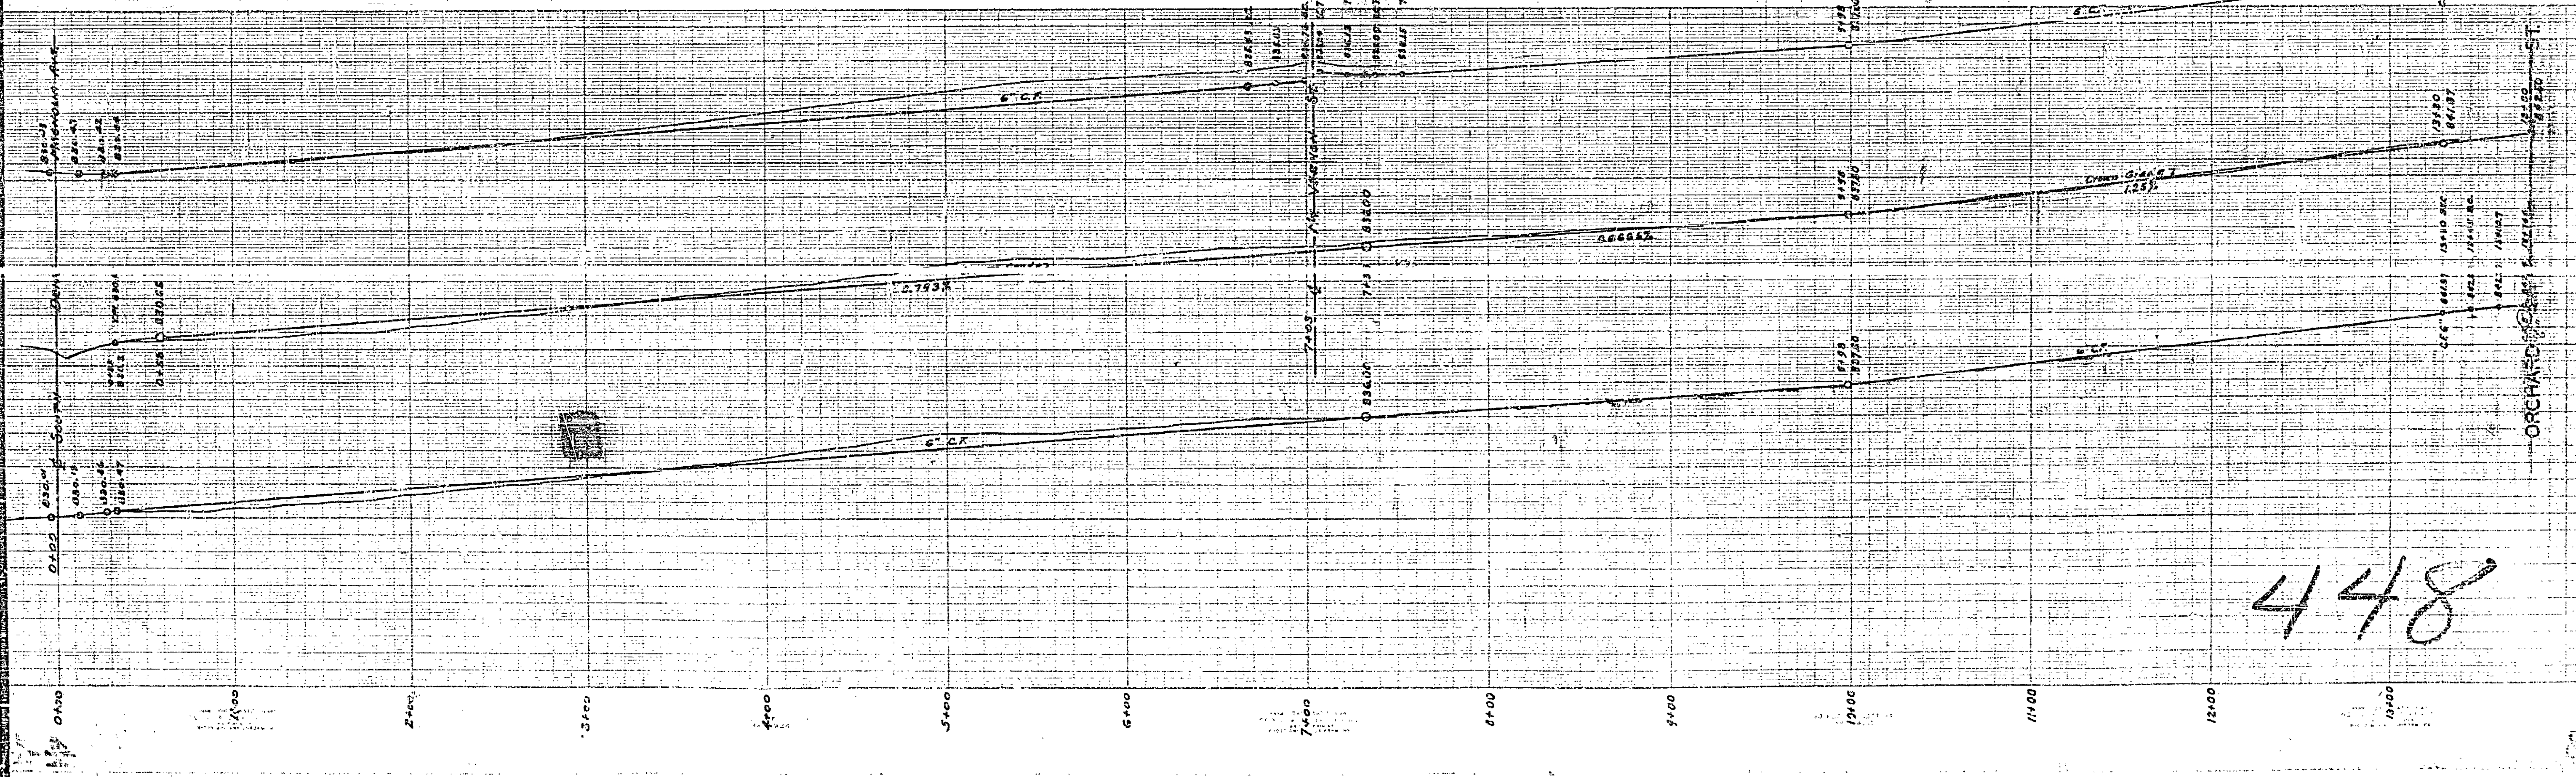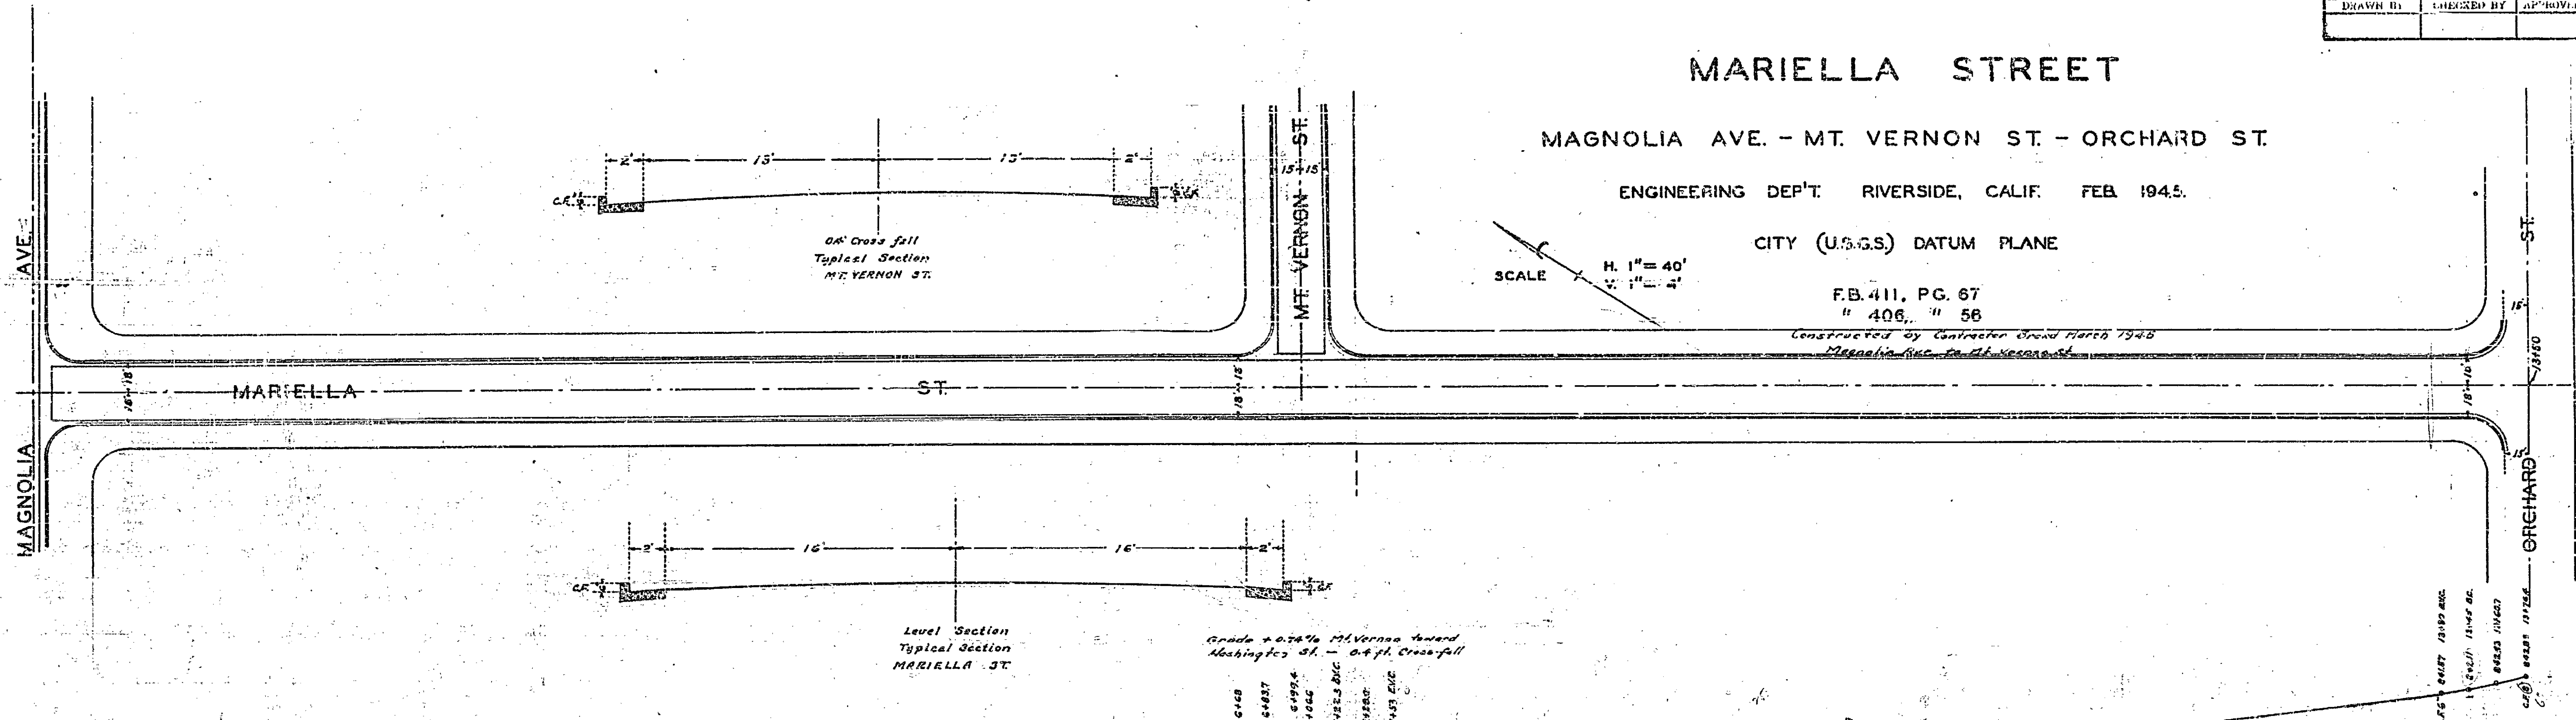

448