



LINCOLN PARK		PLUNGE DRAIN EXTENSION	
Drawing Number:	Sheet Number:	Total Sheet:	Field Book:
12801/1/6/11	1	1	395 B.10
Design:	Checked:	Approved:	

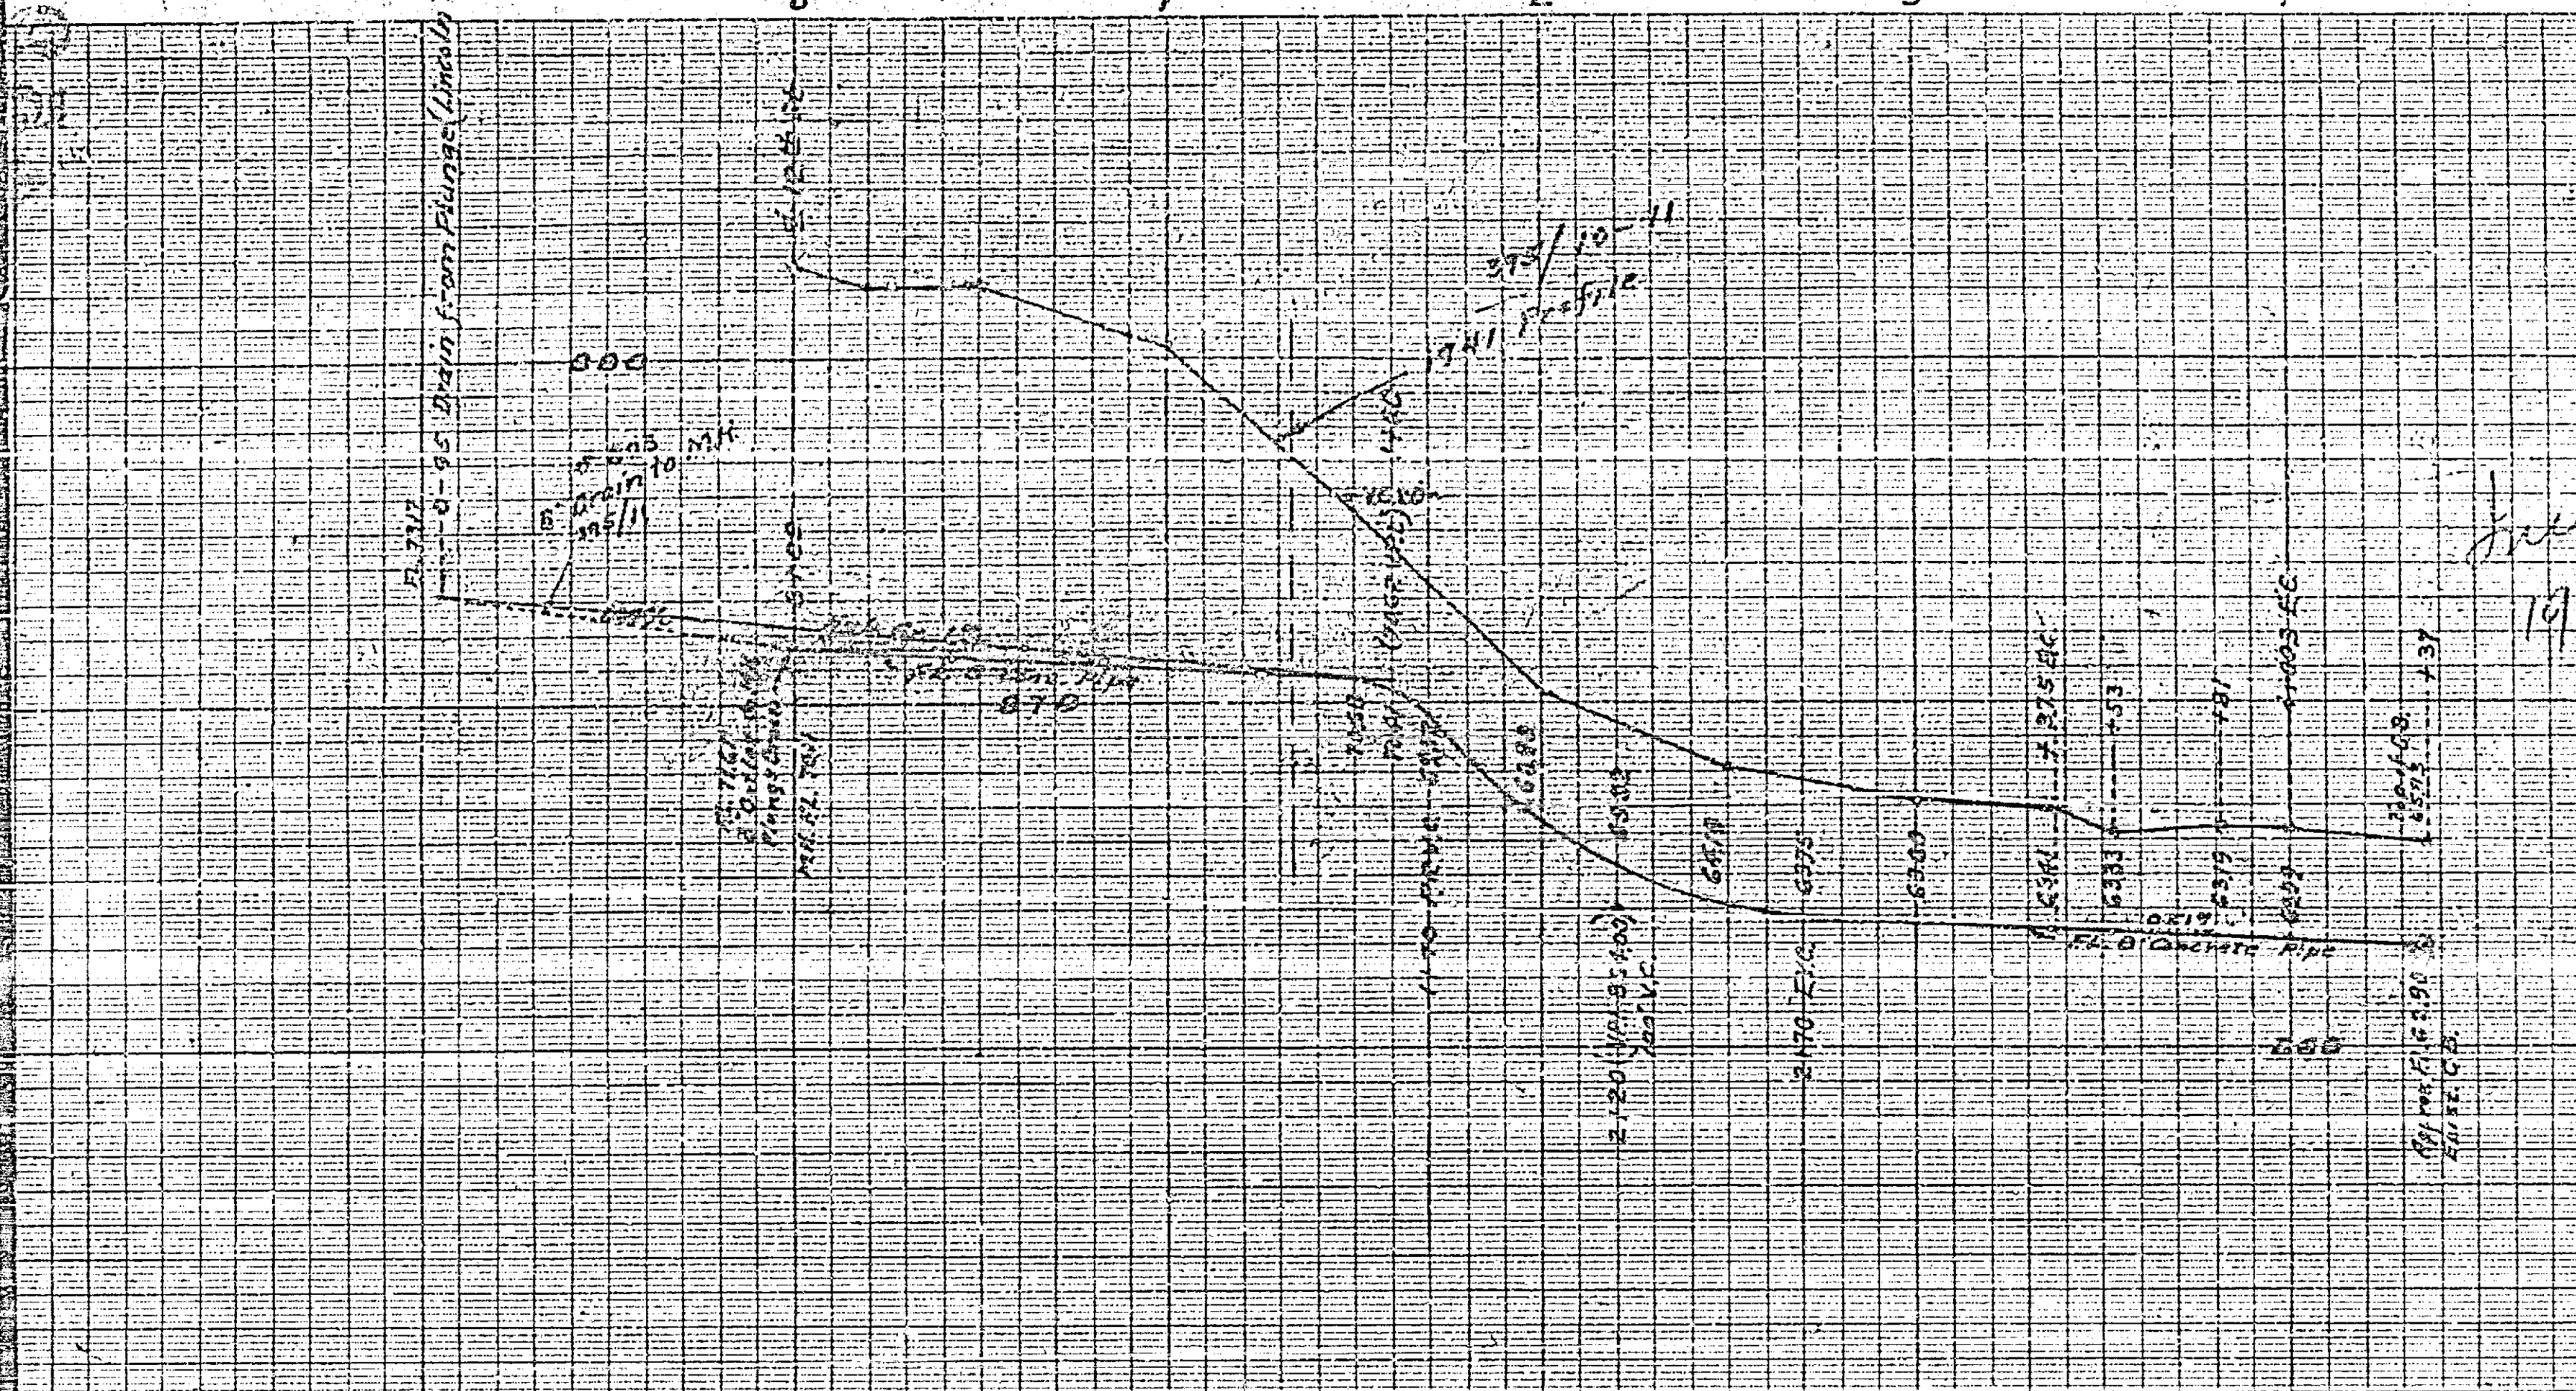

Include in Report
1941-42

SCALE
HOR. 1" = 40'
VER. 1" = 4'

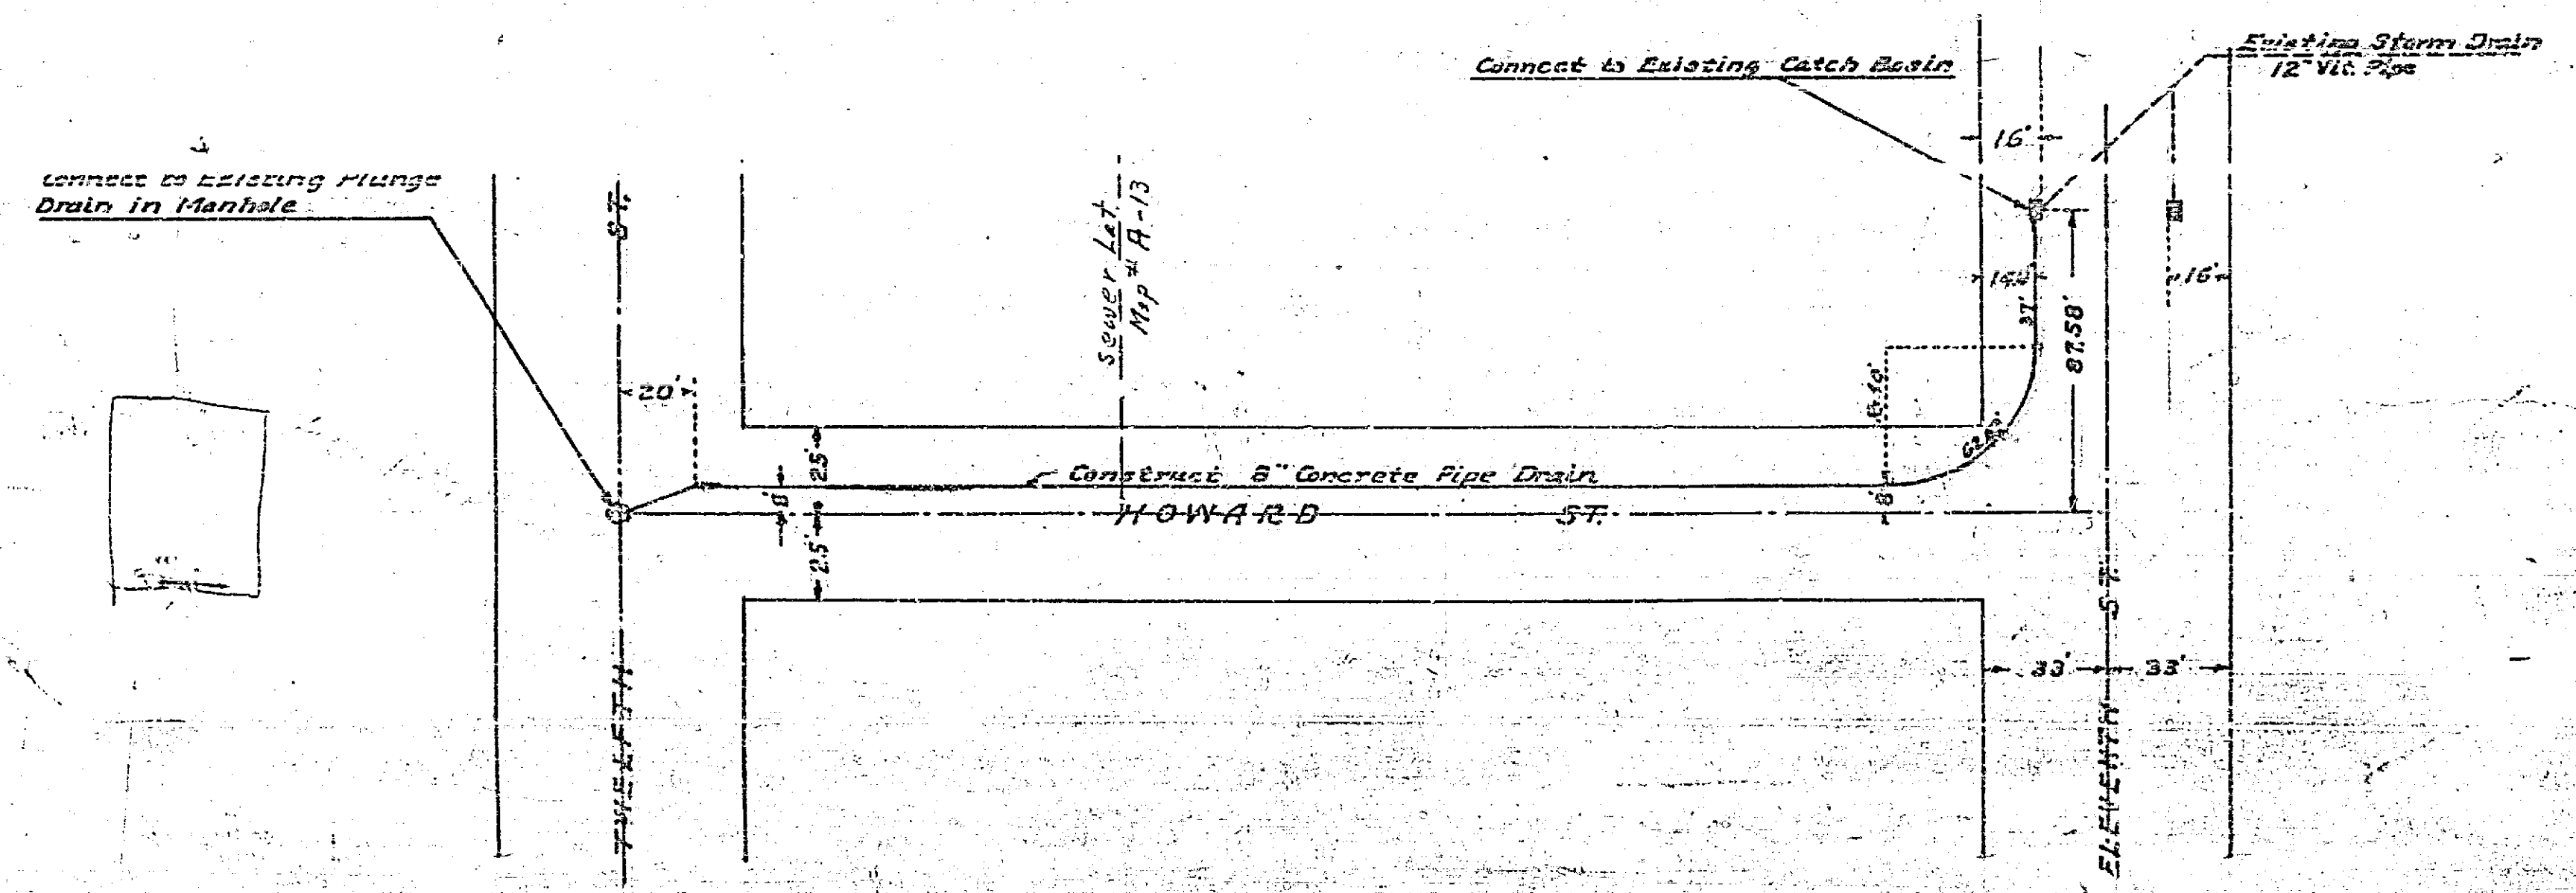

8" pipe with grate
5x5 G.R.M. - 4.H.S

4159