


Proposed Alley between Farnham Pl. & Van Buren St. F.B. 391 PPA.

Alley - Farnham Pl. & Van Buren St.			
DRAWING NUMBER	SHEET NUMBER	TOTAL SHEETS	FIELD BOOKS
1	1	1	391
DRAWN BY		CHECKED BY	APPROVED BY
Sept. 17, 1941		W.L.	

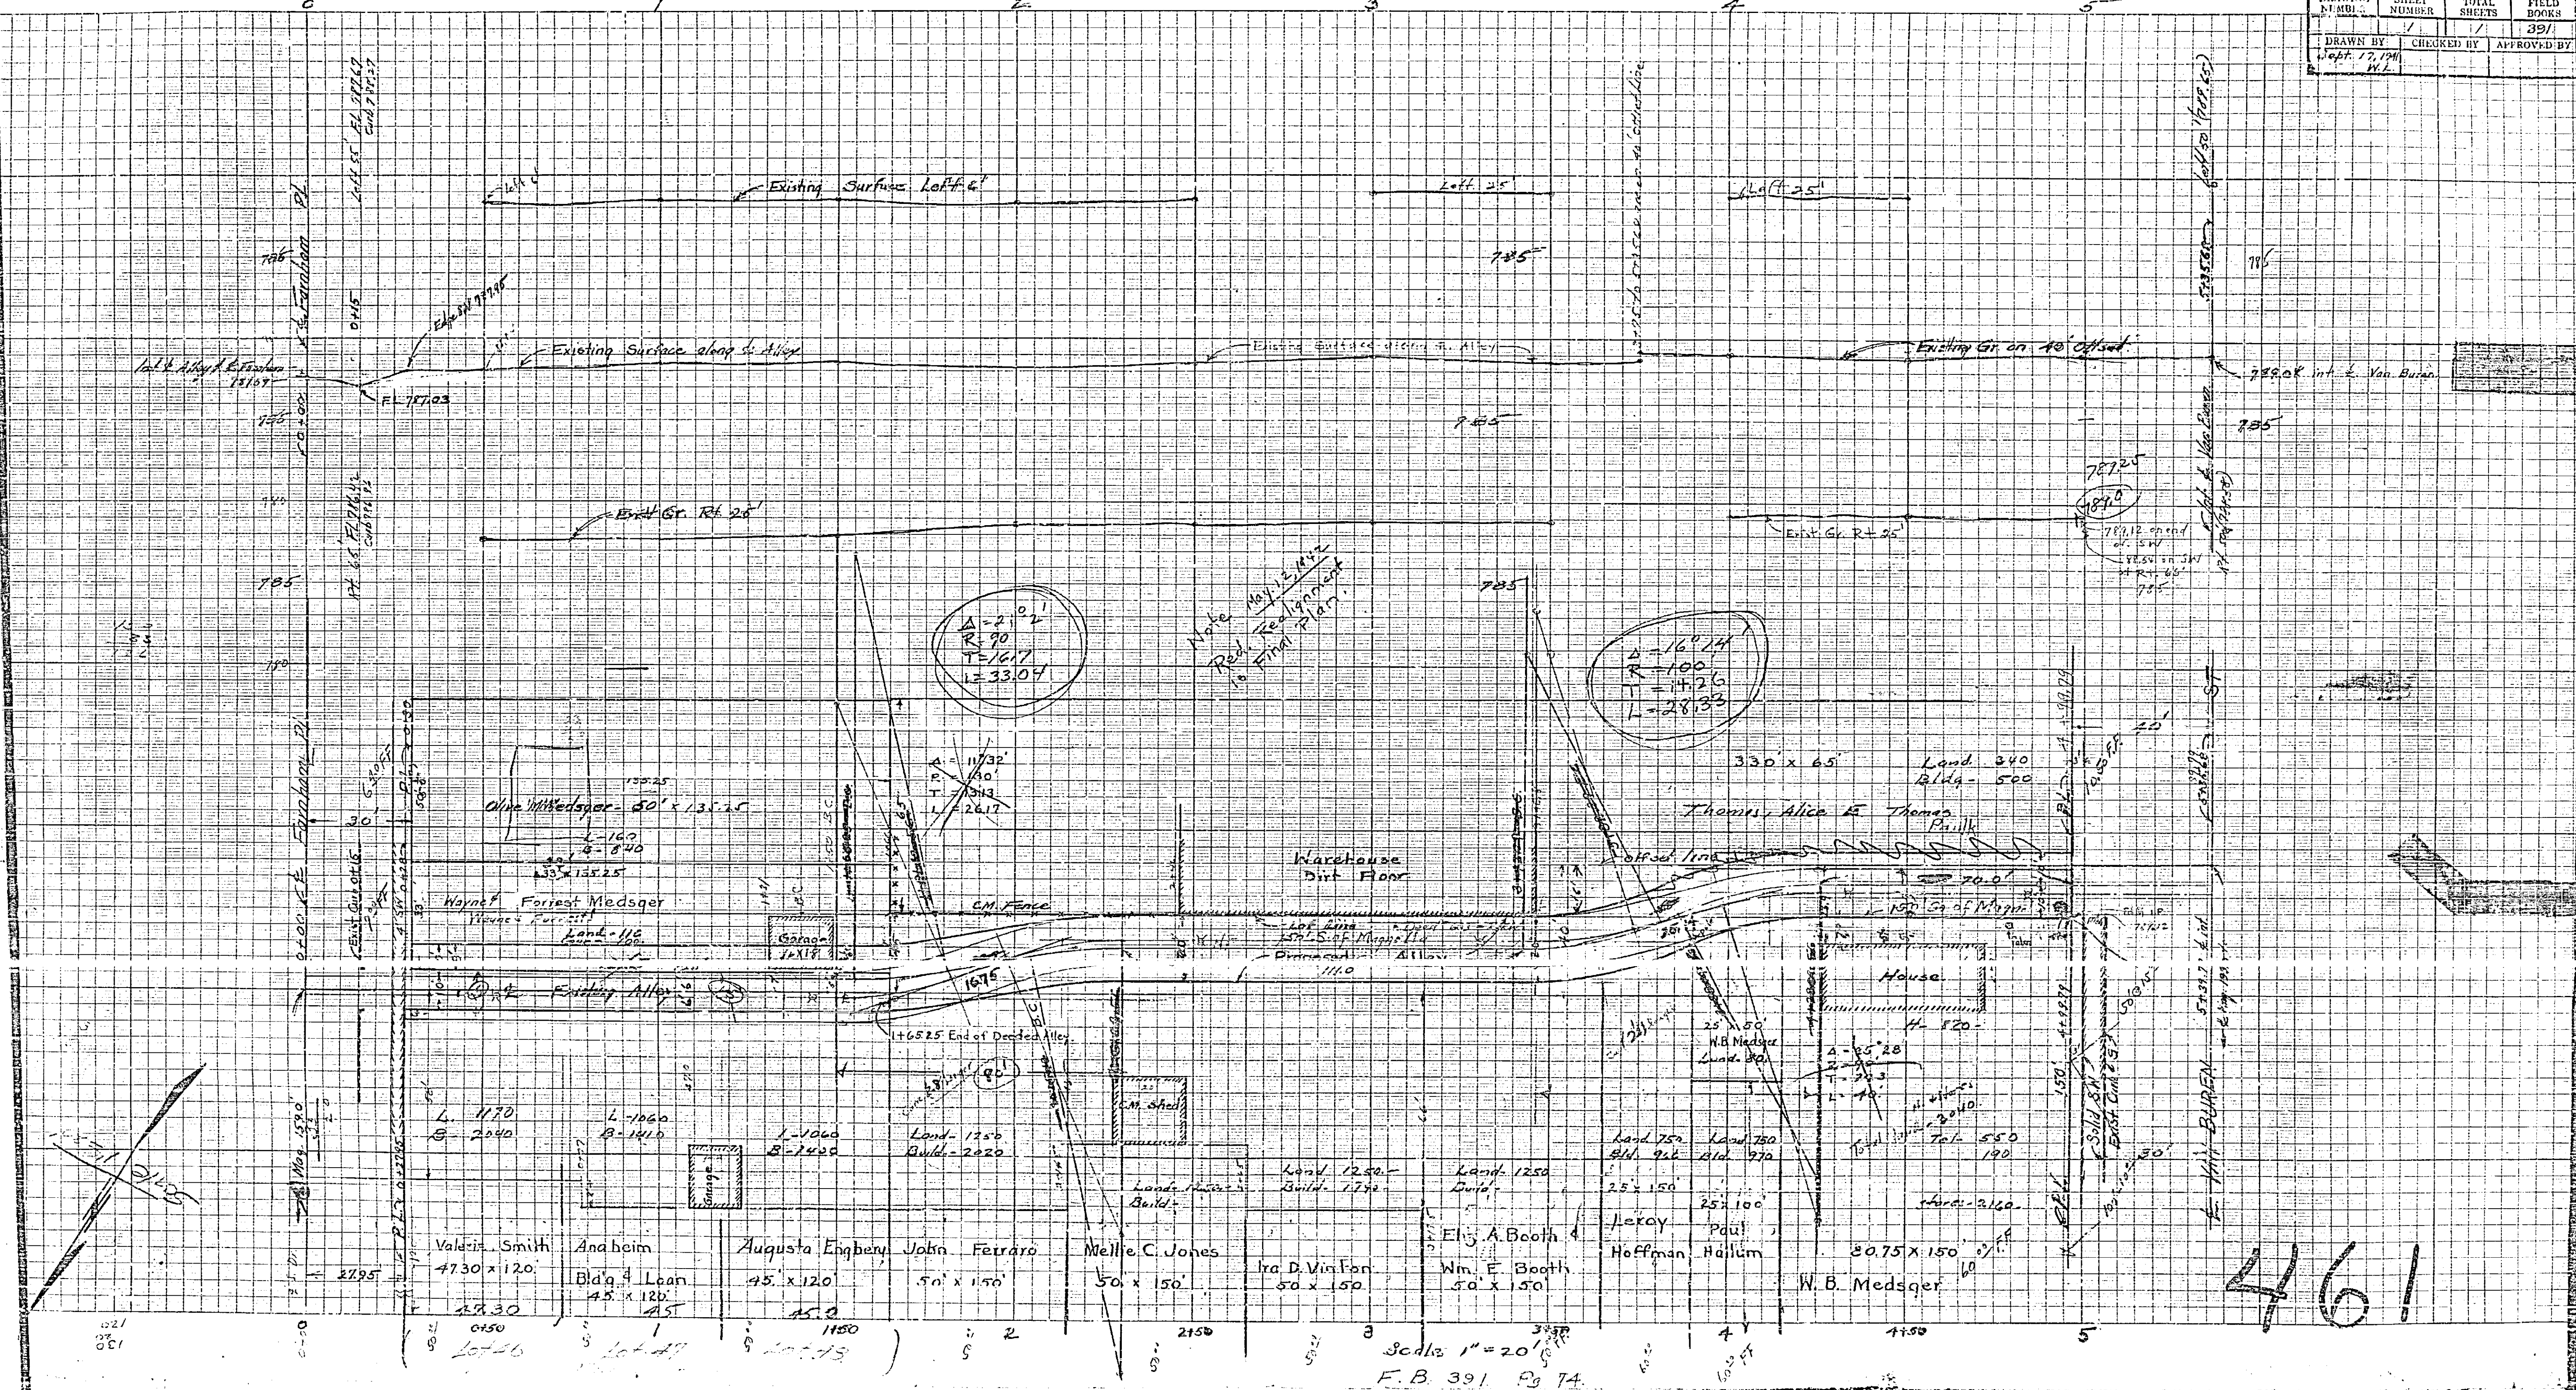

461

Scale 1" = 20'
F.B. 391 P. 74