

STANDARD
GRAPHIC
SCALE
1" = 100'





PROSPECT AVE


Bel. Tarkenton to Victoria Ave

F.B. 28-1944 F.B. 406-p.28

Scale: 1"=20' Hor 1"=4' Ver

SEWER NOTES: F.B. 405-p.27

Constructed 6/14/44

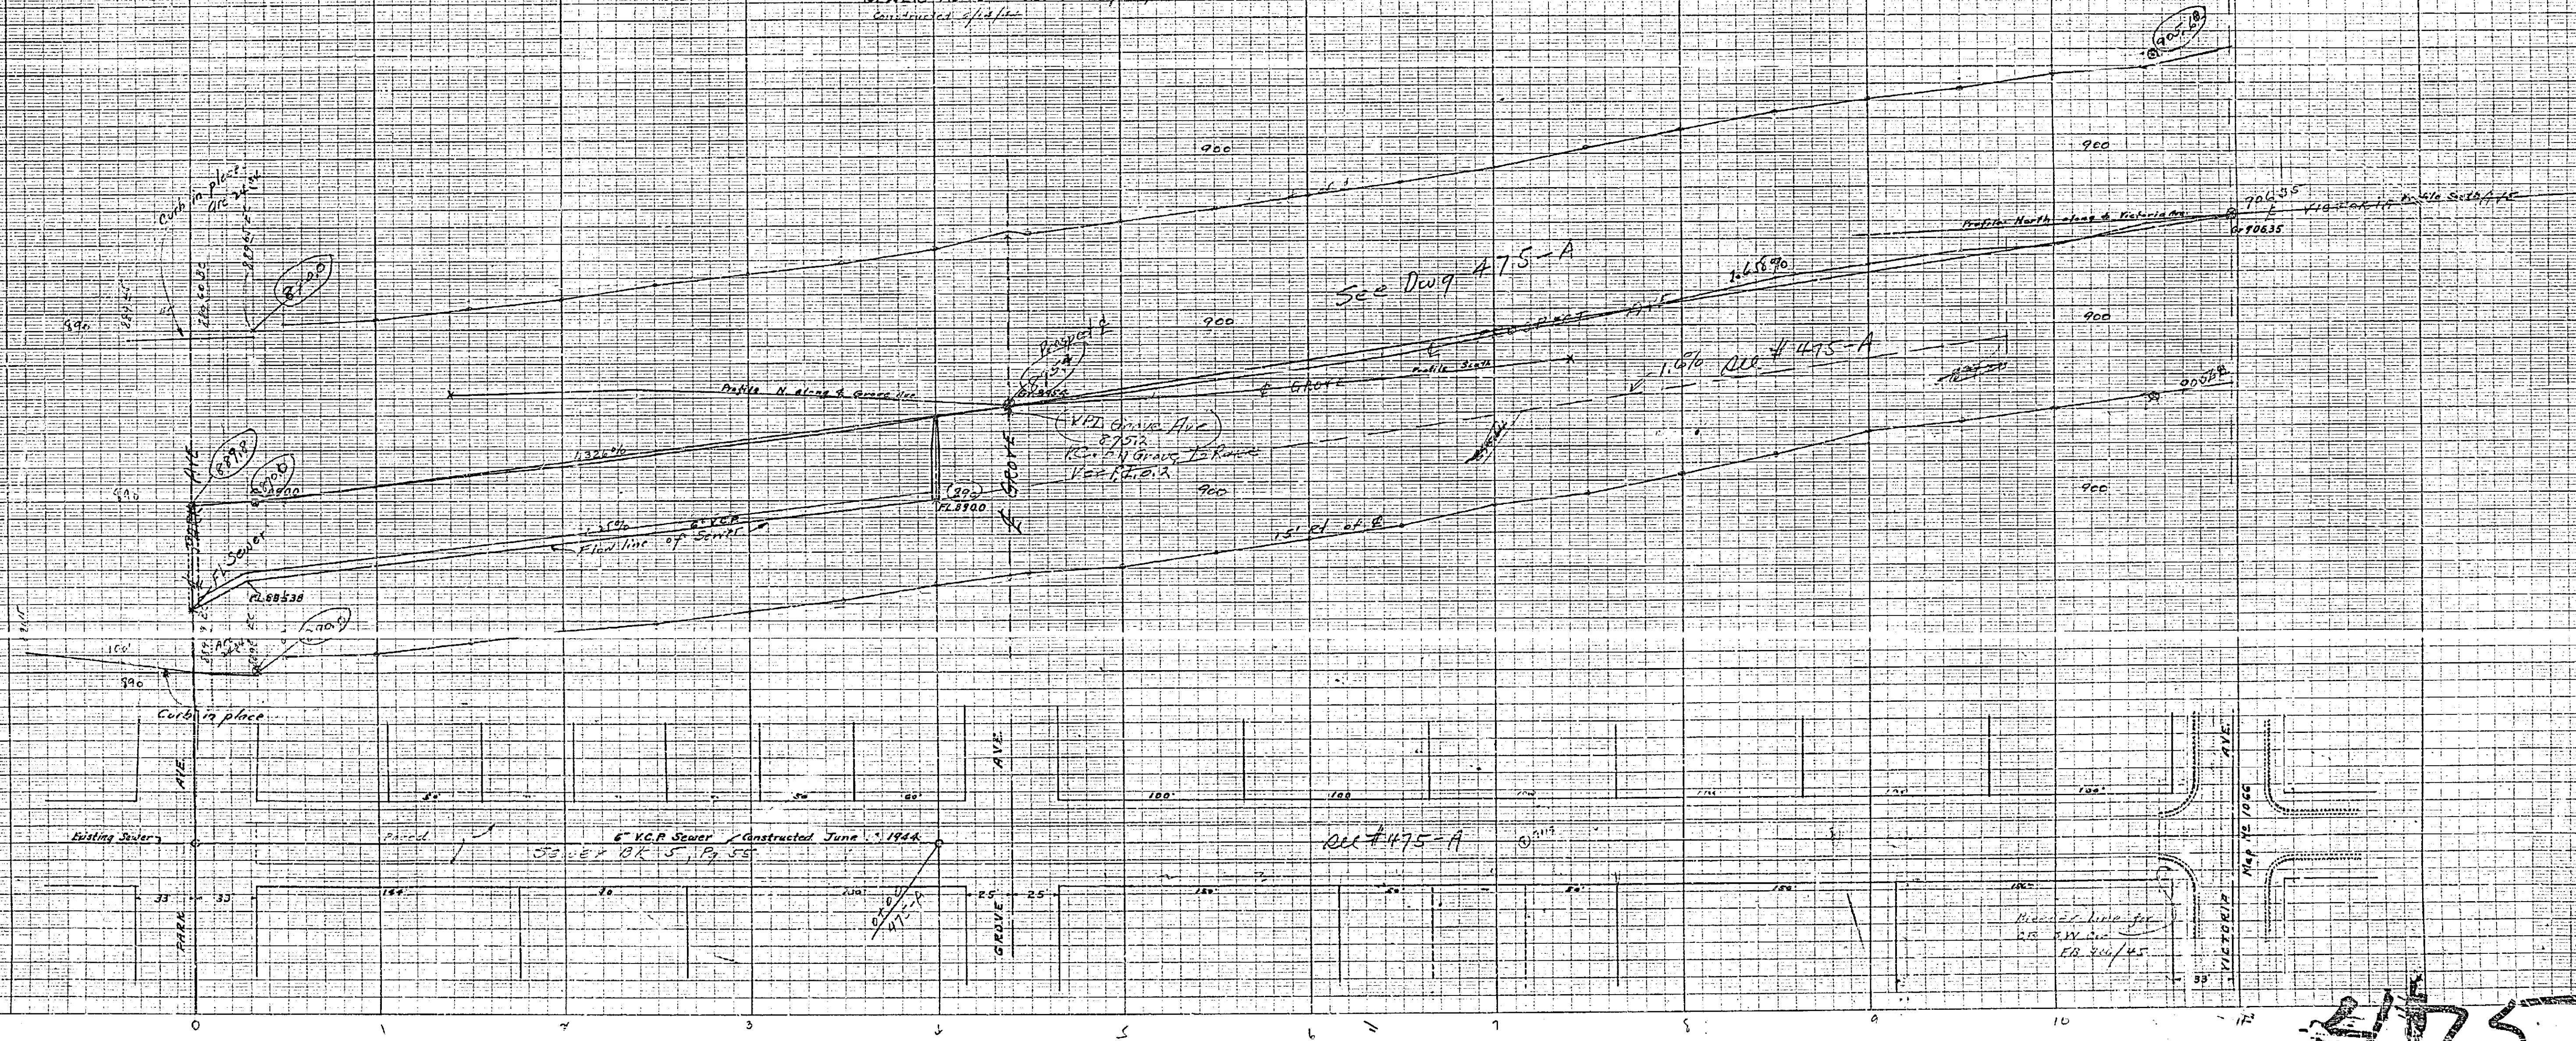

4/75