


MAP OF
Storm Drain

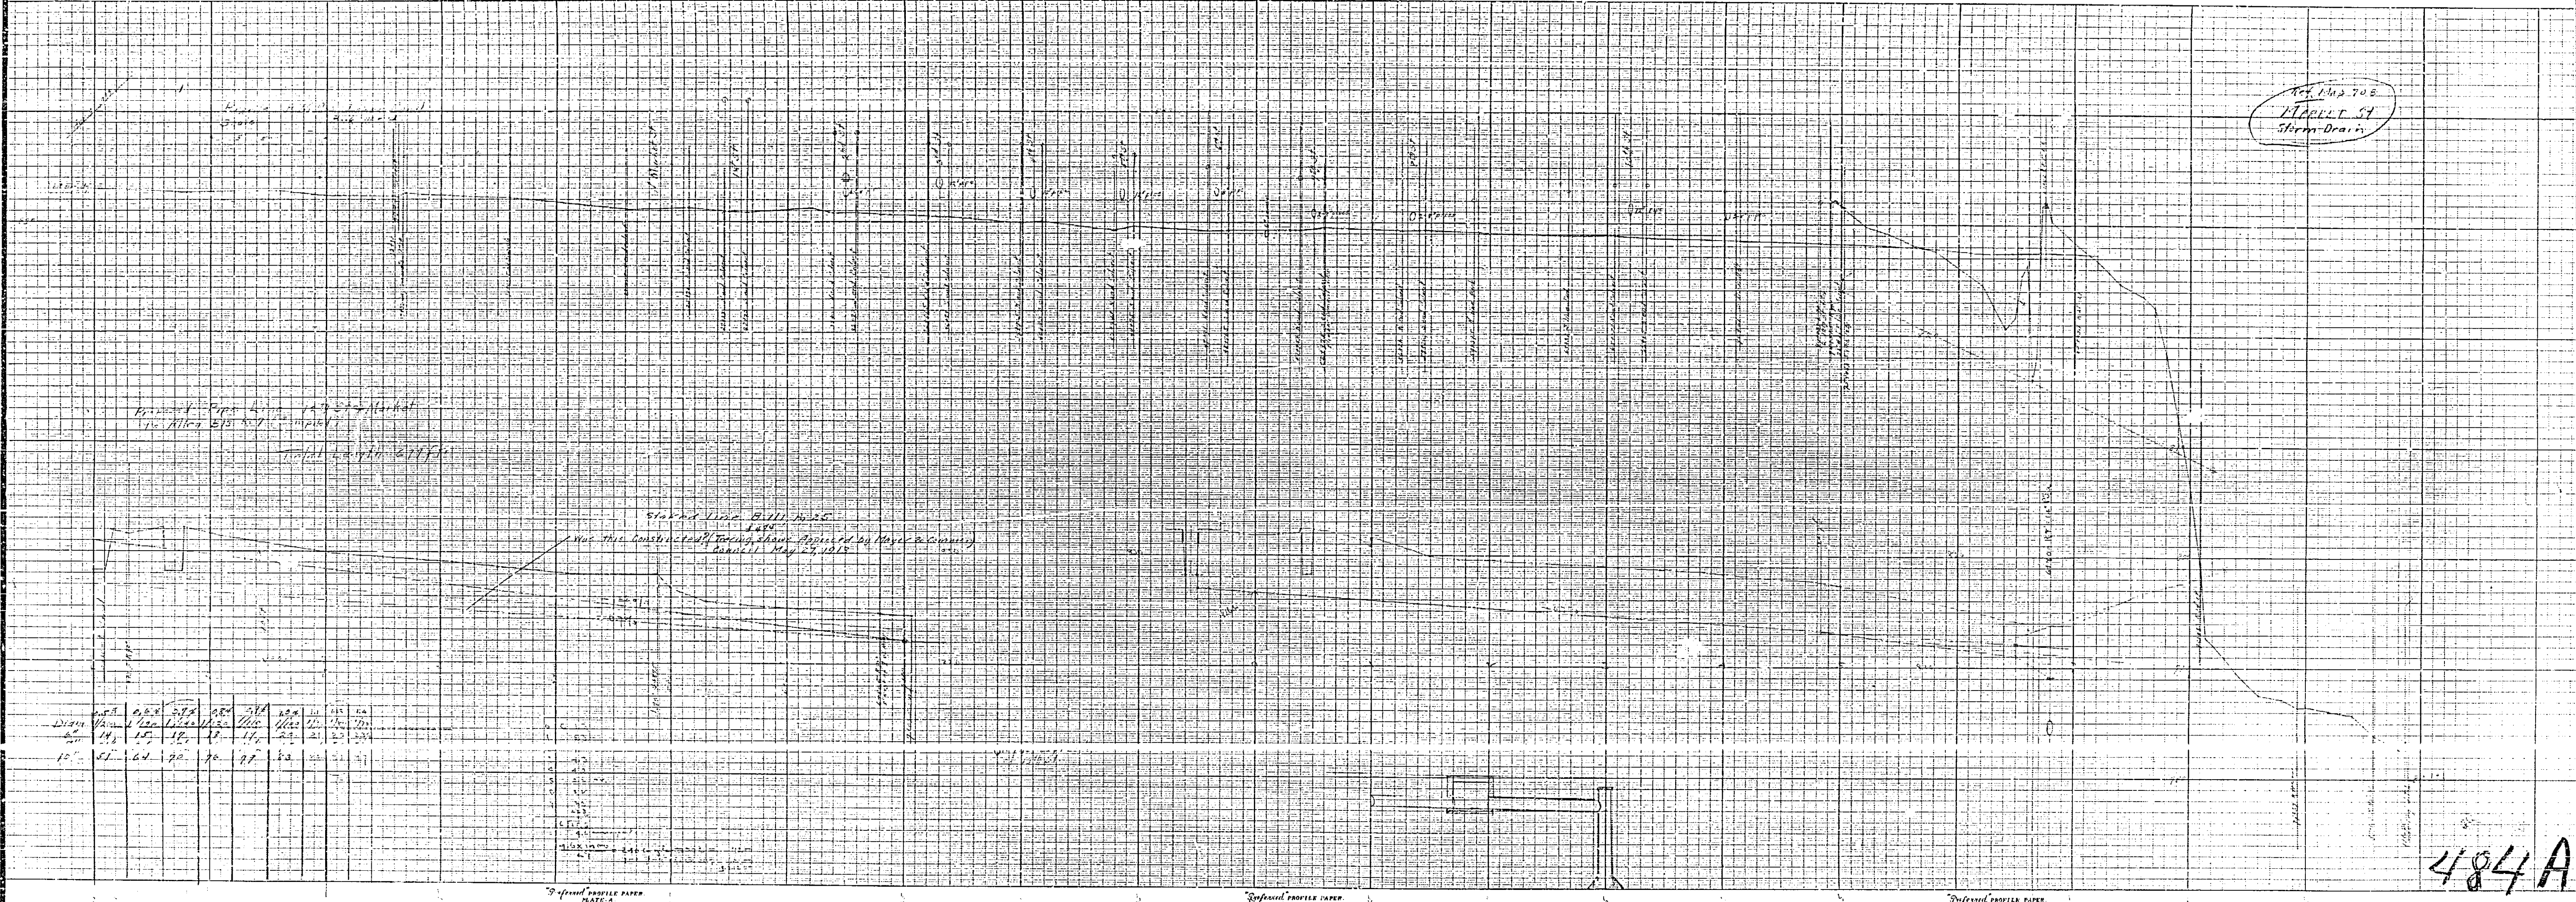

484A