


488

488

459

LOCATION of ELECTRIC POLE LINE from R.A.R.R. CAR BARN to the POWER PLANT LOCATED in EAST RIVERSIDE

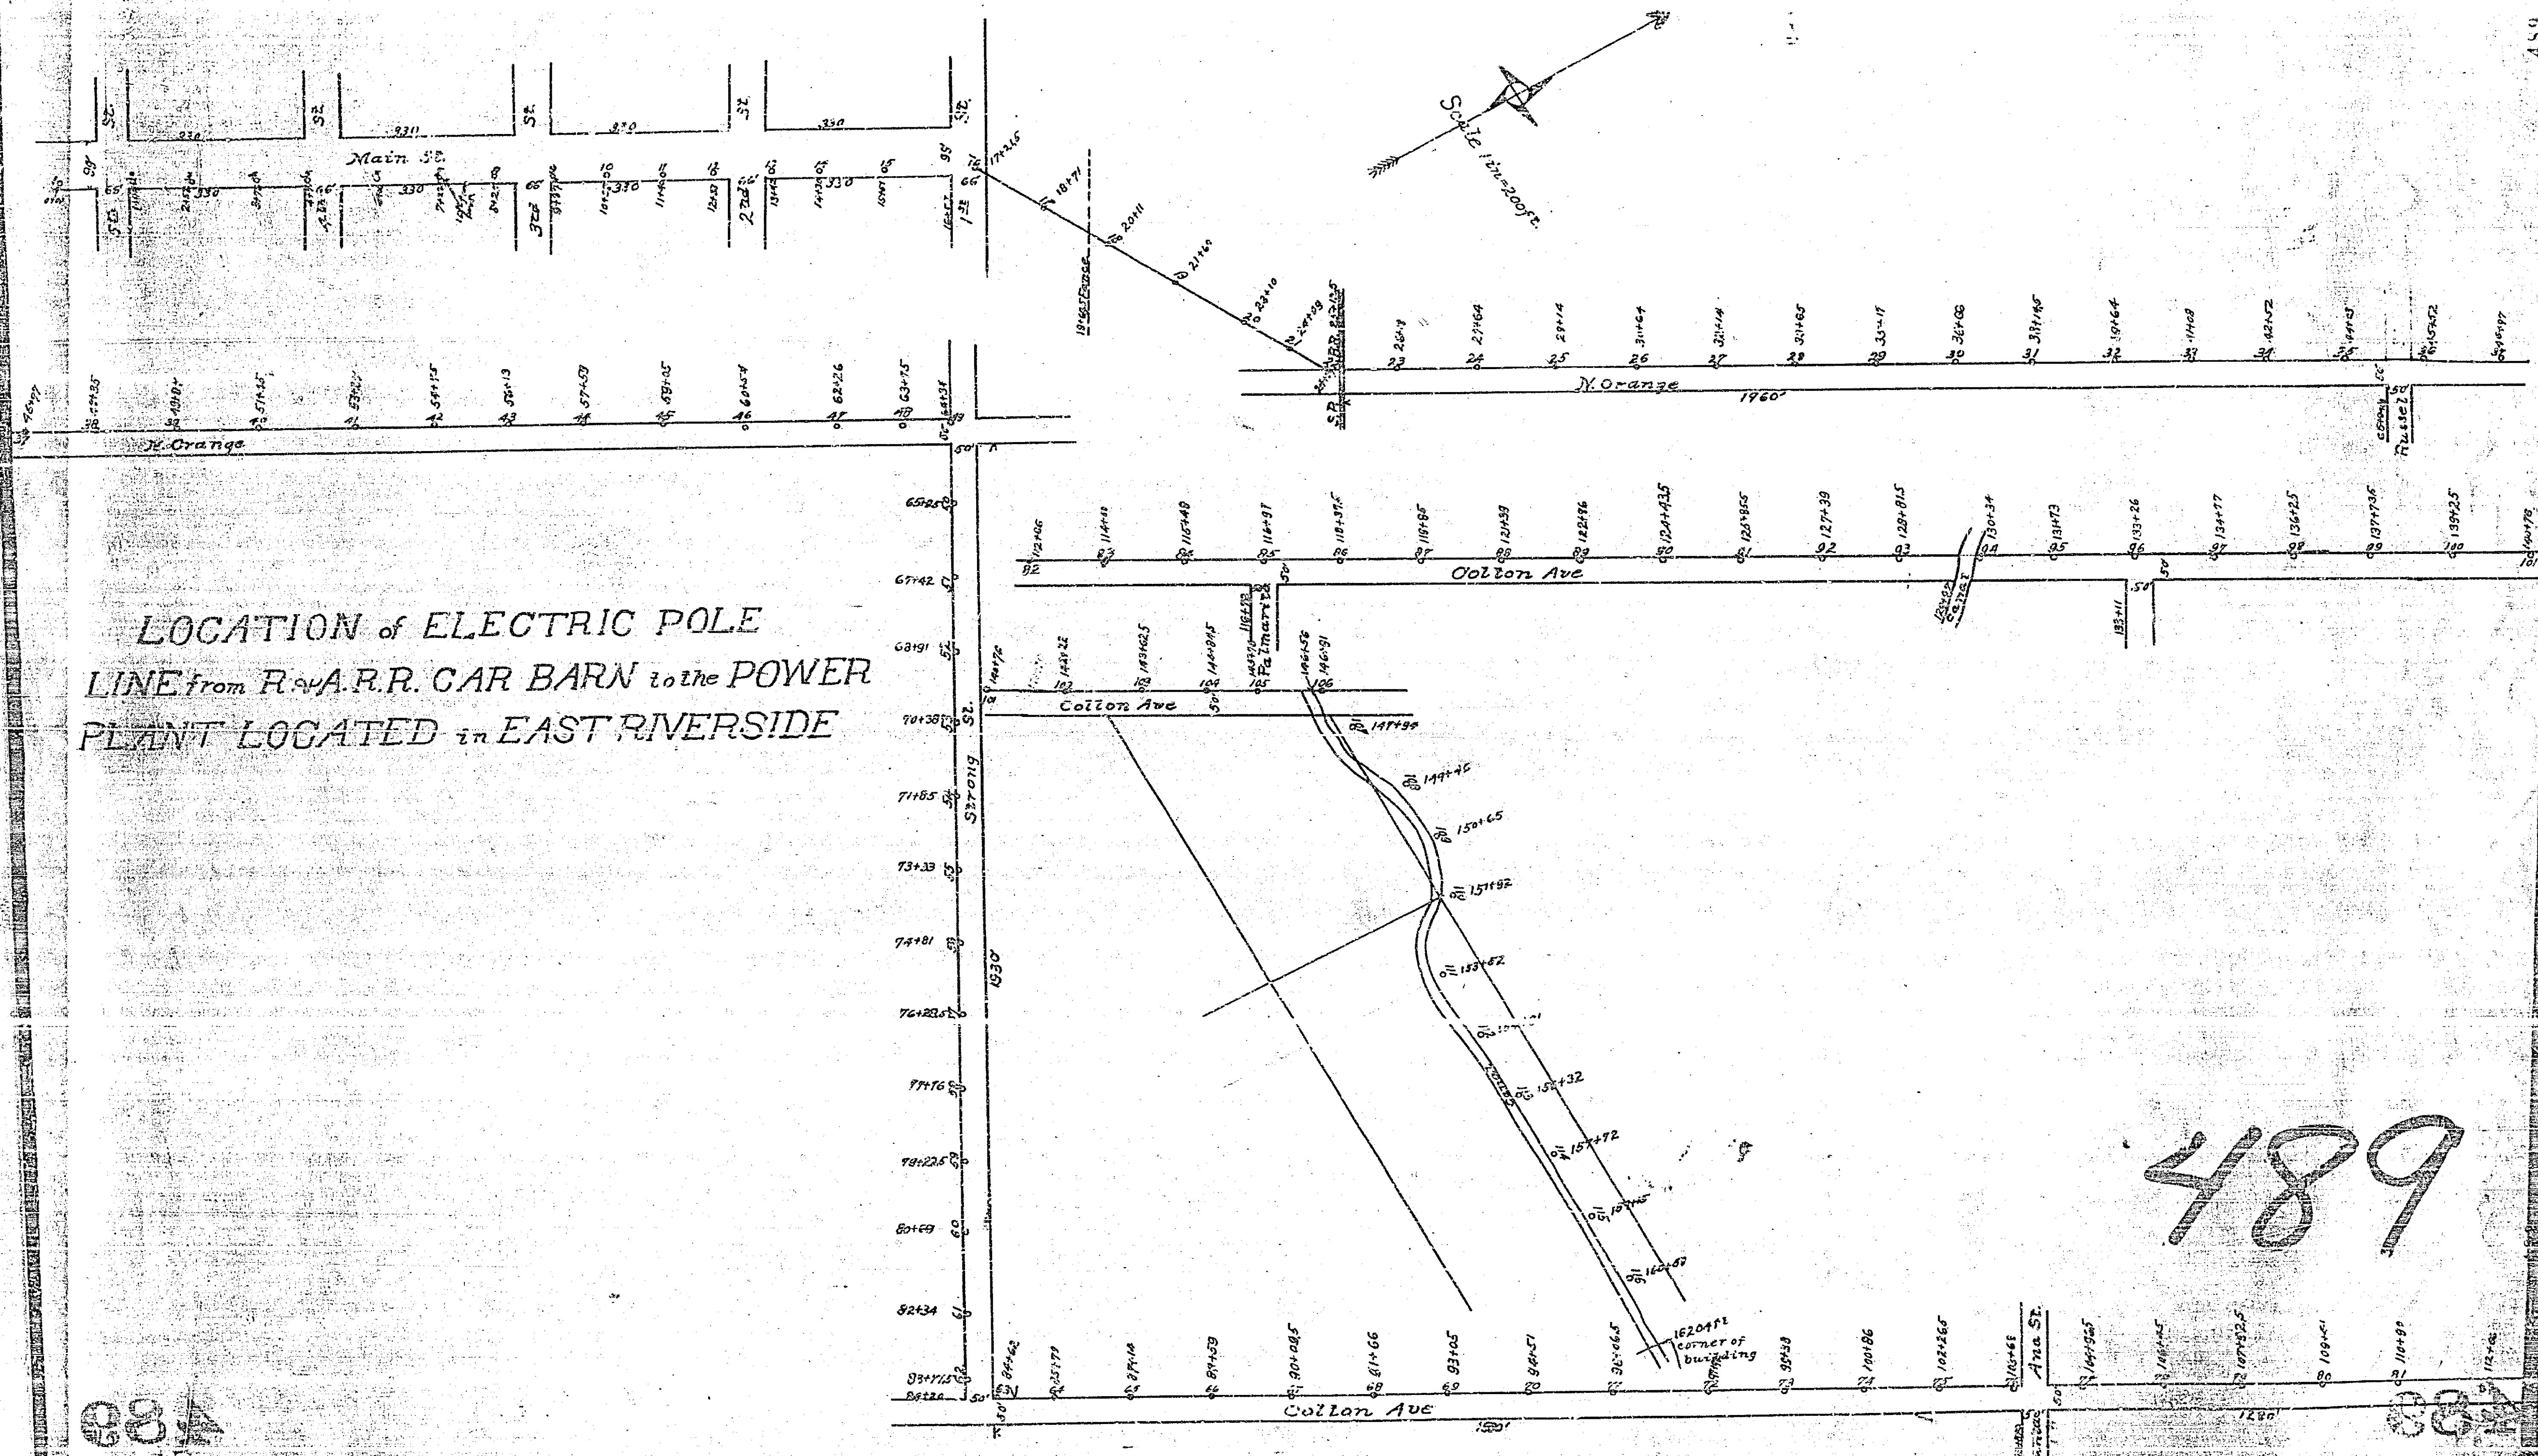

489

488

488