Note:
See Standard Manhole Head Casting Type "A" Drawing No 823 Approved by the Mayor and Common Council of the City of Riverside June 30, 1925.

Note
Cover to weigh not less than 180 lbs.
Frame - - - - - - 220 -

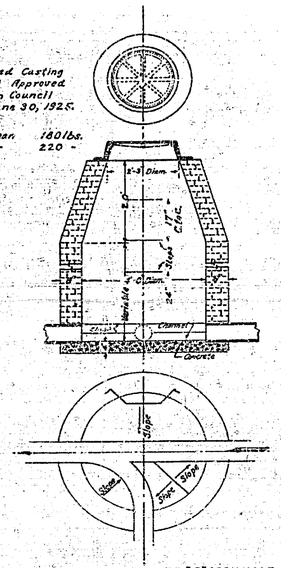

PLAN & SECTION OF TYPE "A" MANHOLE
Plan for Stations: 1+00.23 - 1+34.23 - 6+61.66
4100 - 8100 No Lateral Channel

PLAN AND PROFILE

OF THE PROPOSED SEWER ON

JURUPA AVENUE AND DEL-RAY COURT

ENGINEER DEPT. RIVERSIDE CALIF. 1936.

CITY (U.S.G.S.) DATUM PLANE

FIELD BOOK 311. PAGES 37 & 44

Constructed by Street Dept. 1936

APPROVED. _____
CITY ENGINEER.

APPROVED AND ADOPTED BY THE MAYOR AND COUNCIL OF THE CITY OF RIVERSIDE THIS 25TH DAY OF FEB. 1936.

_____
CITY CLERK. CITY OF RIVERSIDE.

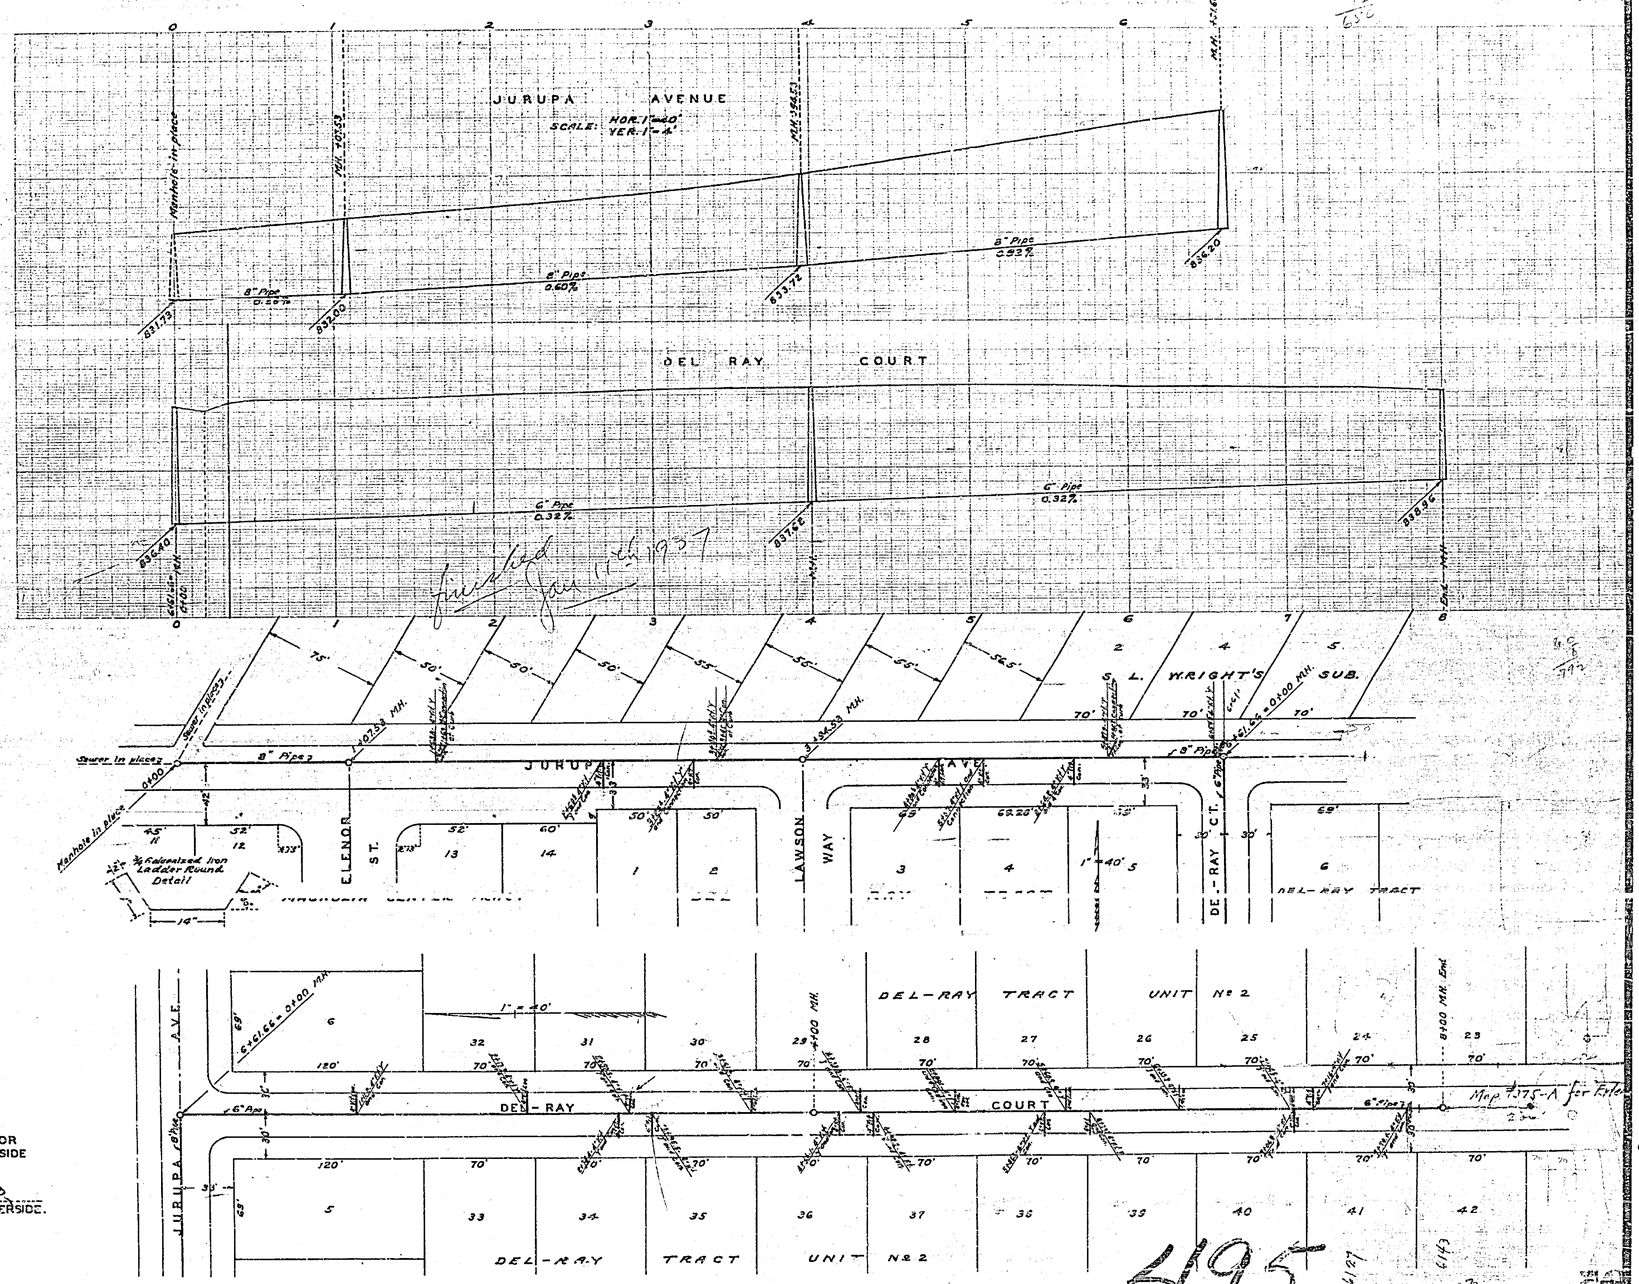

495