0 1 2 3

8" Sewer Lateral Layout

PLEASANT ST & COTTAGE ST



Scale 1" = 40'


FB. 379 p 272

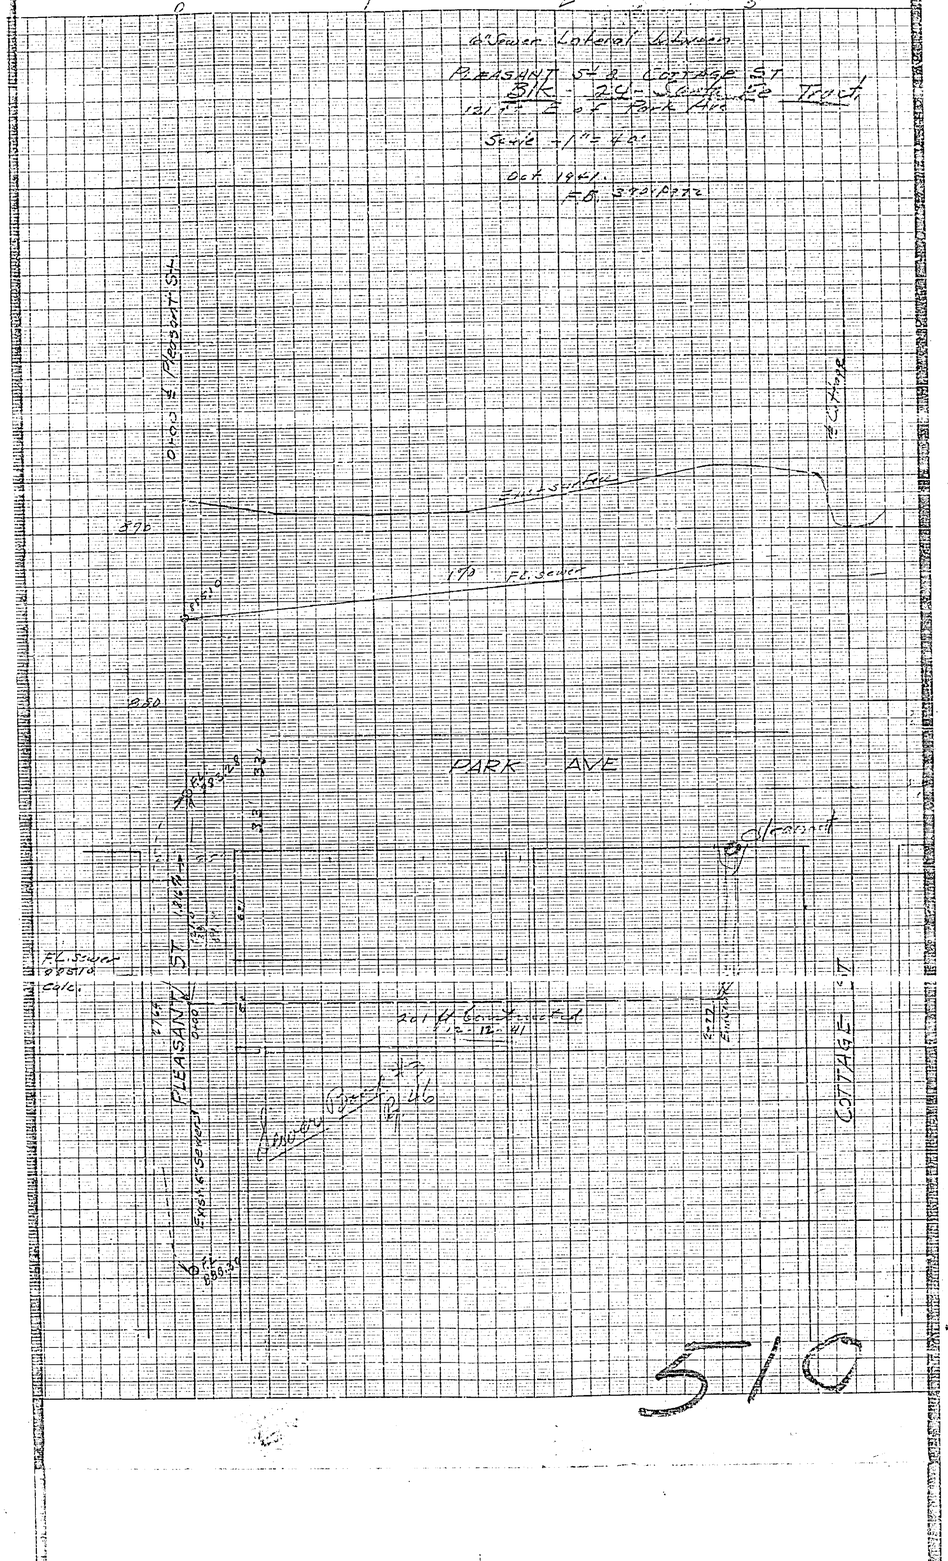

510