511-A	1	1	381,
DRAWN BY	CHECKED BY	APPROVED BY	
C.E.M. 1/27/42			

PROFILE

SCALE VER 1"=4'
HOR 1"=40'

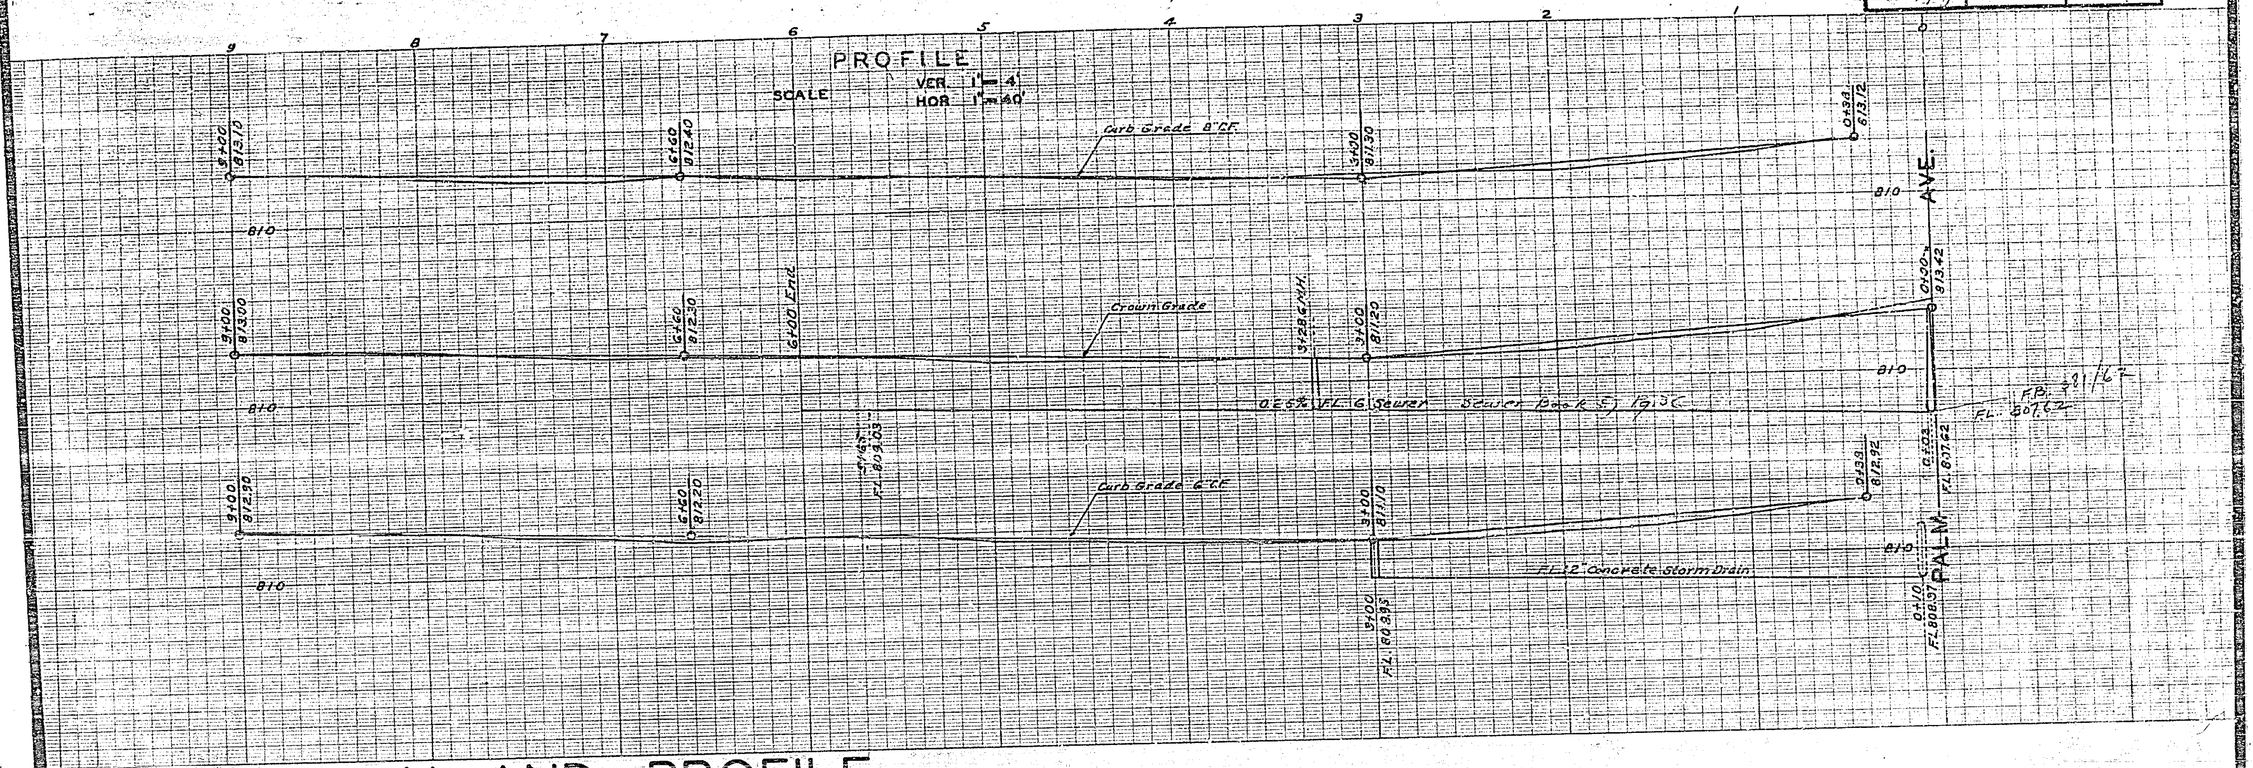

PLAN AND PROFILE

OF THE PROPOSED IMPROVEMENT ON

OAKWOOD PLACE

WESTERLY FROM PALM AVE.

ENGINEERING DEPT. RIVERSIDE. CALIF. 1941.

CITY (U.S.G.S.) DATUM PLANE

FIELD BOOK 381 PAGES 59-62

SCALE Hor. 1"=40'
Ver. 1"=4'

APPROVED CITY ENGINEER. REG. ENG. 1312.

Completed Dec. 1941
by A.C. Bussey

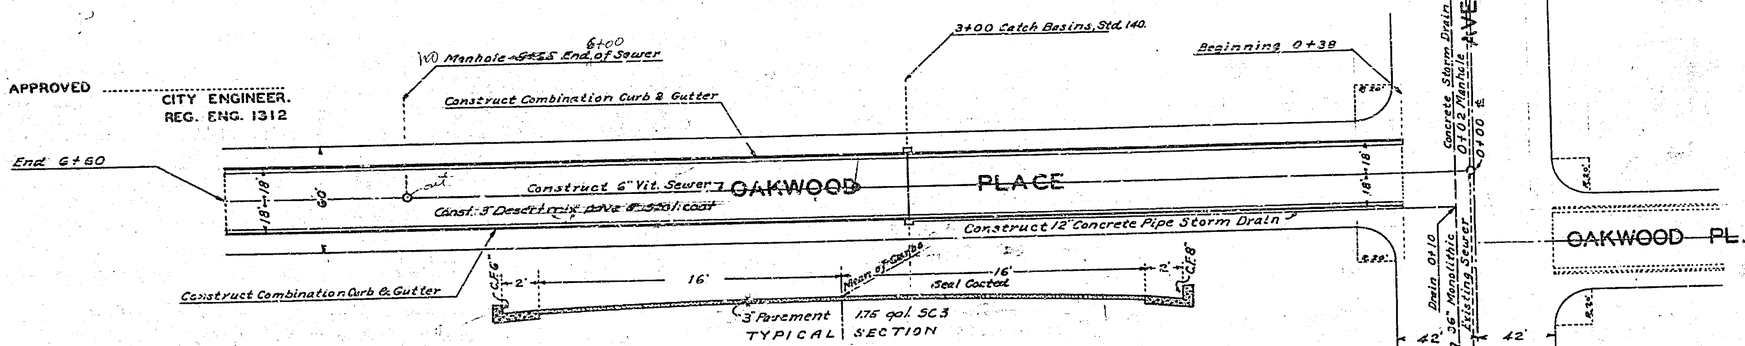

APPROVED AND ACCEPTED BY THE MAYOR AND COUNCIL OF THE CITY OF RIVERSIDE, THIS ... DAY OF ... 1941.

CITY CLERK, CITY OF RIVERSIDE.

511-A