



Alley BLK G, Rq 7

BK 3+4, Pg 68-70

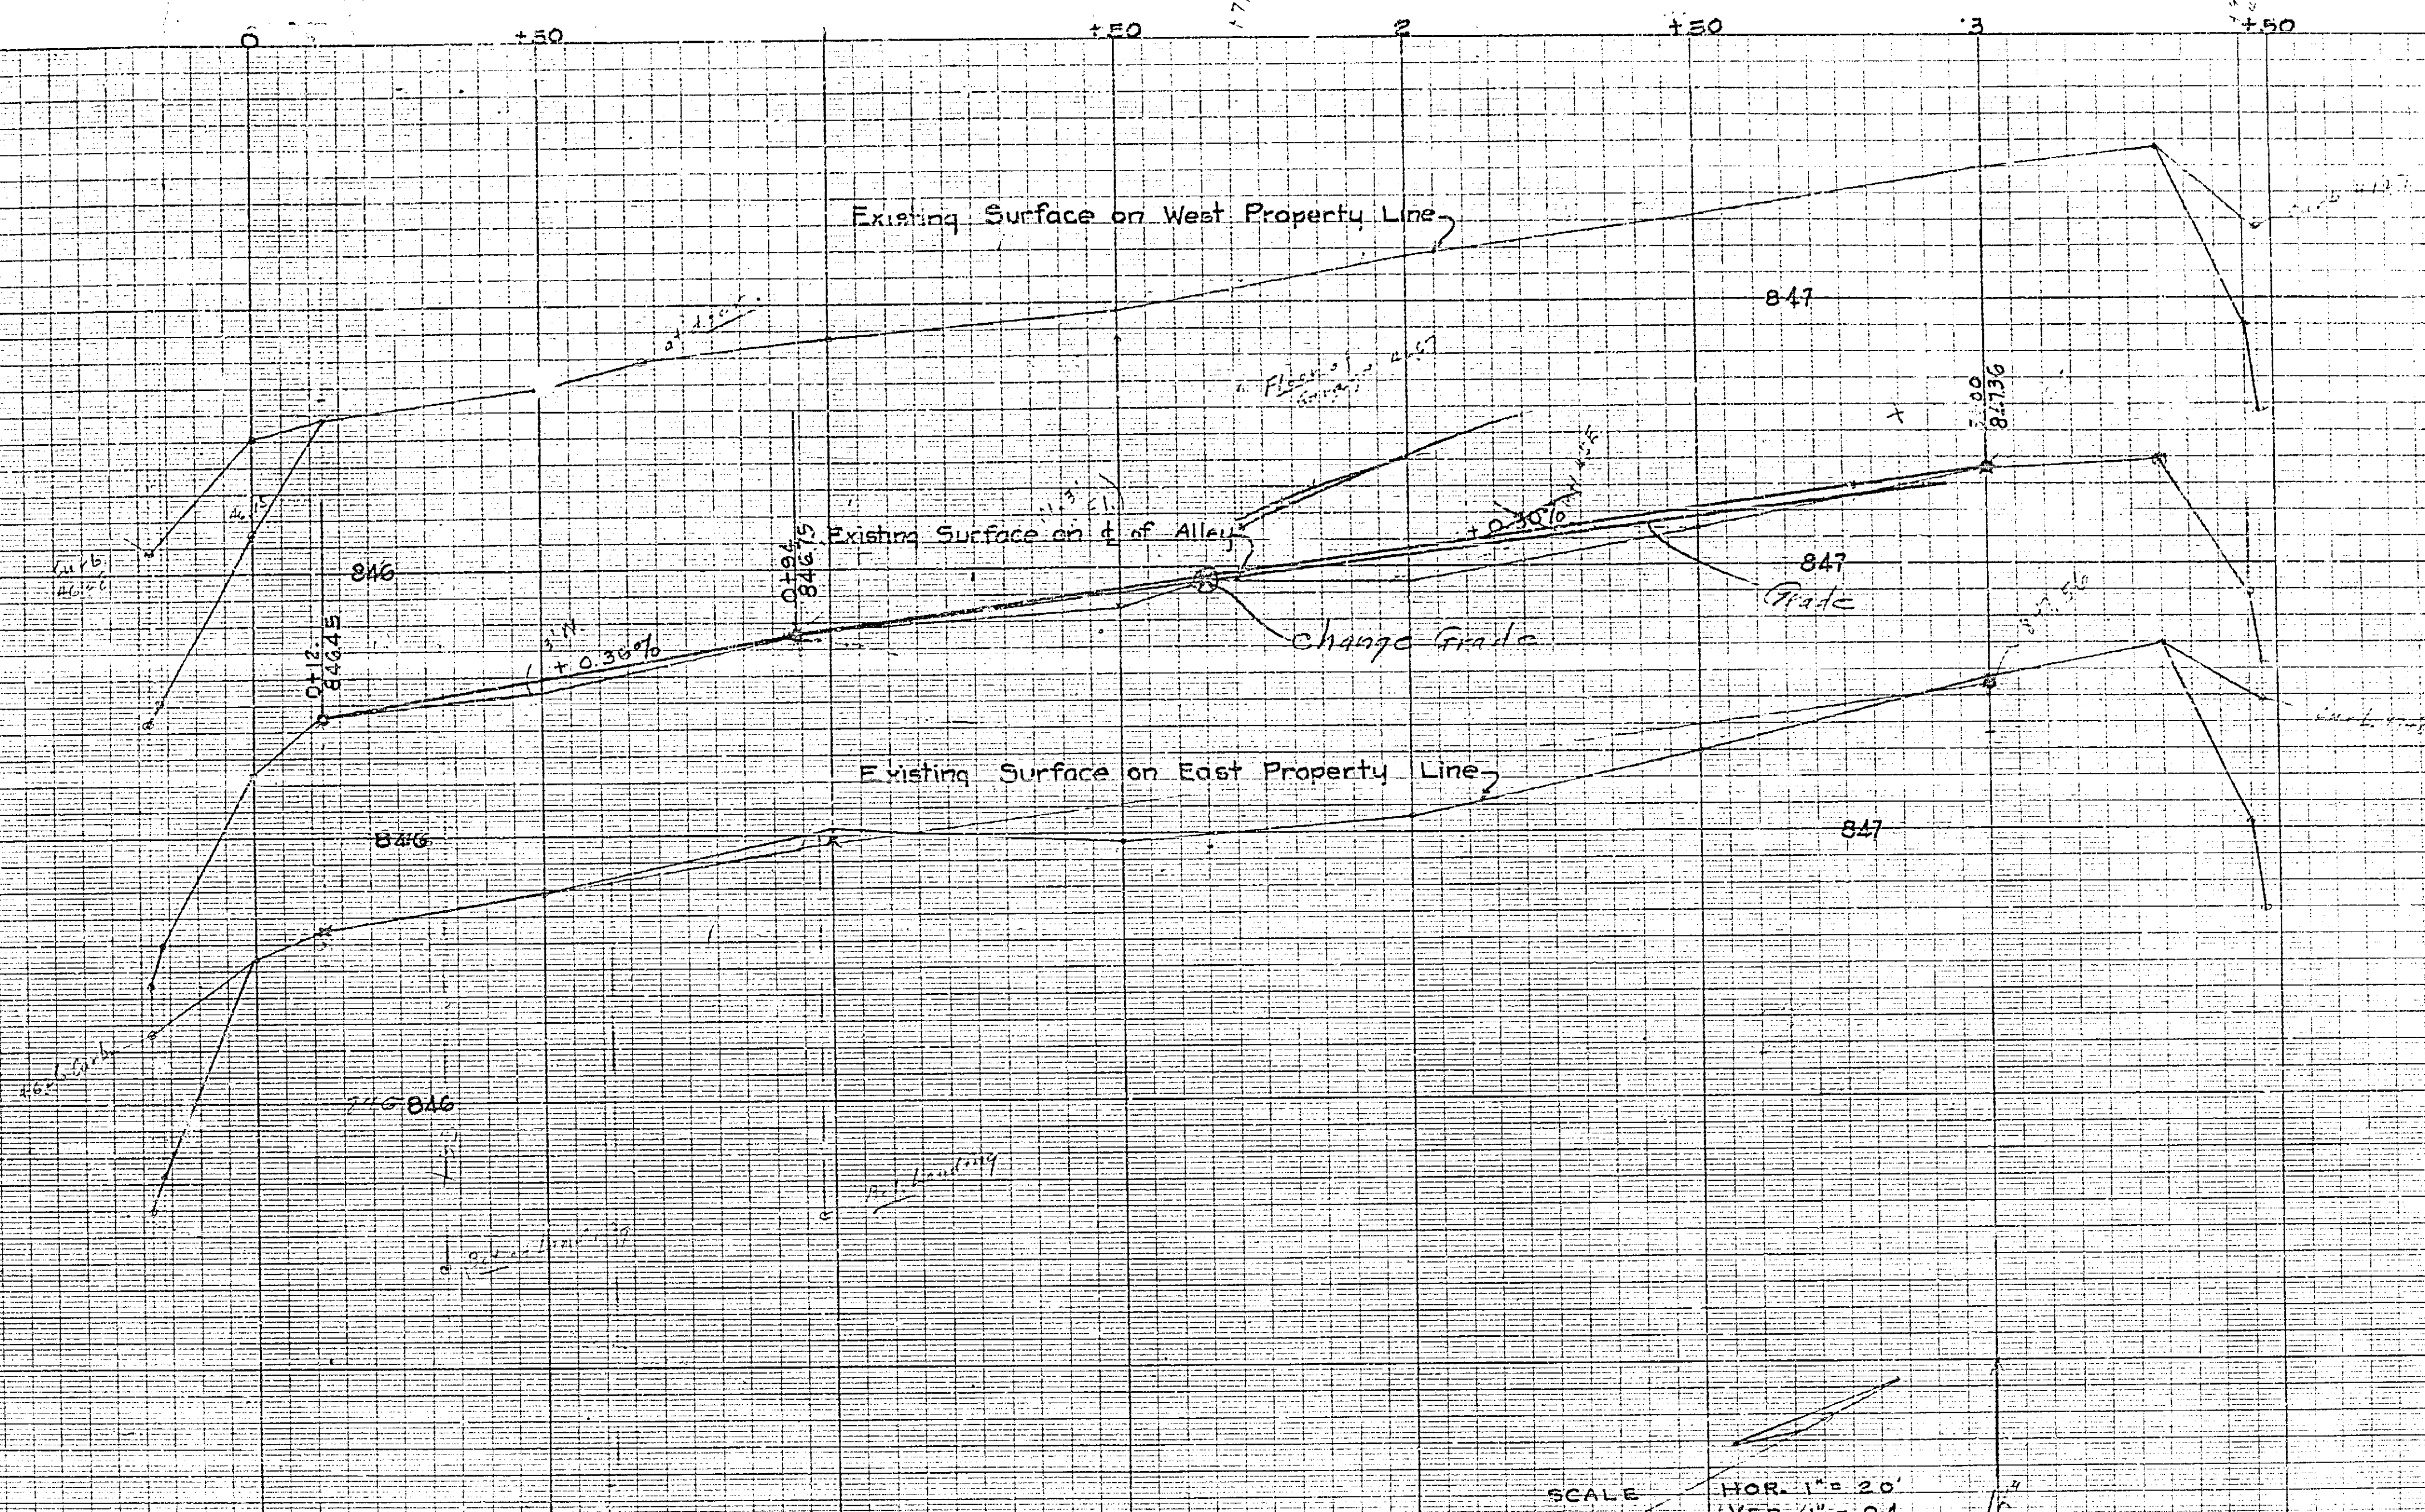

SCALE HOR. 1" = 20'  
 VER. 1" = 0.4'  
 Sept 25, 1927  
 Field Book 344 - pg 68-70

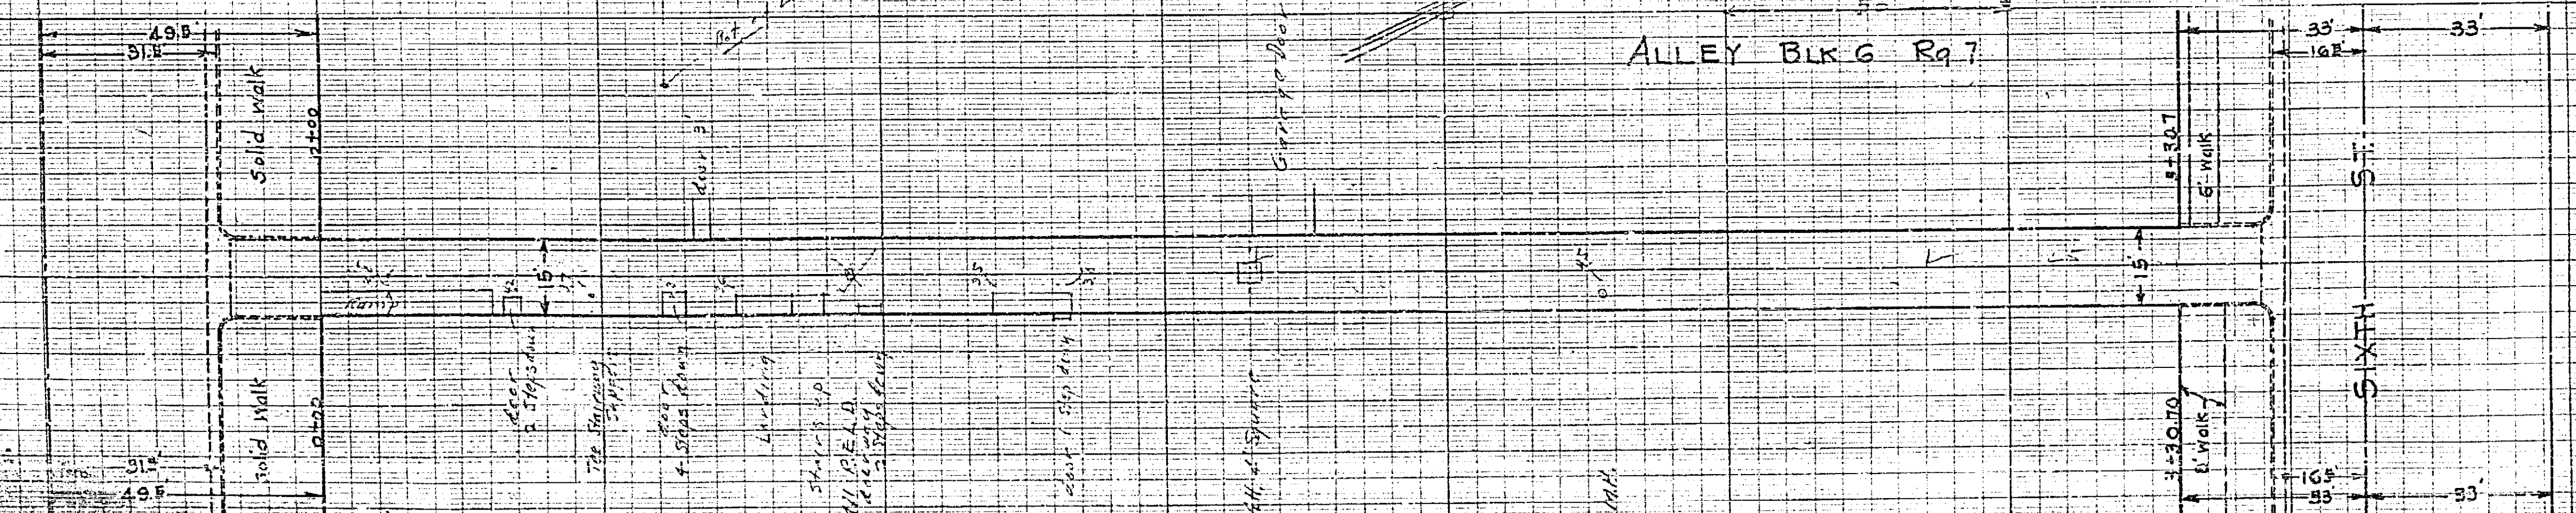

1/4" STANDARD  
 PROFILE PLATE A 4 X 20  
 MADE IN U.S.A.

WEUFFEL & ESSER CO.  
 NEW YORK

1/4" STANDARD  
 PROFILE PLATE A 4 X 20  
 MADE IN U.S.A.

516A