
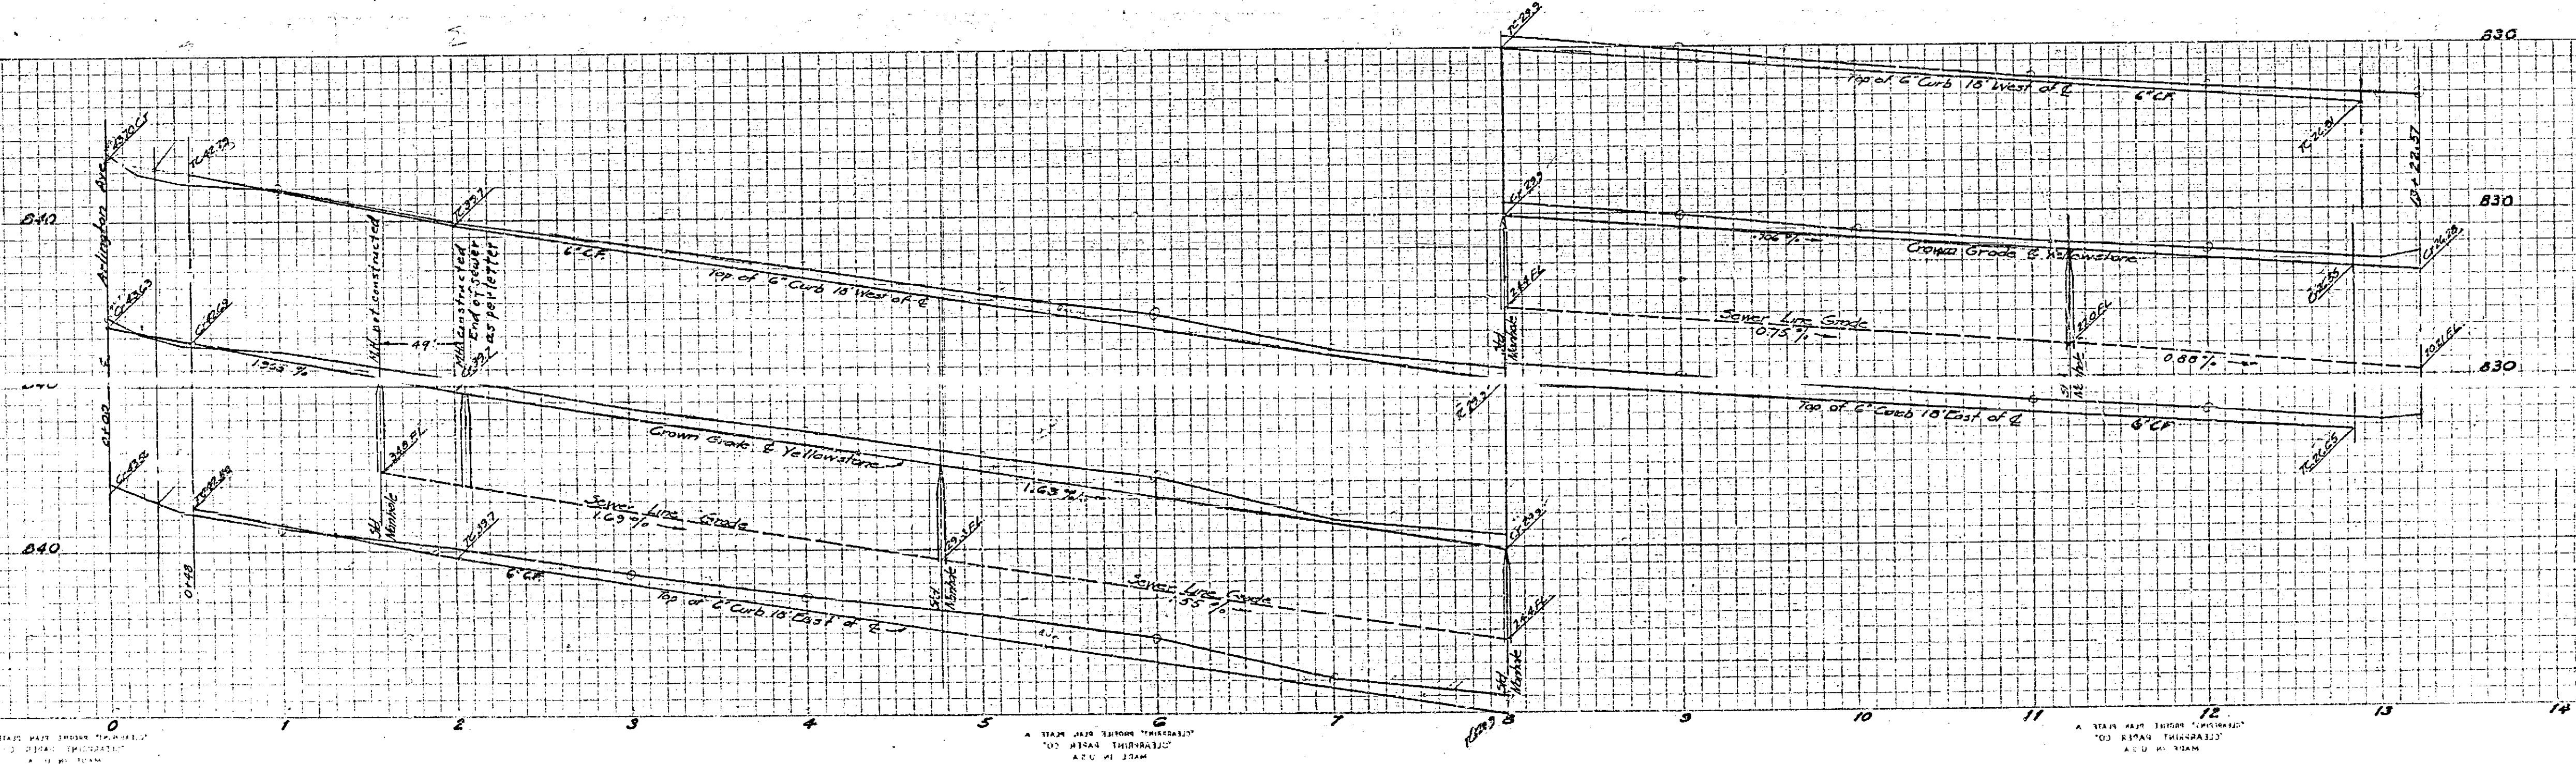


PROPERTY OF  
CITY OF RIVERSIDE  
CITY ENGINEERING DEPT.

Sheet 1 of 2 sheets

PROPERTY OF  
CITY OF RIVERSIDE  
CITY ENGINEERING DEPT.

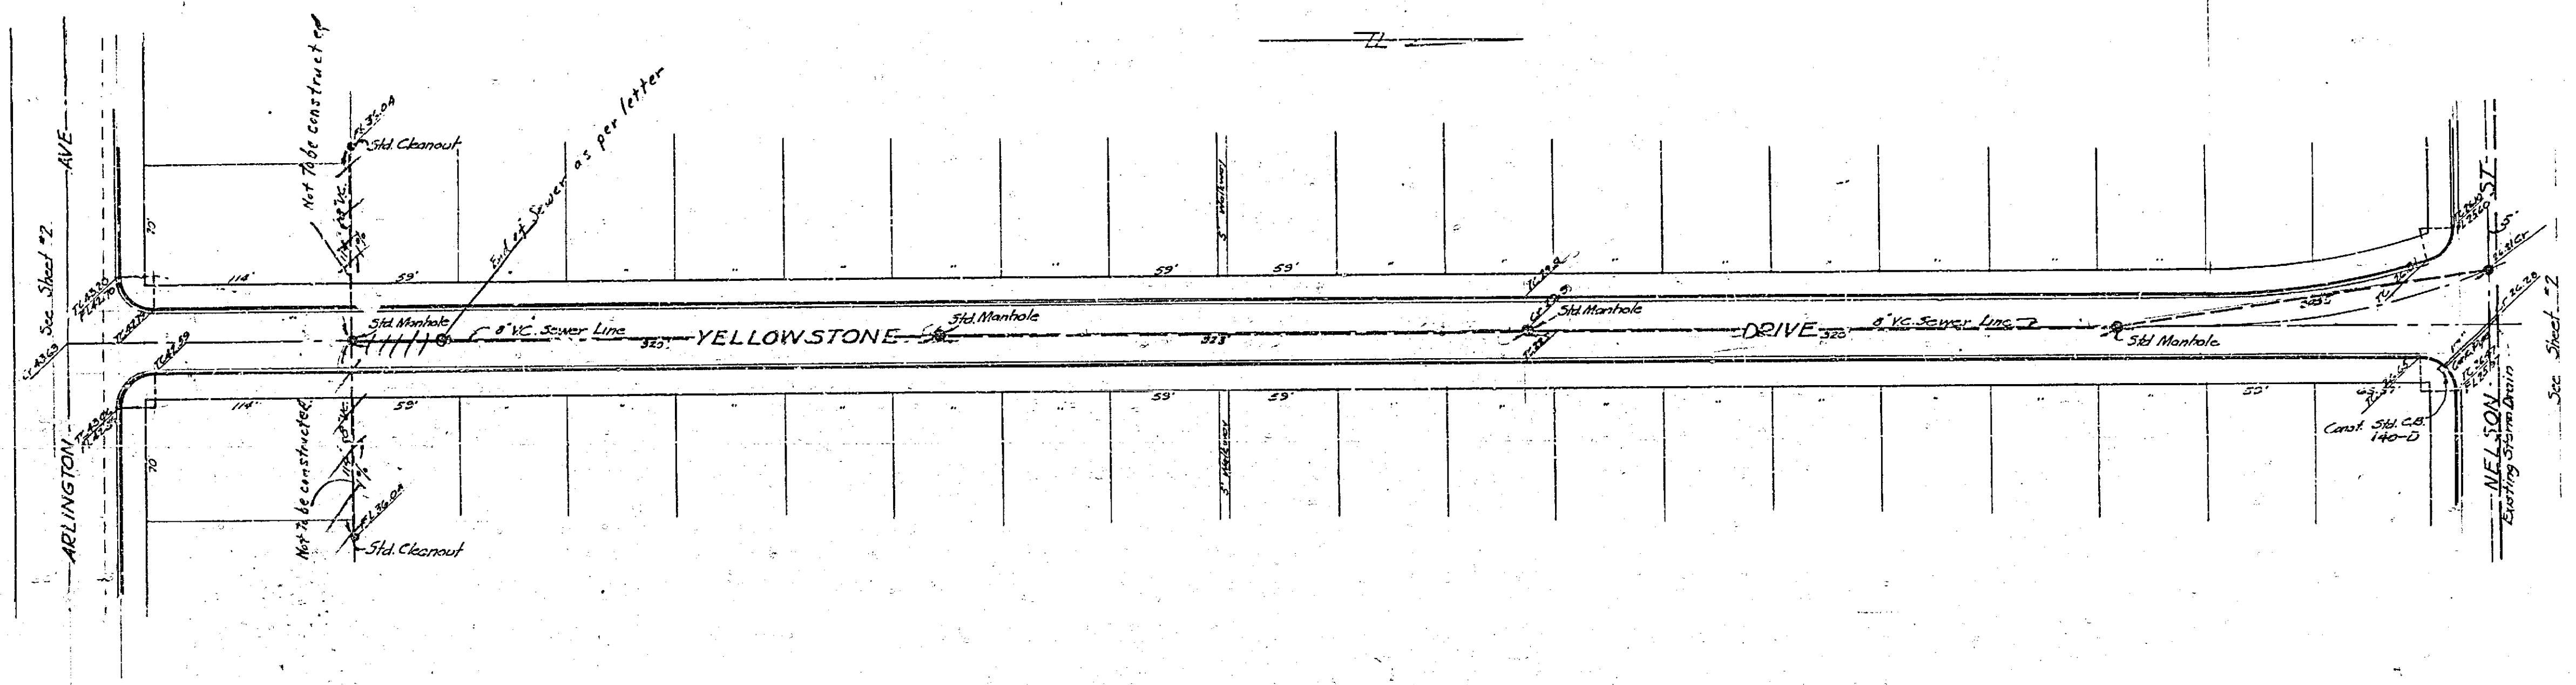

Approved *M.H. Swine*

No. 521  
 Plan & Profile  
 Victoria Village - YELLOWSTONE DR.  
 J.K. DAVIDSON, C.E. DEC. 1950

PROPERTY OF  
CITY OF RIVERSIDE  
CITY ENGINEERING DEPT.

Scale: Hor. 1" = 40'  
Vert. 1" = 4'

P.B. 414-24

521

PROPERTY OF  
CITY OF RIVERSIDE  
CITY ENGINEERING DEPT.