


527

527

MAP OF PROPOSED SEWER ON  
SOUTH LINE OF POLY TRACT

TERRACINA DRIVE  
R.P. Campbell,  
City Engineer.

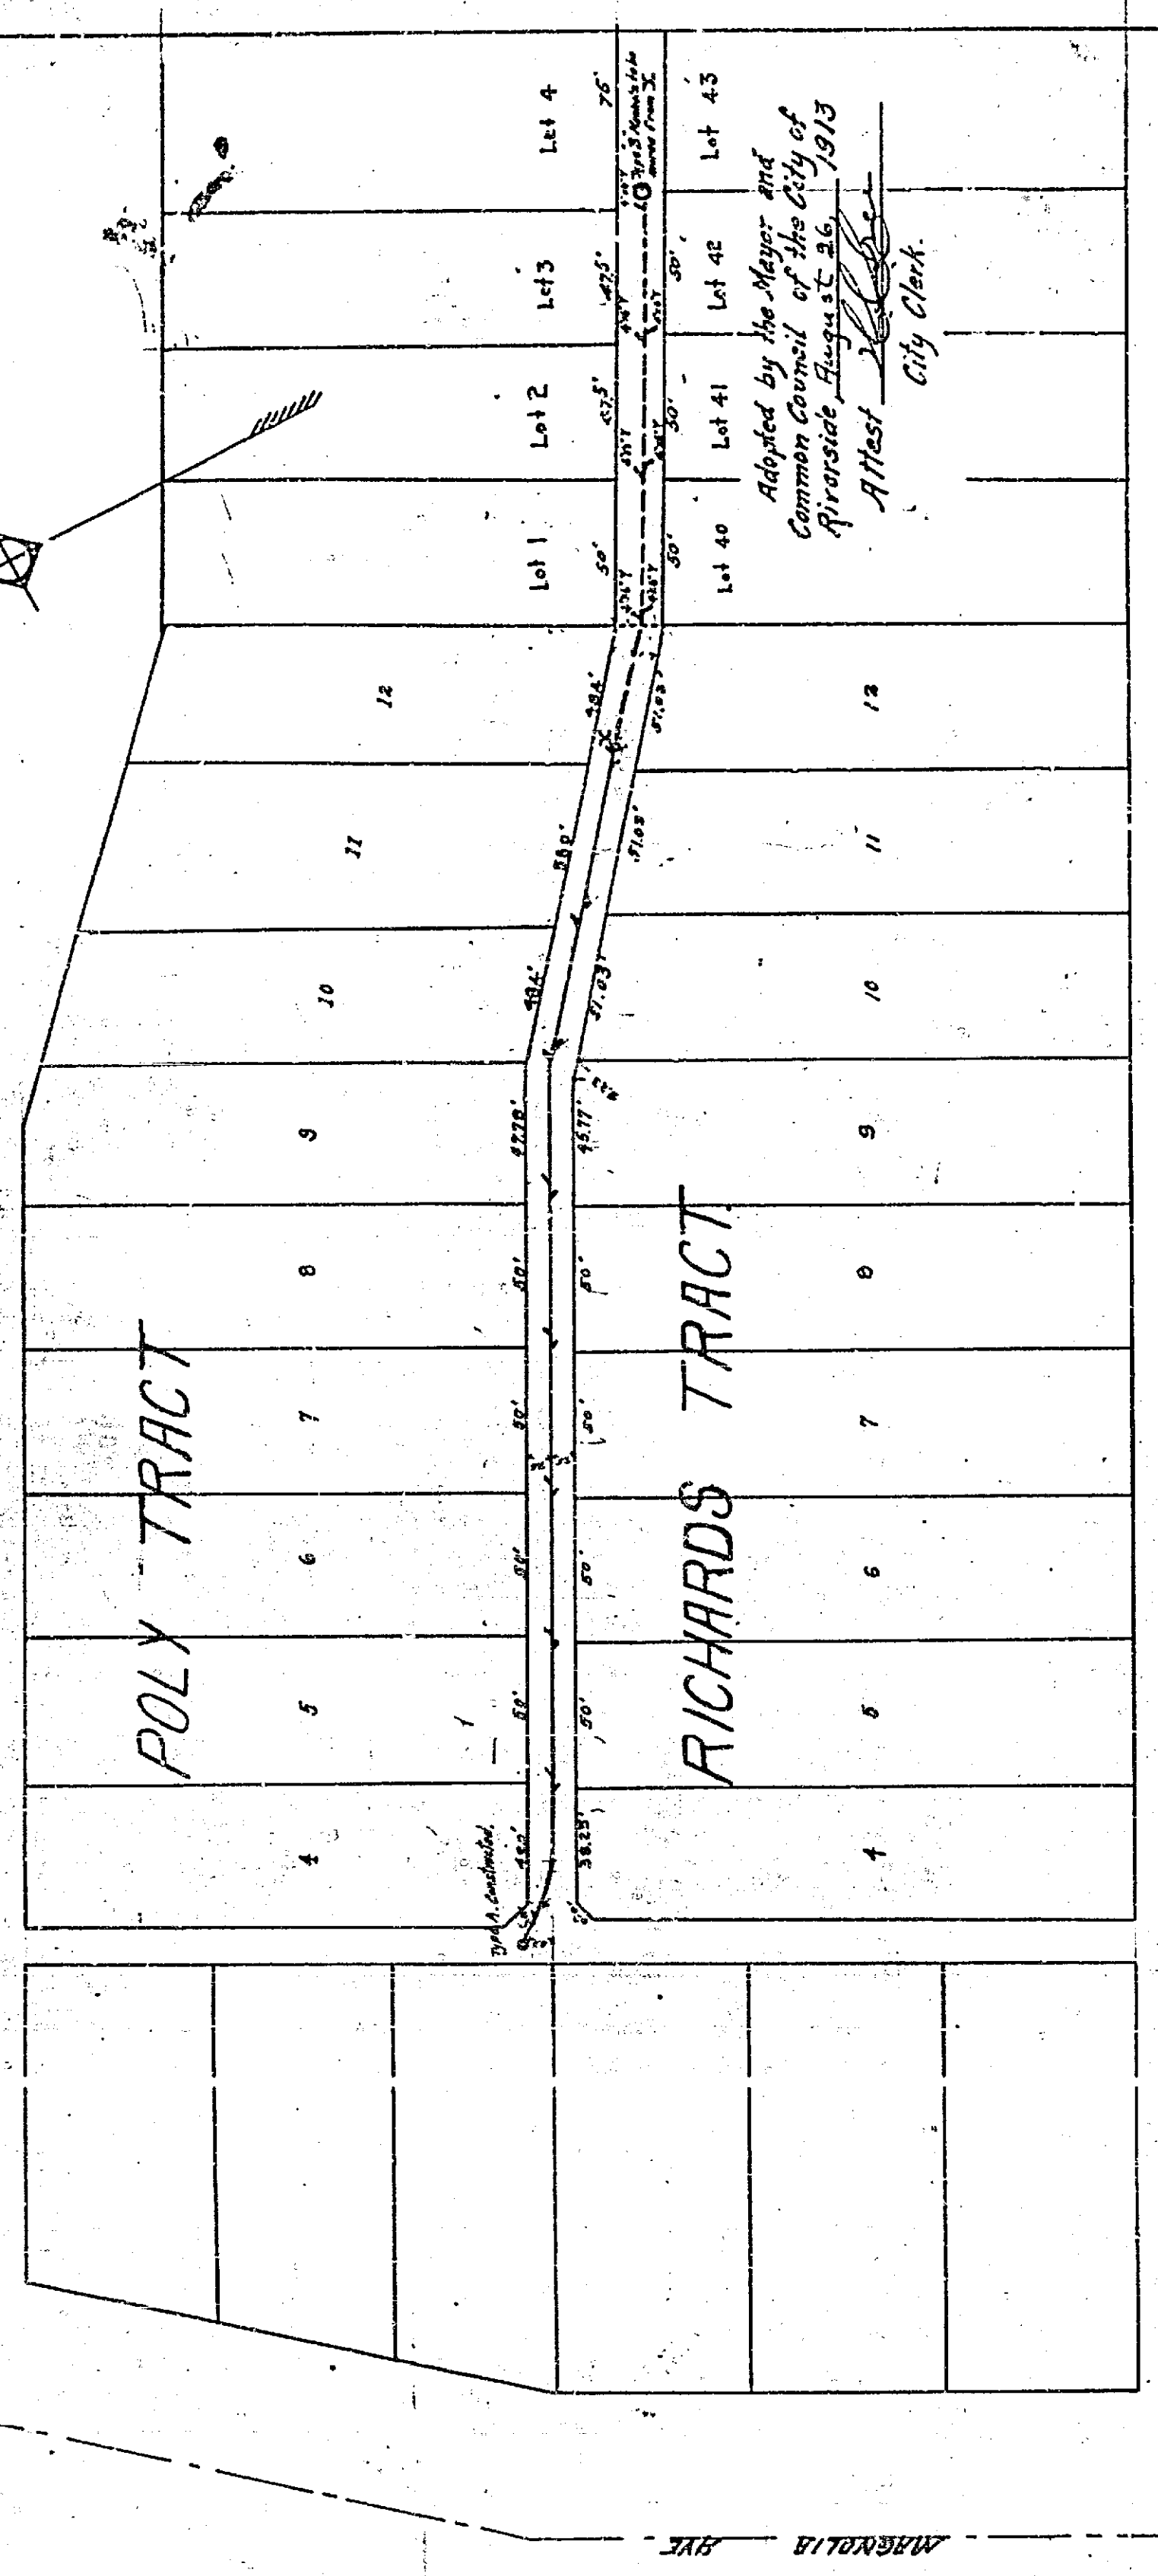

MARGOLIA AVE

FAREX AVE

Adopted by the Mayor and  
Common Council of the City of  
Attest  
City Clerk.

Scale of Map 1 inch = 50 ft.

Scale of Profile 1 inch = 100 feet  
1 inch = 10'


Field Notes in Book 14 Page 76

List of Materials

3777' 6" 12" Pipe  
1 740' 5" Manhole  
Length of sewer from No. 1 Manhole to # of  
Average cut 4.3'

527

527

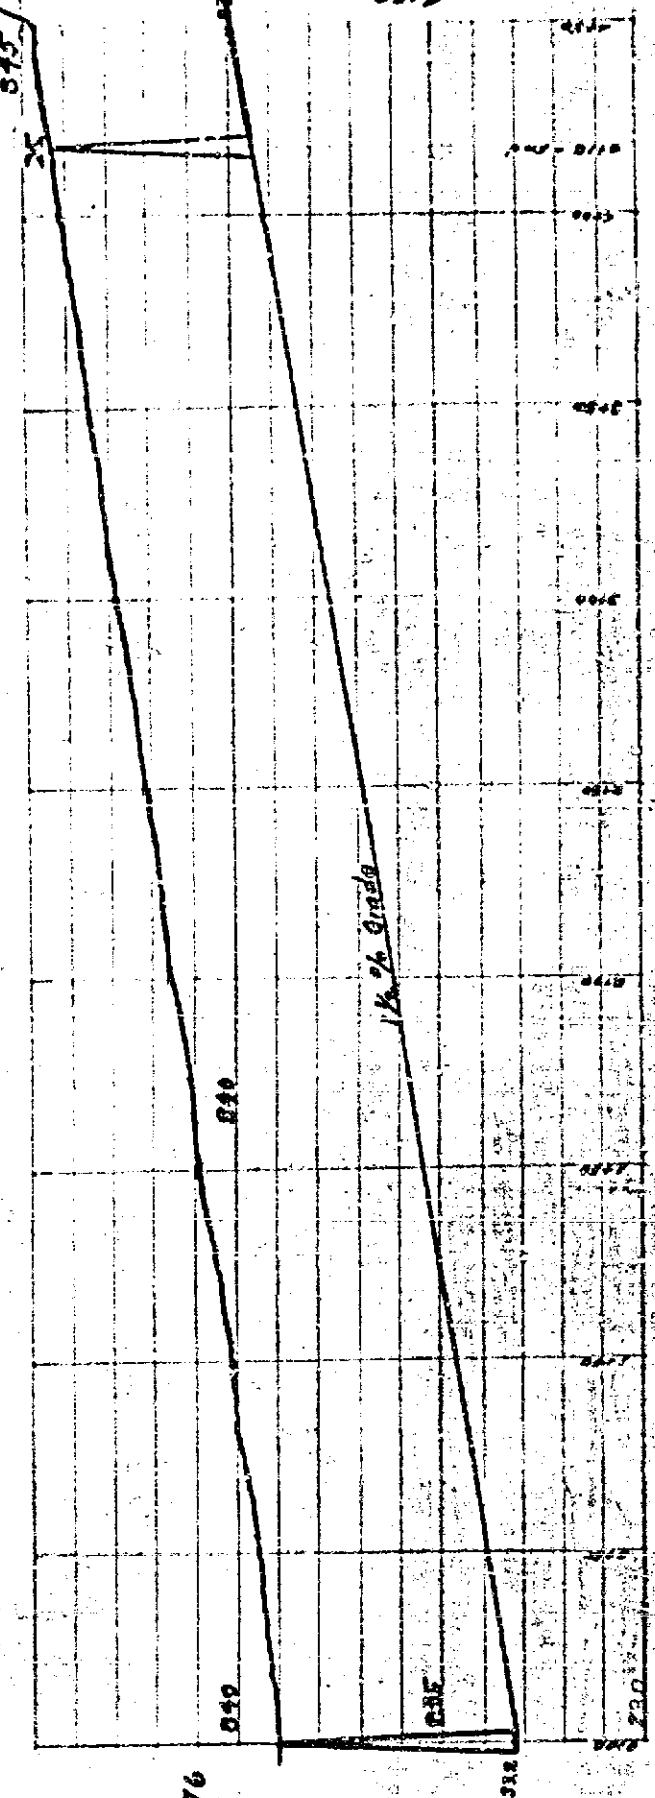

527