

FAIRFAX AVE.

TERRACINA DRIVE

PLANS AND PROFILES


OF THE PROPOSED IMPROVEMENT OF

ALLEY

POLY TRACT & RICHARDS TRACT
 ENG. DEPT. CITY OF RIVERSIDE 1934.
 CITY (U. S. G. S.) DATUM PLANE
 FIELD BOOK 274 PAGES 67-69

Constructed by Street Dept. 1935.

SCALE: HOR. 1" = 40'
 VER. 1" = 4'

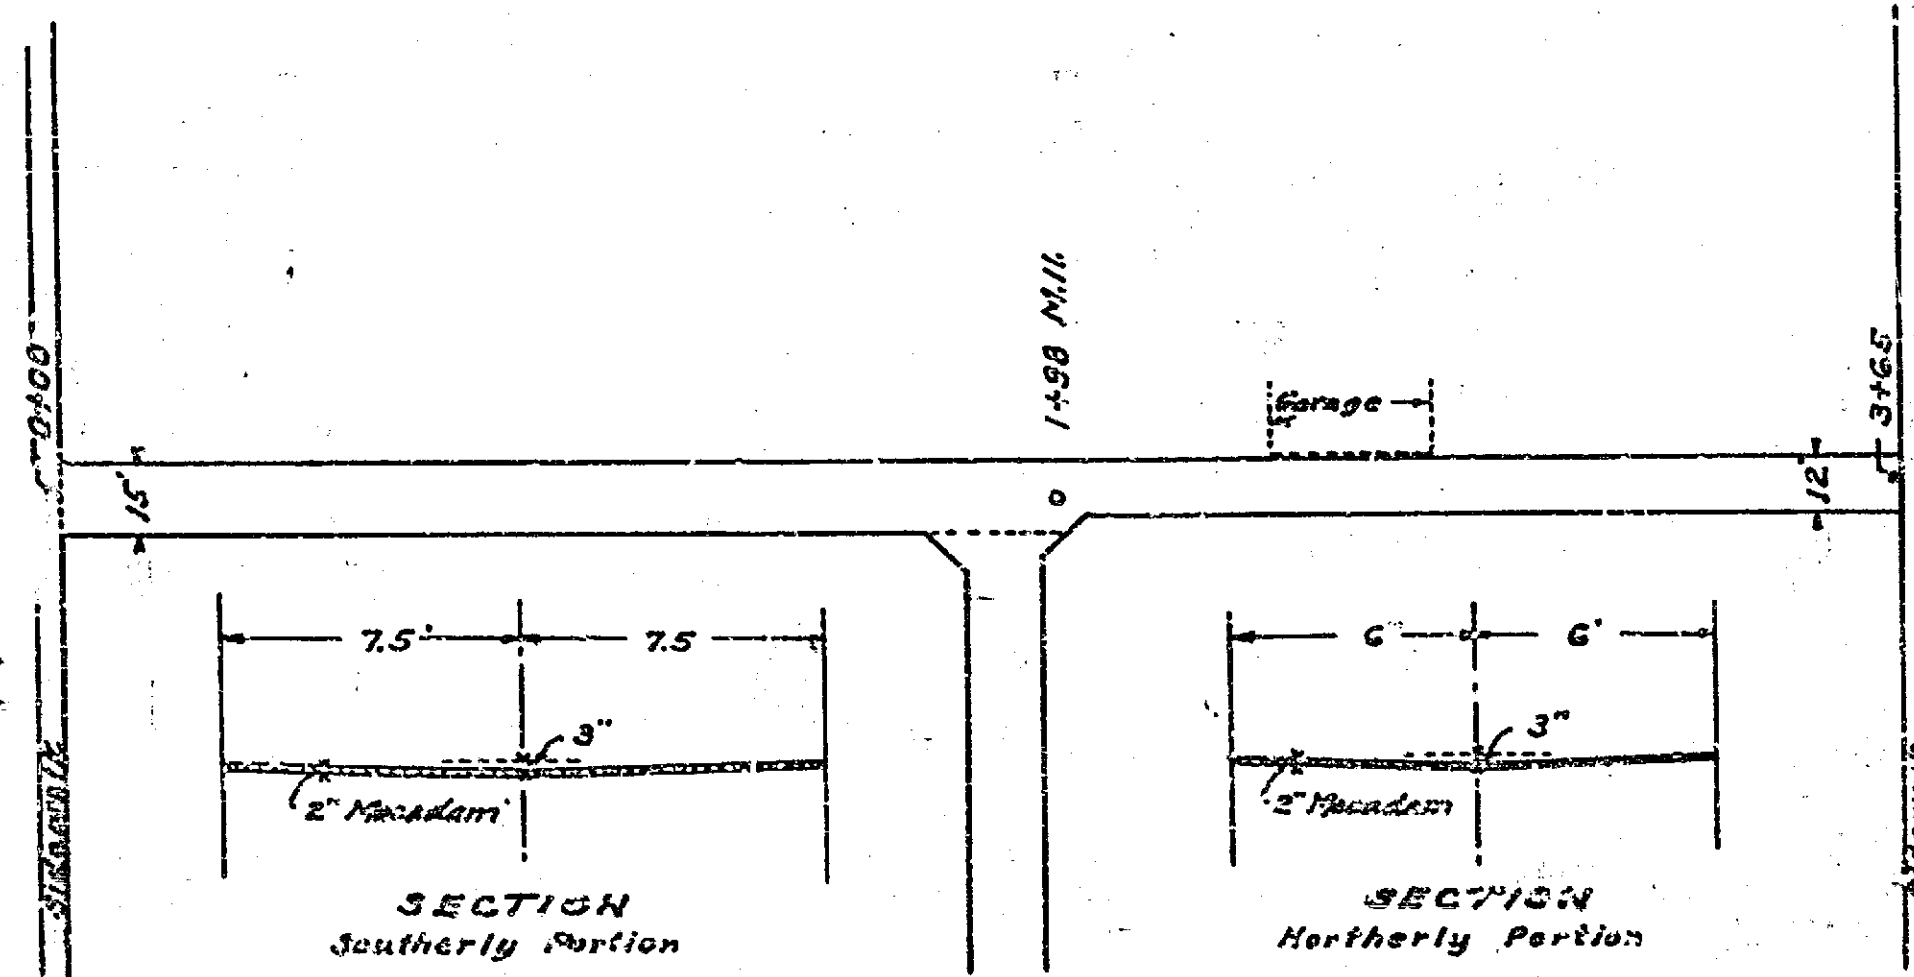

APPROVED AND ADOPTED BY THE MAYOR
 AND COUNCIL OF THE CITY OF RIVERSIDE
 THIS 15TH DAY OF JANUARY 1935

St. J. ...
 CITY CLERK, CITY OF RIVERSIDE.

527 A