


PLAN & PROFILE
HOWARD STREET

PLAN & PROFILE
Riverside City Right of Way
8th, Nogales St + Magnolia Ave
F.B. 248, page 30
Oct. 17, 1944

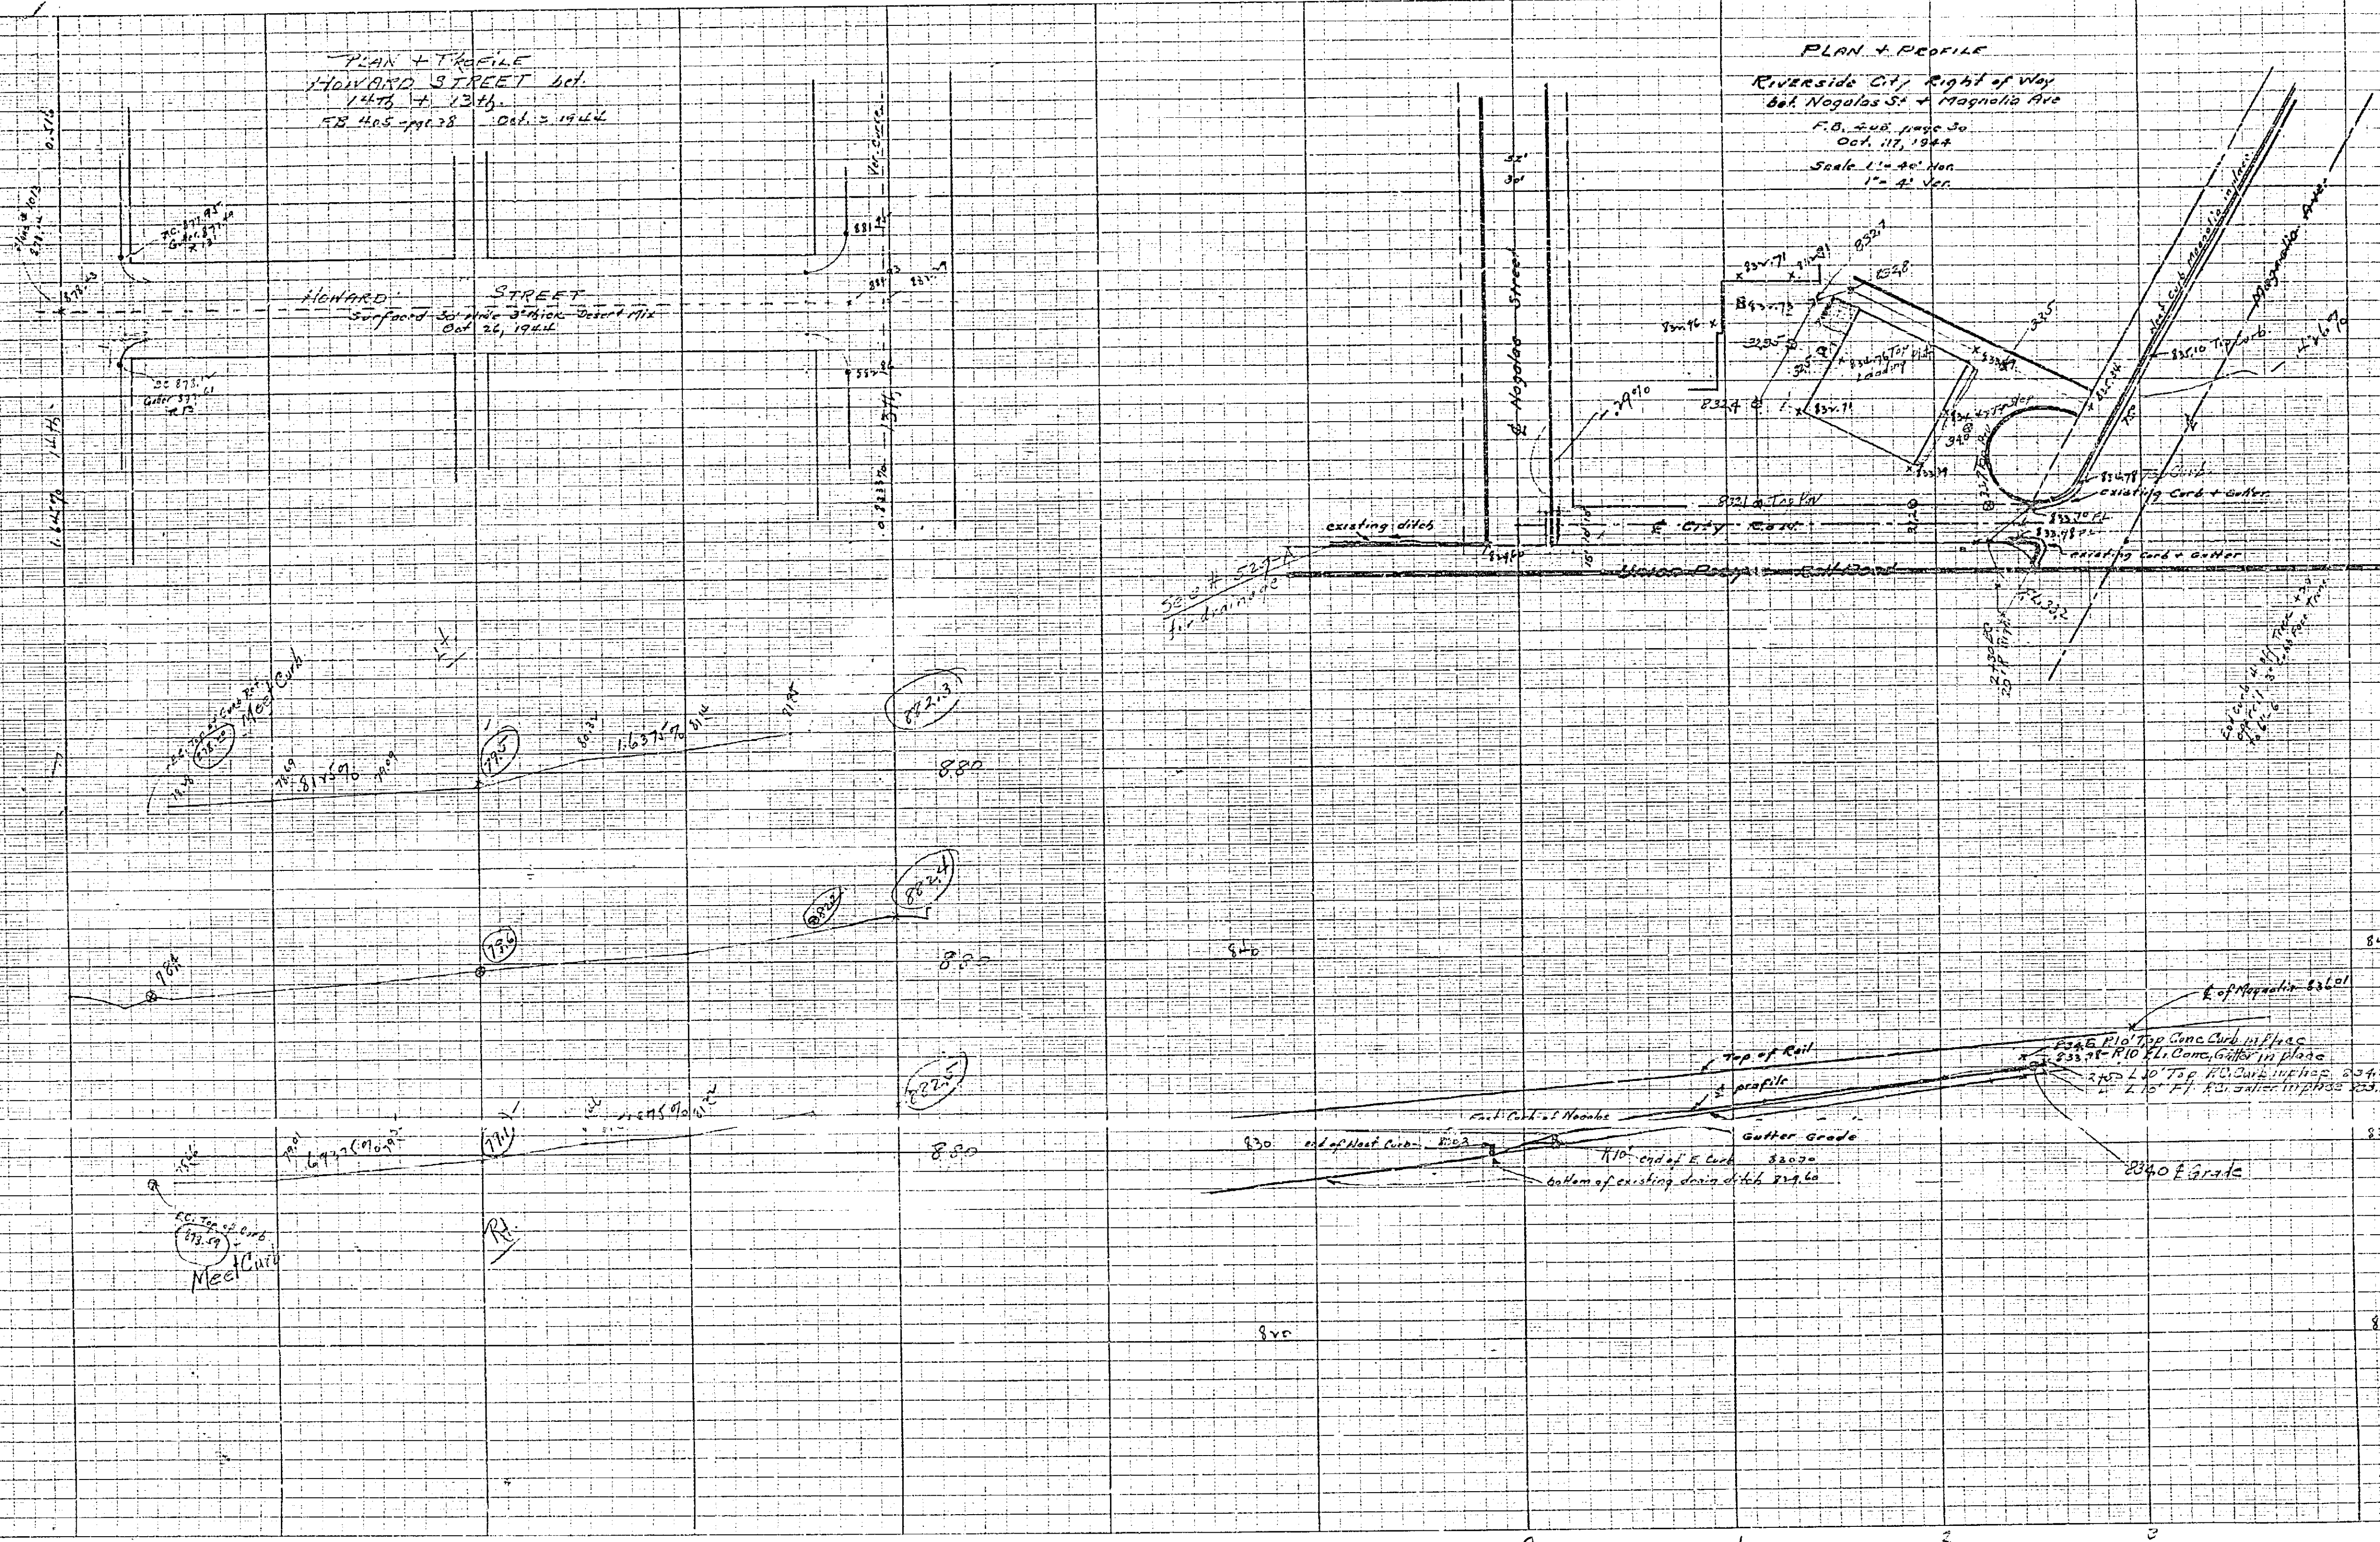

529